

WW-7
8-30-06



West Virginia Department of Environmental Protection
Office of Oil and Gas

WELL LOCATION FORM: GPS

API: 47-095-00559 WELL NO.: 5

FARM NAME: J.F. Ferrell

RESPONSIBLE PARTY NAME: Triad Hunter, LLC

COUNTY: Tyler DISTRICT: Ellsworth

QUADRANGLE: Porters Falls

SURFACE OWNER: James & Goldie Matthews Estate c/o Homer Matthews

ROYALTY OWNER: Unknown

UTM GPS NORTHING: 4374189.95231

UTM GPS EASTING: 511675.64083 GPS ELEVATION: 291.084(955')

The Responsible Party named above has chosen to submit GPS coordinates in lieu of preparing a new well location plat for a plugging permit or assigned API number on the above well. The Office of Oil and Gas will not accept GPS coordinates that do not meet the following requirements:

1. Datum: NAD 1983, Zone: 17 North, Coordinate Units: meters, Altitude: height above mean sea level (MSL) – meters.
2. Accuracy to Datum – 3.05 meters
3. Data Collection Method:

Survey grade GPS : Post Processed Differential _____
Real-Time Differential

Mapping Grade GPS _____ : Post Processed Differential _____
Real-Time Differential _____

4. **Letter size copy of the topography map showing the well location.**


I the undersigned, hereby certify this data is correct to the best of my knowledge and belief and shows all the information required by law and the regulations issued and prescribed by the Office of Oil and Gas.

Pam Smith
Signature

Geologist
Title

RECEIVED
Office of Oil and Gas
1/14/2016 FEB 20 2016


West Virginia Department of Environmental Protection
03/18/2016

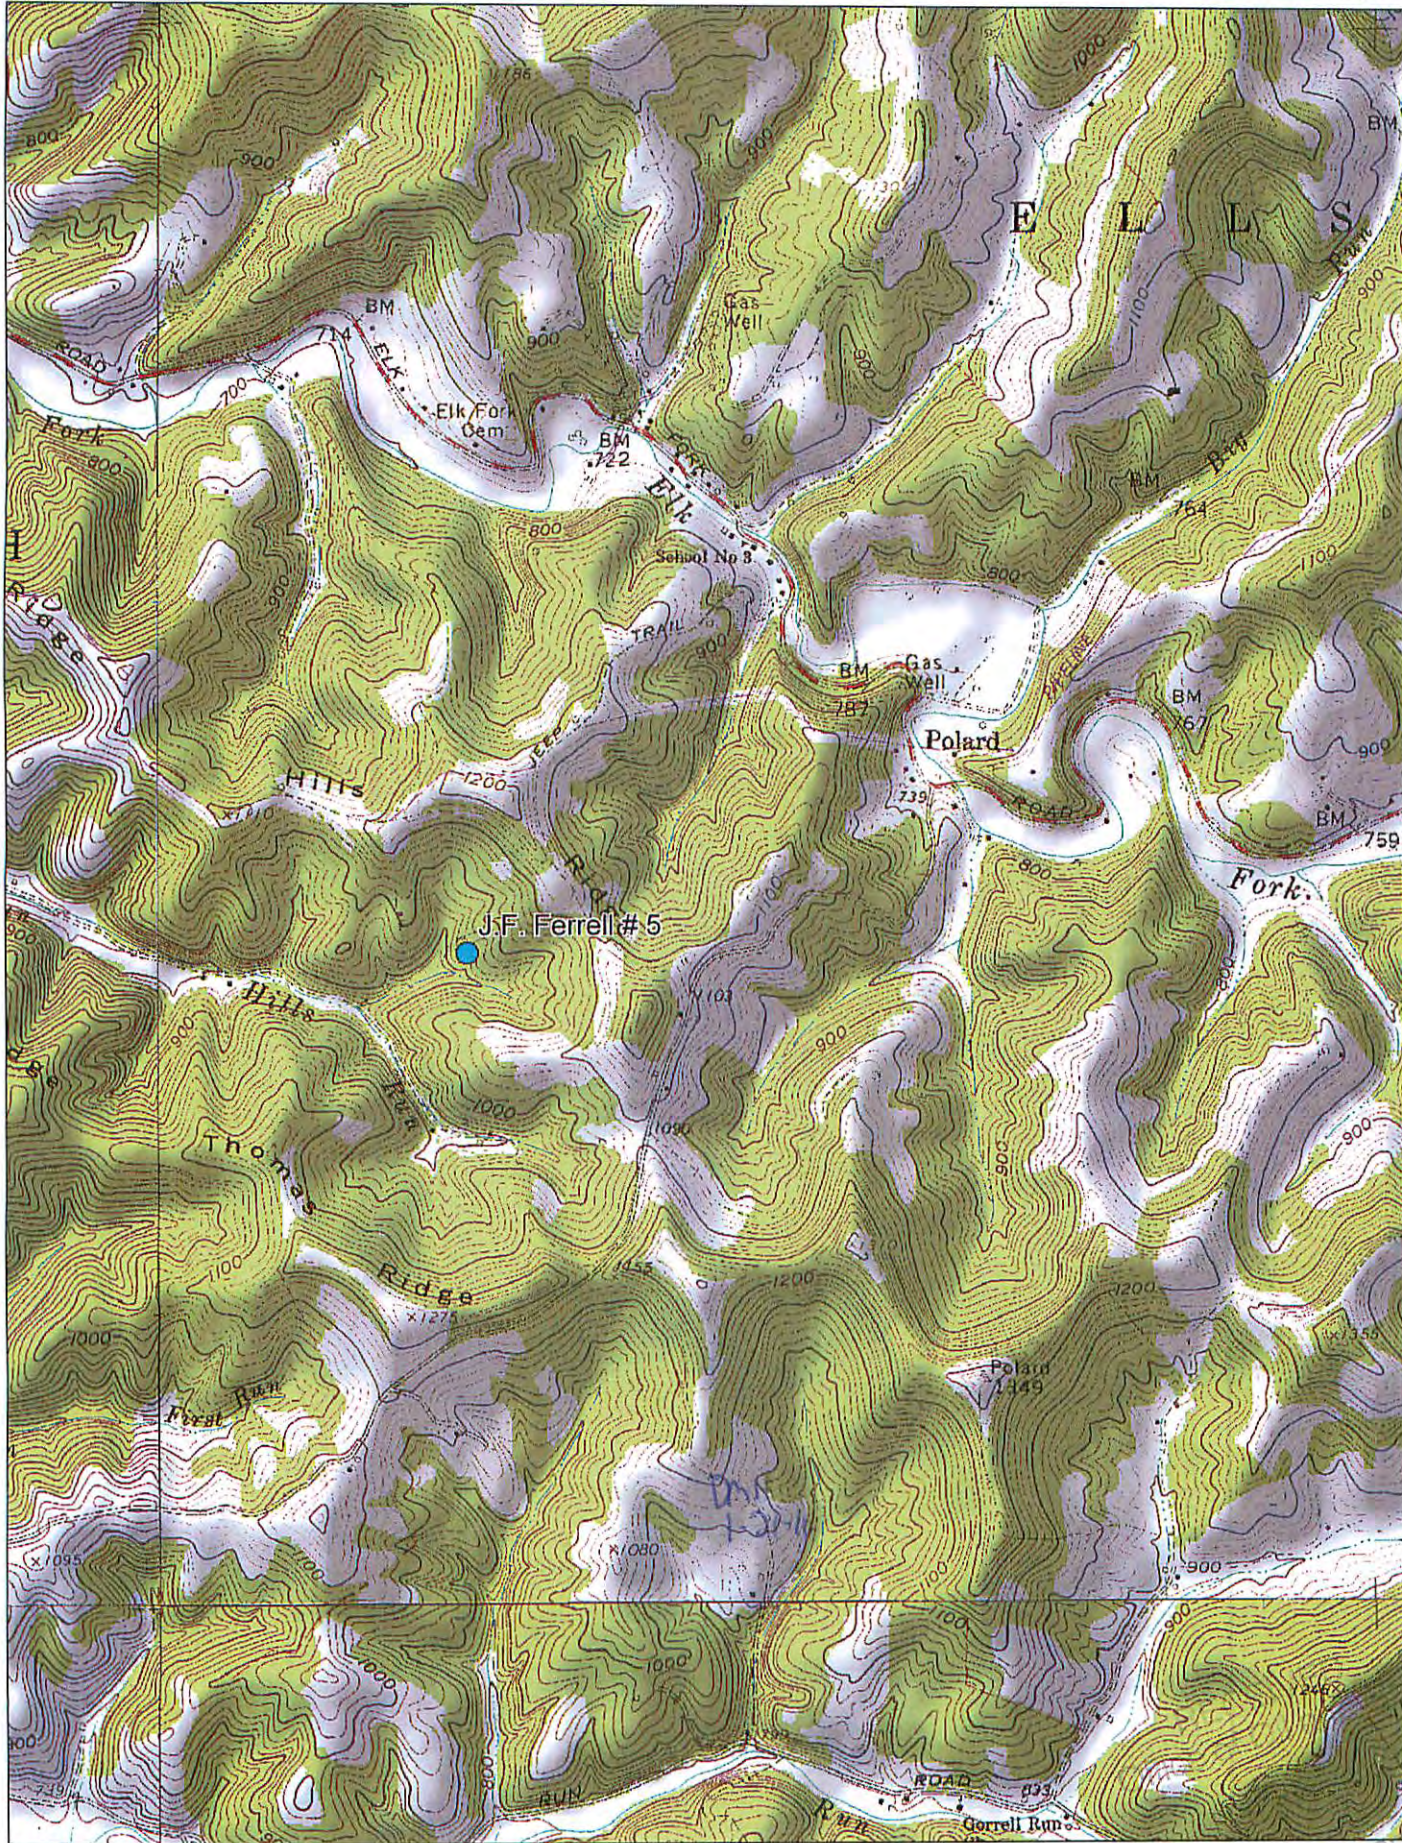

Data use subject to license.

© DeLorme. XMap® 7.

www.delorme.com

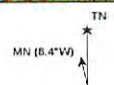

Scale 1 : 22,400

1" = 1,866.7 ft

03/18/2016

Environmental Protection