

WW-7  
8-30-06



West Virginia Department of Environmental Protection  
Office of Oil and Gas  
**WELL LOCATION FORM: GPS**

API: 47-095-00576 WELL NO.: 4

FARM NAME: GORRELL, W. W.

RESPONSIBLE PARTY NAME: TRIAD HUNTER, LLC

COUNTY: TYLER DISTRICT: ELLSWORTH

QUADRANGLE: Porters Falls

SURFACE OWNER: John & Leah Starkey

ROYALTY OWNER: Unknown

UTM GPS NORTHING: 4373724.7627

UTM GPS EASTING: 511556.8538 GPS ELEVATION: 868'

The Responsible Party named above has chosen to submit GPS coordinates in lieu of preparing a new well location plat for a plugging permit or assigned API number on the above well. The Office of Oil and Gas will not accept GPS coordinates that do not meet the following requirements:

1. Datum: NAD 1983, Zone: 17 North, Coordinate Units: meters, Altitude: height above mean sea level (MSL) – meters.
2. Accuracy to Datum – 3.05 meters
3. Data Collection Method:

Survey grade GPS  : Post Processed Differential \_\_\_\_\_  
Real-Time Differential

Mapping Grade GPS \_\_\_\_\_ : Post Processed Differential \_\_\_\_\_  
Real-Time Differential \_\_\_\_\_

4. Letter size copy of the topography map showing the well location.


I the undersigned, hereby certify this data is correct to the best of my knowledge and belief and shows all the information required by law and the regulations issued and prescribed by the Office of Oil and Gas.

Signature *M. J. ...*

OPERATIONS MANAGER  
Title

2/5/19  
Date

RECEIVED  
Office of Oil and Gas  
FEB - 8 2019  
WV Department of  
Environmental Protection

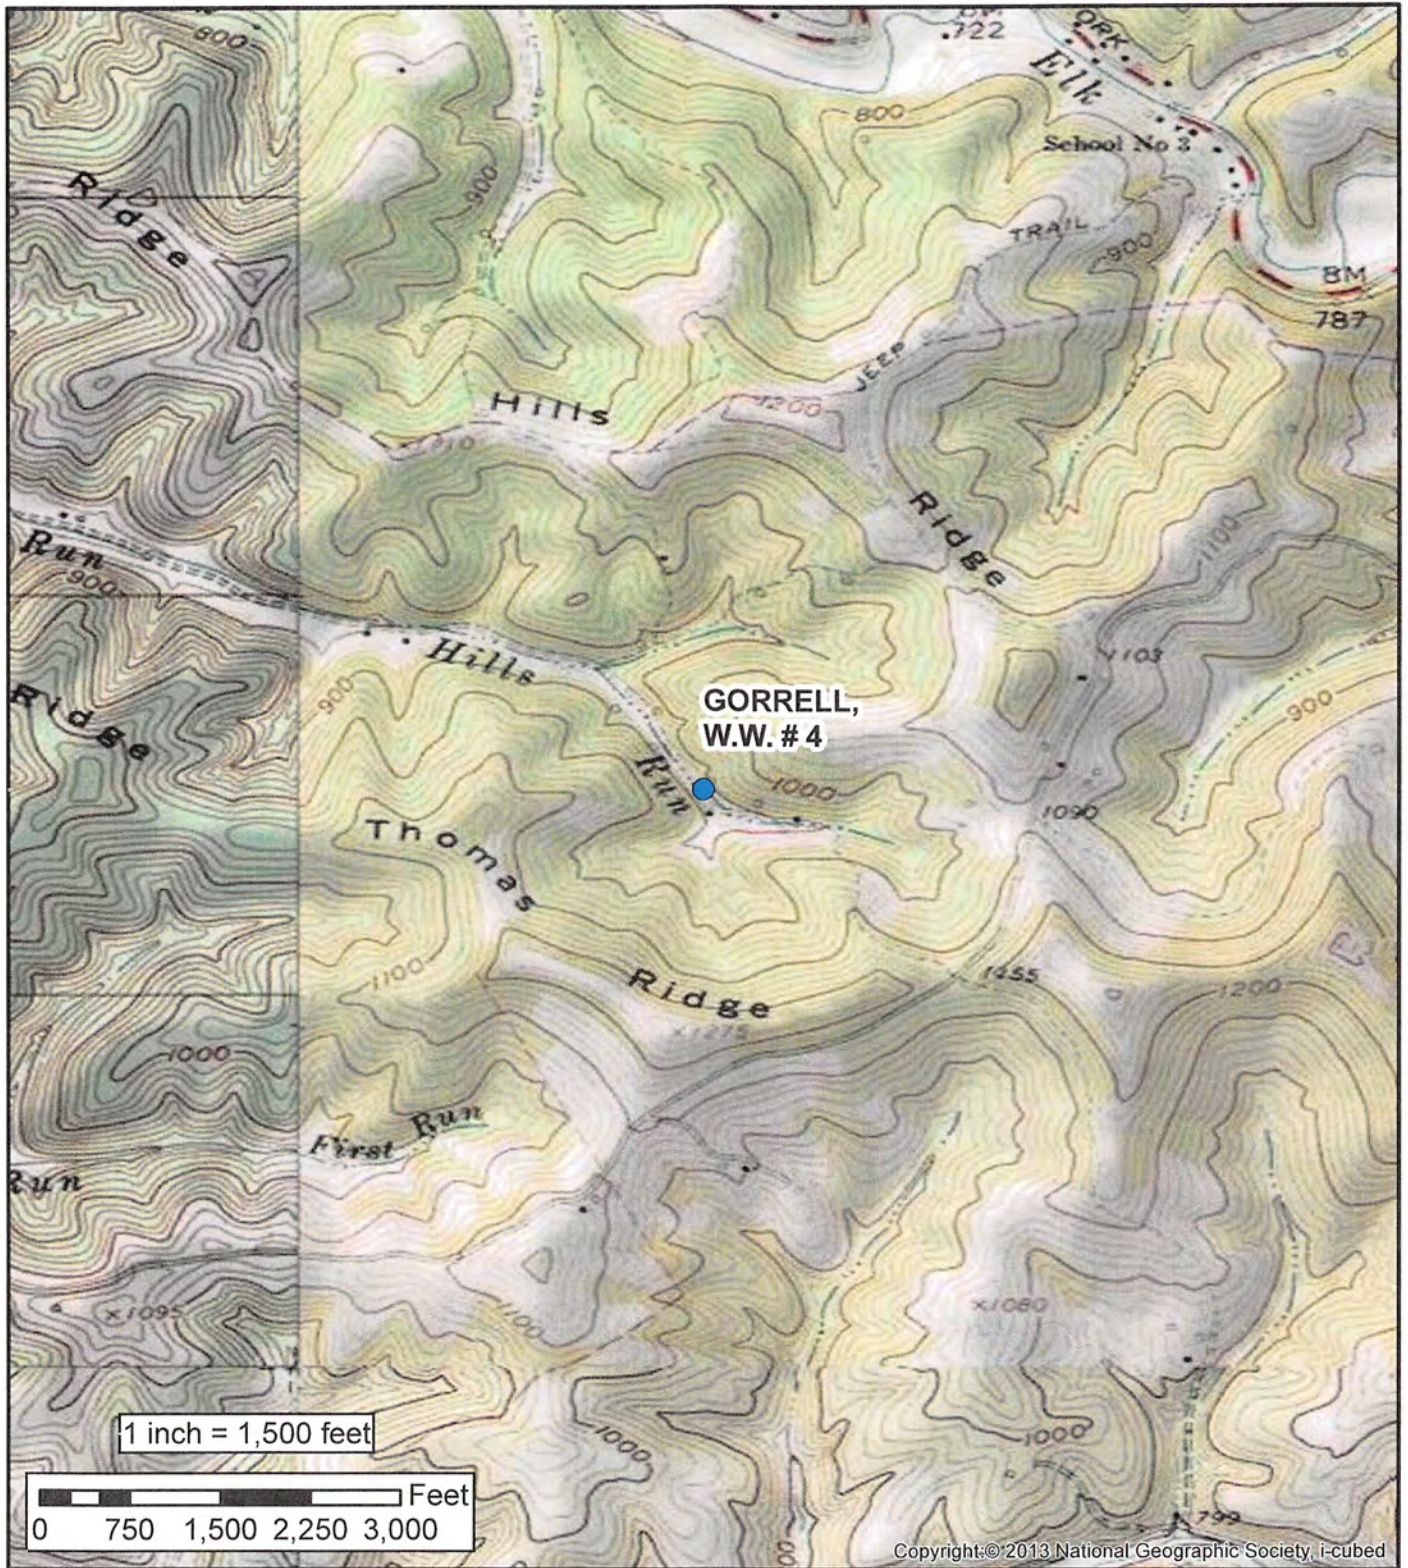

## Well Name: Gorrell. W.W. #4

Triad Hunter, LLC  
A subsidiary of Blue Ridge Mountain Resources, Inc.

Tyler County - Ellsworth District - West Virginia