
WW-7 8-30-06



## West Virginia Department of Environmental Protection Office of Oil and Gas

## WELL LOCATION FORM: GPS

WEELE	Carried of Order GIB	
<sub>API:</sub> 47-095-00582	well no.: 8	
FARM NAME: HILL, J. K.		
RESPONSIBLE PARTY NAME:	Triad Hunter, LLC	
COUNTY: TYLER		LSWORTH
QUADRANGLE: Porters F	alls	
SURFACE OWNER: DANIE	L R DEETZ	
ROYALTY OWNER: Unkno	wn	
UTM GPS NORTHING: 4375	546.0000	
UTM GPS EASTING: 512659	9.0000 GPS ELEVATI	<sub>ION:</sub> 877
The Responsible Party named above preparing a new well location plat for above well. The Office of Oil and Othe following requirements:  1. Datum: NAD 1983, Zon height above mean sea let 2. Accuracy to Datum – 3.0 3. Data Collection Method: Survey grade GPS X : Post Proceedings of the preparation	or a plugging permit or assigned A cas will not accept GPS coordinate e: 17 North, Coordinate Units: me evel (MSL) – meters. 95 meters	API number on the s that do not meet
Real-T	ime Differential X	
Mapping Grade GPS: Pos	t Processed Differential	
Rea	al-Time Differential	
4. Letter size copy of the t I the undersigned, hereby certify thi belief and shows all the information prescribed by the Office of Oil and	required by law and the regulation	knowledge and his issued and FEB - 8 2019
MilHac	Operations Manager	WV Department of Environmental Protection
Signature	Title	Date

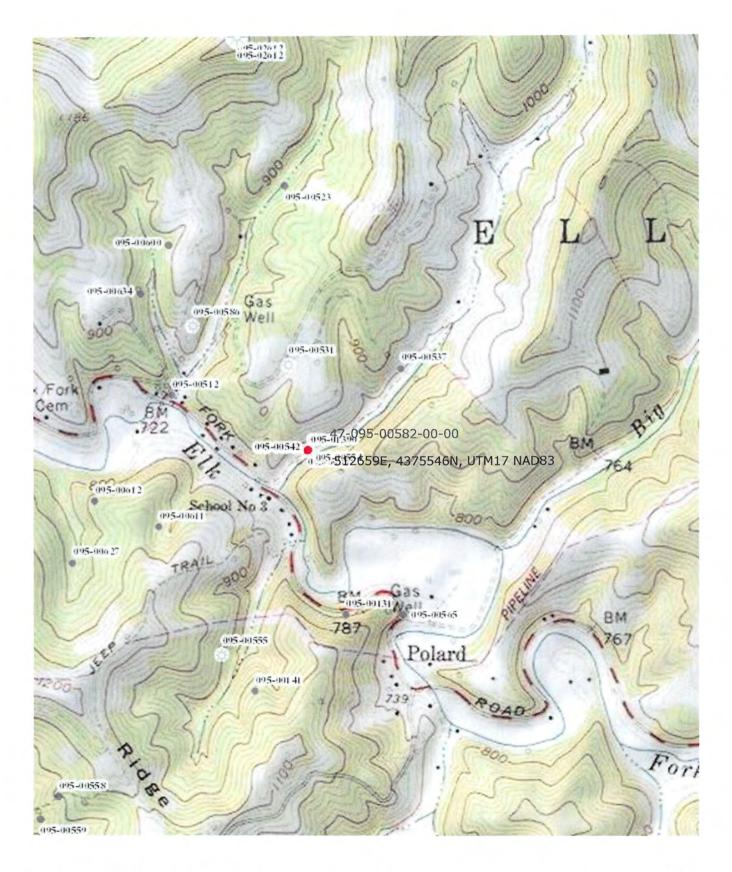

 $http://deparcgis1/ooggis/index.html?x = 512659 \& y = 4375546 \& datum = NAD83 \& pntlabel = 4... \\ 4/17/2019 = 4/17/2019 + 4/17/2019 = 4/17/2019 + 4/17/2019 = 4/17/2019 + 4/17/2019 = 4/17/2019 + 4/17/2019 = 4/1$