

STATE OF WEST VIRGINIA
DEPARTMENT OF ENVIRONMENTAL PROTECTION
OFFICE OF OIL AND GAS

AFFIDAVIT OF PLUGGING AND FILLING WELL

AFFIDAVIT SHOULD BE IN TRIPLICATE, one copy mailed to the Department, one copy to be retained by the Well Operator and the third copy (and extra copies if required) should be mailed to each coal operator at their respective addresses.

Farm name: Betty Marie Moore Operator Well No.: #1

LOCATION: Elevation: 872 Quadrangle: Middlebourne, West Union 15'

District: Meade County: Tyler

Latitude: _____ Feet South of 39 Deg. 25 Min. 00 Sec.

Longitude: _____ Feet West of 39 Deg. 24 Min. 25.64 Sec.

Well Type: OIL GAS

Company	<u>Sancho Oil & Gas</u>	Coal Operator	_____
	<u>P.O Box 179</u>	or Owner	_____
	<u>St. Mary's, WV 26170</u>		_____
Agent	<u>Loren Bagley</u>	Coal Operator	_____
		or Owner	_____
Permit Issued Date	<u>10/22/2013</u>		_____

AFFIDAVIT

STATE OF WEST VIRGINIA,
County of Wood ss:

Patchwork Oil & Gas, LLC and Roger L. Whited being first duly sworn according to law depose and say that they are experienced in the work of plugging and filling oil and gas wells and were employed by the above named well operator, and participated in the work of plugging and filling the above well say that said work was commenced on the 2 day of December, 2013, and the well was plugged and filled in the following manner:

TYPE	FROM	TO	PIPE REMOVED	LEFT
13"	Surface to	250	NONE	250'
8 5/8	Surface to	1007'	NONE	1007'
4 1/2	Surface to	2976'	765	765'-2976'


Description of monument: Name, API, Company, and date plugged _____ and that the work of plugging and filling said well was completed on the 18 day of December, 2013.

And further deponents saith not. Patchwork Oil & Gas, LLC

Sworn and subscribe before me this 2 day of January, 2014

My commission expires: Aug. 7, 2019

[Signature]
Notary Public

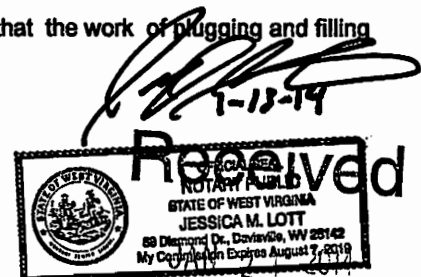


Office of Oil and Gas
WV Dept. of Environmental Protection
01/24/2014

Affidavit reviewed by the Office of Oil and Gas: _____ Title: _____

B.Moore #1
47-095-00692

85 bags of cement
13 bags of gel.

NOT TO SCALE

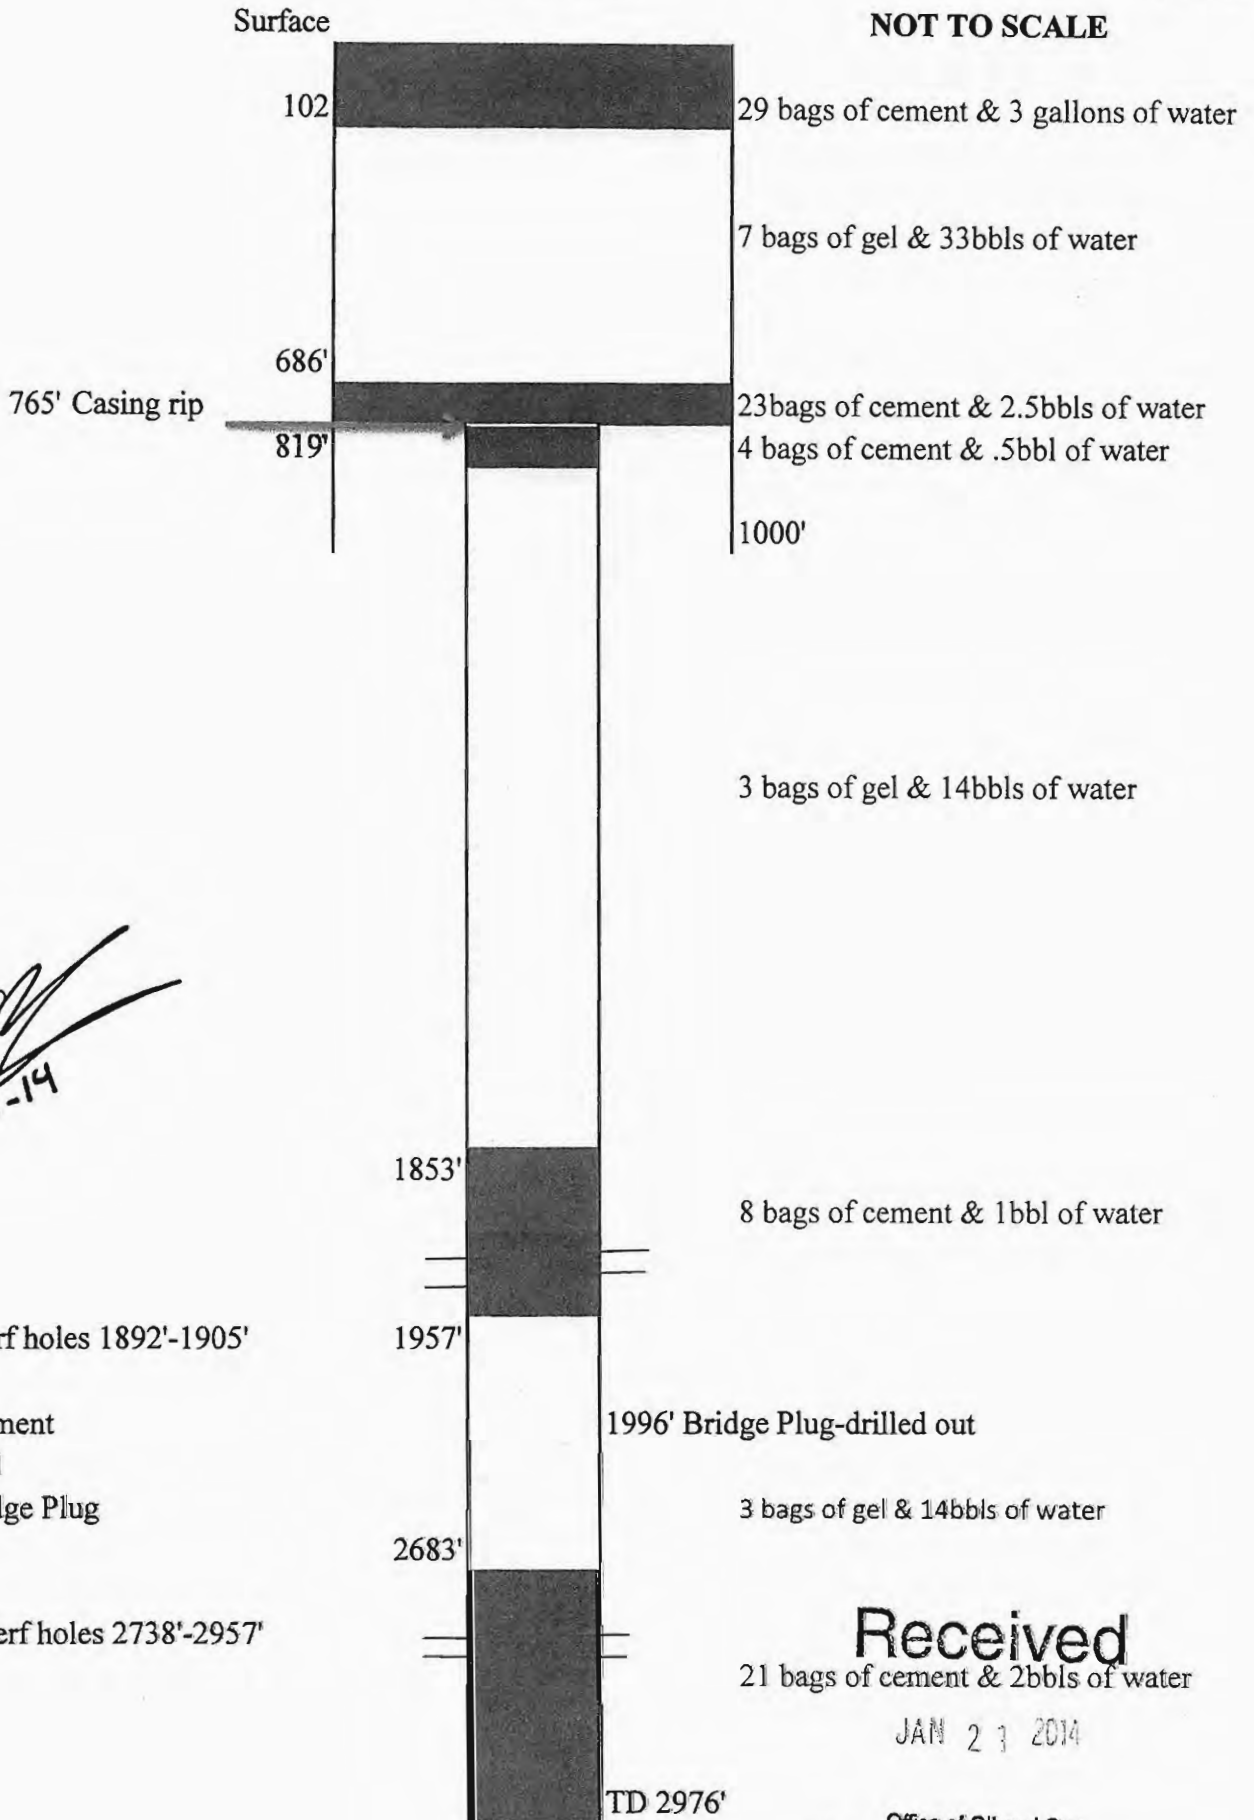

[Handwritten Signature]
1-13-14

6 Perf holes 1892'-1905'

: Cement
 : Gel
 : Bridge Plug

24 perf holes 2738'-2957'

Received

21 bags of cement & 2 bbls of water

JAN 23 2014

Office of Oil and Gas
WV Dept. of Environmental Protection

01/24/2014