

STATE OF WEST VIRGINIA  
DEPARTMENT OF ENVIRONMENTAL PROTECTION  
OFFICE OF OIL AND GAS

AFFIDAVIT OF PLUGGING AND FILLING WELL

AFFIDAVIT SHOULD BE IN TRIPLICATE, one copy mailed to the Department, one copy to be retained by the Well Operator and the third copy (and extra copies if required) should be mailed to each coal operator at their respective addresses.

Farm name: Betty Marie Moore Operator Well No.: #3

LOCATION: Elevation: 955' Quadrangle: Middlebourne  
District: Meade County: Tyler  
Latitude: \_\_\_\_\_ Feet South of 39 Deg. 56 Min. 57.24 Sec.  
Longitude: \_\_\_\_\_ Feet West of 39 Deg. 24 Min. 27.89 Sec.

Well Type: OIL  GAS

Company Sancho Oil & Gas Coal Operator \_\_\_\_\_  
P.O Box 179 or Owner \_\_\_\_\_  
St. Mary's, WV 26170 \_\_\_\_\_

Agent Loren Bagley Coal Operator \_\_\_\_\_  
Permit Issued Date 10/22/2013 or Owner \_\_\_\_\_

AFFIDAVIT

STATE OF WEST VIRGINIA,  
County of Wood ss:

Patchwork Oil & Gas, LLC and Roger L. Whited being first duly sworn according to law depose and say that they are experienced in the work of plugging and filling oil and gas wells and were employed by the above named well operator, and participated in the work of plugging and filling the above well say that said work was commenced on the 6 day of November, 2013, and the well was plugged and filled in the following manner:

TYPE	FROM	TO	PIPE REMOVED	LEFT
13"	Surface to	250	NONE	250'
8 5/8	Surface to	968	NONE	968'
4 1/2	Surface to	3020'	547'	547'-3020'


Received

JAN 27 2014

Office of Oil and Gas  
WV Dept. of Environmental Protection  
and that the work of plugging and filling

Description of monument: Name, API, Company, and date plugged  
said well was completed on the 11 day of November, 2013.

And further deponents saith not. Patchwork Oil & Gas, LLC  
8165 Elizabeth Pike Elizabeth, WV 26143  
*Roger L. Whited*

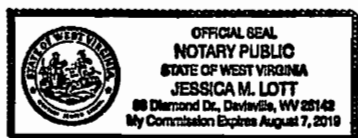

Sworn and subscribe before me this 22 day of November, 2013

My commission expires: August 7, 2019

*[Signature]*  
Notary Public


*[Signature]*  
1-13-14  
01/24/2014

Borehole 7 7/8  
100lb bags-

B. Moore #3  
FINAL

Cement Gel is mixed to state standards  
114 bags of cement 19 sacks of gel

95.00694

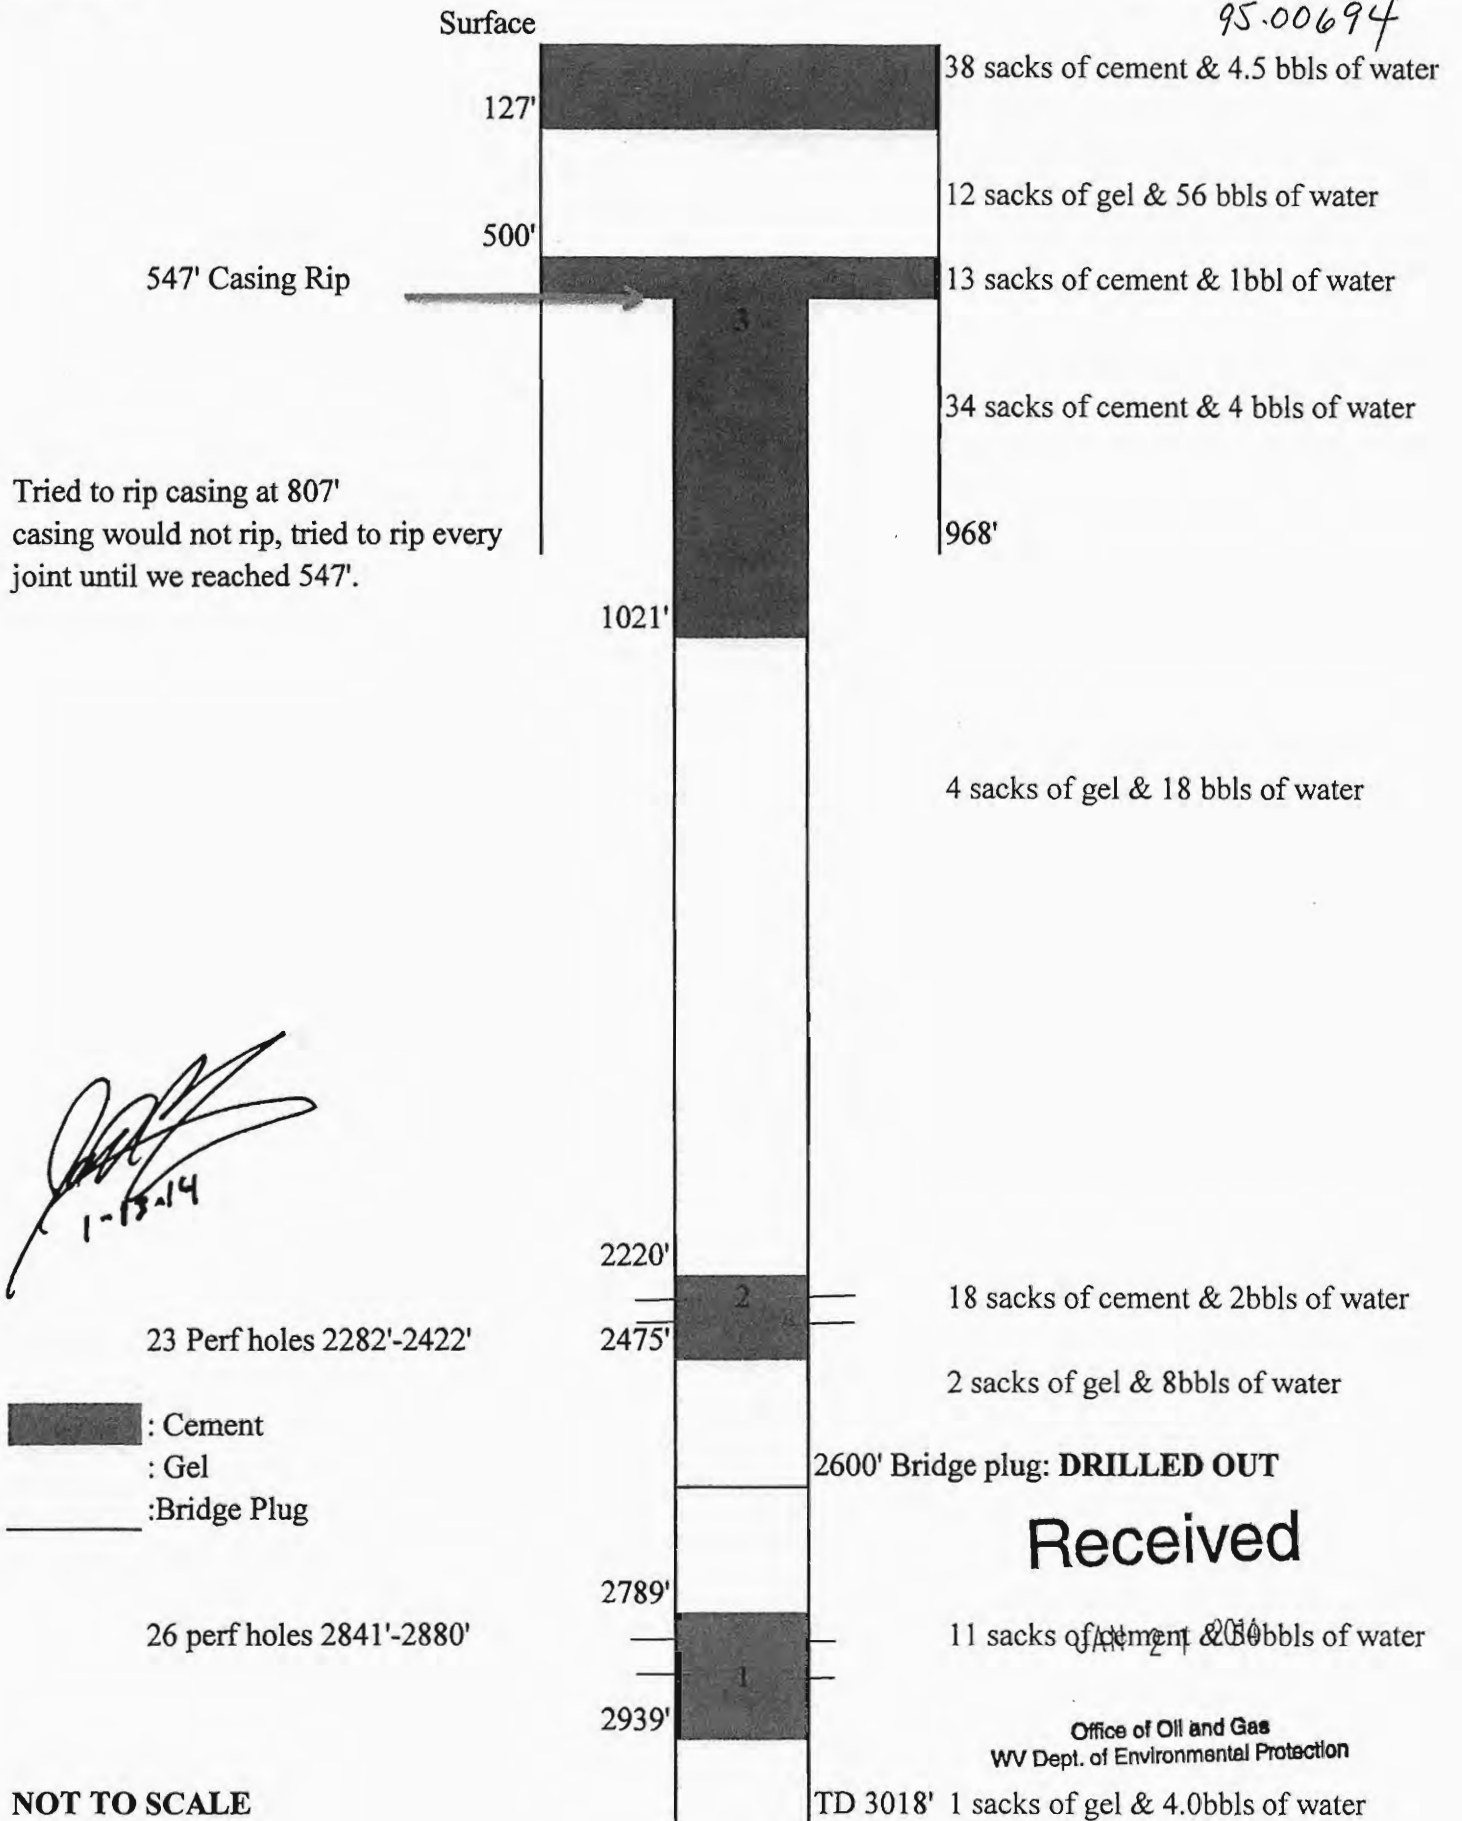

Tried to rip casing at 807'  
casing would not rip, tried to rip every  
joint until we reached 547'.

*[Handwritten Signature]*  
1-13-14

23 Perf holes 2282'-2422'

█ : Cement  
○ : Gel  
— : Bridge Plug

26 perf holes 2841'-2880'

**Received**

Office of Oil and Gas  
WV Dept. of Environmental Protection

NOT TO SCALE

01/24/2014