

FILE NO. 78-5288
 DRAWING NO. _____
 SCALE 1" = 500
 MINIMUM DEGREE OF ACCURACY 1 IN 2500
 PROVEN SOURCE OF ELEVATION BASE ELEV. POINTS WERE 108 & 1042 FROM ROAD INTERSECTIONS SHOWN ON PADEN CITY TOPO MAP

I THE UNDERSIGNED, HEREBY CERTIFY THAT THIS PLAT IS CORRECT TO THE BEST OF MY KNOWLEDGE AND BELIEF AND SHOWS ALL THE INFORMATION REQUIRED BY LAW AND THE REGULATIONS ISSUED AND PRESCRIBED BY THE DEPARTMENT OF MINES.
 (SIGNED) Henry M. Parsons
 R.P.E. _____ L.L.S. 98

HENRY M. PARSONS
 LICENSED
 No. 98
 STATE OF WEST VIRGINIA
 LAND SURVEYOR
 PLACE SEAL HERE

(+) DENOTES LOCATION OF WELL ON UNITED STATES TOPOGRAPHIC MAPS
 FORM IV-6 (8-78)



STATE OF WEST VIRGINIA
 DEPARTMENT OF MINES
 OIL AND GAS DIVISION


DATE JAN. 16, 1980
 OPERATOR'S WELL NO. CLAIR STARKEY #7
 API WELL NO. 47-TYLER-0810
 STATE COUNTY PERMIT

Cancelled

WELL TYPE: OIL GAS LIQUID INJECTION _____ WASTE DISPOSAL _____
 (IF "GAS,") PRODUCTION STORAGE _____ DEEP _____ SHALLOW _____
 LOCATION: ELEVATION 1063 WATER SHED PURSLEY CREEK
 DISTRICT LINCOLN COUNTY TYLER
 QUADRANGLE PADEN CITY 7 1/2 NEW MARTINSVILLE 15'
 SURFACE OWNER CLAIR STARKEY ACREAGE 174 ACRES (20 ACRE DRILLING UNIT)
 OIL & GAS ROYALTY OWNER CLAIR STARKEY LEASE ACREAGE 174

PROPOSED WORK: DRILL CONVERT _____ DRILL DEEPER _____ REDRILL _____ FRACTURE OR STIMULATE _____ PLUG OFF OLD FORMATION _____ PERFORATE NEW FORMATION _____ OTHER PHYSICAL CHANGE IN WELL (SPECIFY) _____

PLUG AND ABANDON _____ CLEAN OUT AND REPLUG _____
 TARGET FORMATION STASOND ESTIMATED DEPTH 3350'
 WELL OPERATOR EMES PETROLEUM Co. DESIGNATED AGENT C. W. Riggs, Inc. JAN 26 1987
 ADDRESS 619 LACONIA BLDG. WHEELING, W.VA. ADDRESS Box 358 ST. MARYS, W.VA. 26170

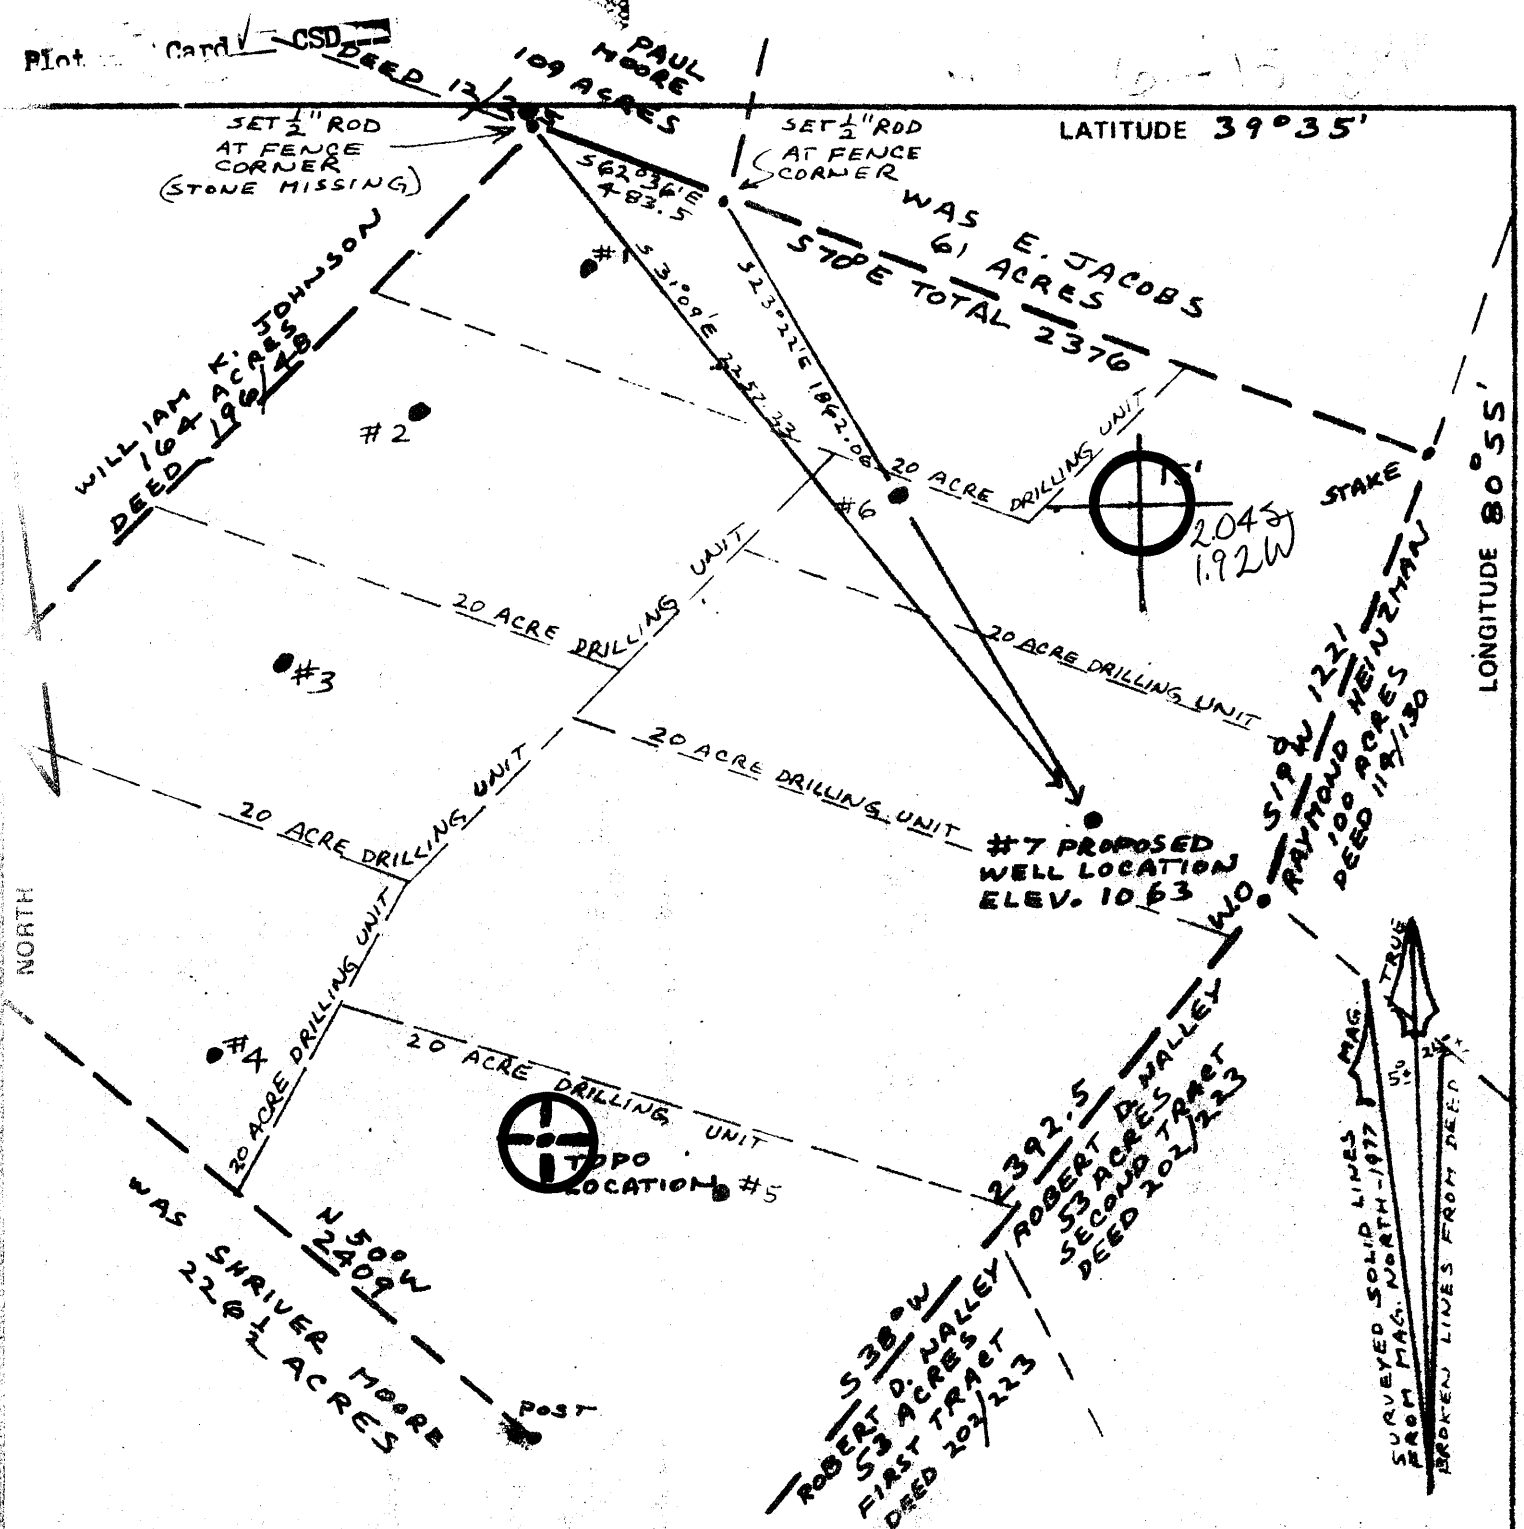

FILE NO. 78-5288
 DRAWING NO. _____
 SCALE 1" = 500
 MINIMUM DEGREE OF ACCURACY 1 IN 2500
 PROVEN SOURCE OF ELEVATION BASE (ELEV. POINTS WERE 108 & 1042 FROM ROAD INTERSECTIONS SHOWN ON PADEN CITY TOPO MAP)

I THE UNDERSIGNED, HEREBY CERTIFY THAT THIS PLAT IS CORRECT TO THE BEST OF MY KNOWLEDGE AND BELIEF AND SHOWS ALL THE INFORMATION REQUIRED BY LAW AND THE REGULATIONS ISSUED AND PRESCRIBED BY THE DEPARTMENT OF MINES.
 (SIGNED) Henry M. Parsons
 R.P.E. _____ L.L.S. 98

PLACE SEAL HERE

(+) DENOTES LOCATION OF WELL ON UNITED STATES TOPOGRAPHIC MAPS
 FORM IV-6 (8-78)



DATE JAN 16, 1980
 OPERATOR'S WELL NO. CLAIR STARLEY #7
 API WELL NO. _____
47 - TYLER - 0810
 STATE COUNTY PERMIT

STATE OF WEST VIRGINIA
 DEPARTMENT OF MINES
 OIL AND GAS DIVISION

WELL TYPE: OIL GAS LIQUID INJECTION _____ WASTE DISPOSAL _____
 (IF "GAS,") PRODUCTION STORAGE _____ DEEP _____ SHALLOW _____
 LOCATION: ELEVATION 1063 WATER SHED PURSELY CREEK
 DISTRICT LINCOLN COUNTY TYLER
 QUADRANGLE PADEN CITY 7 & NEW MARTINSVILLE 15' SW
 SURFACE OWNER CLAIR STARLEY ACREAGE 174 ACRES (20 ACRE DRILLING UNIT)
 OIL & GAS ROYALTY OWNER CLAIR STARLEY LEASE ACREAGE 174
 LEASE NO. _____

PROPOSED WORK: DRILL CONVERT _____ DRILL DEEPER _____ REDRILL _____ FRACTURE OR STIMULATE _____ PLUG OFF OLD FORMATION _____ PERFORATE NEW FORMATION _____ OTHER PHYSICAL CHANGE IN WELL (SPECIFY) _____

PLUG AND ABANDON _____ CLEAN OUT AND REPLUG _____
 TARGET FORMATION STENSEN ESTIMATED DEPTH 3350'
 WELL OPERATOR EMES PETROLEUM Co. DESIGNATED AGENT L. L. Ragsdale, Inc.
 ADDRESS 619 LACONIA BLDG. WHEELING, W. Va. ADDRESS Box 358 St. Marys, W. Va. 26170 JUL 16 1980



STATE OF WEST VIRGINIA
DEPARTMENT OF MINES

Oil and Gas Division

OIL AND GAS WELL PERMIT APPLICATION

TO THE DEPARTMENT OF MINES,
Charleston, W. Va.

Surface Owner Clair Starkey
Address Sistersville, W. Va.
Mineral Owner Clair Starkey
Address Sistersville, W. Va.
Coal Owner Clair Starkey
Address Sistersville, W. Va.
Coal Operator None
Address _____

DATE 4-17-80
Company Emes Petroleum Co., Inc.
Address 619 Laconia Bldg., Wheeling, W. V.
Farm Starkey Acres 174
Location (waters) Badger Run
Well No. 7 Elevation 1063'
District Lincoln County Tyler
Quadrangle Paden City, W. Va.

THIS PERMIT MUST BE POSTED AT THE WELL SITE

All provisions being in accordance with Chapter 22, of the W. Va. Code, the location is hereby approved for drilling. This permit shall expire if operations have not commenced by 2-16-81.

INSPECTOR
TO BE NOTIFIED Phil Tracy
ADDRESS Middlebourne, W. Va.
PHONE 758-4573

[Signature]
Deputy Director - Oil & Gas Division

GENTLEMEN:

The undersigned well operator is entitled to drill upon the above named farm or tract of land for oil and gas, having fee title thereto, (or as the case may be) under grant or lease dated Oct. 4 1978 by John Richmond made to James T. Emes and recorded on the 4th day of Oct. 1978 in Tyler County, Book 217 Page 9
 NEW WELL DRILL DEEPER REDRILL FRACTURE OR STIMULATE
 OIL AND GAS WELL ORIGINALLY DRILLED BEFORE JUNE 5, 1969.

The enclosed plat was prepared by a registered engineer or licensed land surveyor and all coal owners and/or operators have been notified as of the above date.
The above named coal owners and/or operator are hereby notified that any objection they wish to make, or are required to make by Section 3 of the Code, must be received by, or filed with the Department of Mines within ten (10) days.
Copies of this notice and the enclosed plat were mailed by registered mail, or delivered to the above named coal operators or coal owners at their above shown respective address _____ day _____ before, or on the same day with the mailing or delivery of this copy to the Department of Mines at Charleston, West Virginia.

PLEASE SUBMIT COPIES OF ALL GEOPHYSICAL LOGS DIRECTLY TO:

WEST VIRGINIA GEOLOGICAL AND ECONOMIC SURVEY
P. O. BOX 879
MORGANTOWN, WEST VIRGINIA 26505
AC-304 - 292-6331

JUL 16 1980

Very truly yours,
(Sign Name) James T. Emes
Well Operator
619 Laconia Bldg.
Street
Wheeling
City or Town
W. Va.
State

OIL & GAS DIVISION
DEPT. OF MINES

*SECTION 3 If no objections are filed or found by the Department of mines, within said period of ten days from the receipt of notice and plat by the department of mines, to said proposed location, the department shall forthwith issue to the well operator a permit reciting the filing of such plat, that no objections have been made by the coal operators or found therein by the department and that the same is approved and the well operator authorized to proceed.

