


A-B	N23°49'E	18.00'
B-C	N76°11'W	163.50'
C-D	N19°56'W	56.00'
D-E	N85°41'W	72.00'
E-F	S40°58'W	49.16'
F-G	N62°58'W	177.28'
G-H	S31°54'W	100.00'
H-I	N40°56'W	154.13'
I-J	N56°53'W	165.11'
J-K	N56°53'W	92.77'
K-L	N62°53'W	96.79'
L-M	N84°18'W	103.14'
M-N	N58°35'W	30.00'
N-O	N37°84'E	165.75'
O-P	S30°07'E	37.93'

7.5 TOPO LOCATION
1.885
0.42W

Calc 15 loc
4.765
2.64W

FILE NO. _____
 DRAWING NO. _____
 SCALE 1" = 500
 MINIMUM DEGREE OF ACCURACY 1/200
 PROVEN SOURCE OF ELEVATION JCT. OF ROADS 1200'± SOUTH OF LOCATION, ELEV. = 872'

I THE UNDERSIGNED, HEREBY CERTIFY THAT THIS PLAT IS CORRECT TO THE BEST OF MY KNOWLEDGE AND BELIEF AND SHOWS ALL THE INFORMATION REQUIRED BY LAW AND THE REGULATIONS ISSUED AND PRESCRIBED BY THE DEPARTMENT OF MINES. Mark C. Echard
 (SIGNED) MARK C. ECHARD
 R.P.E. _____ L.L.S. 490

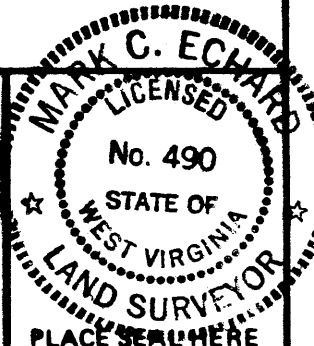

(+) DENOTES LOCATION OF WELL ON UNITED STATES TOPOGRAPHIC MAPS
 FORM IV-6 (8-78)



DATE JULY 31, 19 85
 OPERATOR'S WELL NO. TWO-PLUG
 API WELL NO.
 47 - 095 - 1046 - P
 STATE COUNTY PERMIT

STATE OF WEST VIRGINIA
 DEPARTMENT OF MINES
 OIL AND GAS DIVISION

WELL TYPE: OIL ___ GAS LIQUID INJECTION ___ WASTE DISPOSAL ___
 (IF "GAS,") PRODUCTION ___ STORAGE ___ DEEP ___ SHALLOW
 LOCATION: ELEVATION 878' WATER SHED UNNAMED DRAIN INTO THE OHIO RIVER
 DISTRICT _____ UNION _____ COUNTY TYLER
 QUADRANGLE NEW MATAMORAS, OHIO - W.VA. 7.5' ↓ 151 SE
 SURFACE OWNER BILLY D. HANLIN, ET AL ACREAGE 37.84
 OIL & GAS ROYALTY OWNER BILLY D. HANLIN, ET AL LEASE ACREAGE 37.84
 LEASE NO. _____
 PROPOSED WORK: DRILL ___ CONVERT ___ DRILL DEEPER ___ REDRILL ___ FRACTURE OR STIMULATE ___ PLUG OFF OLD FORMATION ___ PERFORATE NEW FORMATION ___ OTHER PHYSICAL CHANGE IN WELL (SPECIFY) _____
 PLUG AND ABANDON CLEAN OUT AND REPLUG ___
 TARGET FORMATION _____ ESTIMATED DEPTH _____
 WELL OPERATOR STEVE DUCKWORTH DESIGNATED AGENT STEVE DUCKWORTH
 ADDRESS BOX 88 - DAVISSON ROUTE ADDRESS BOX 88 - DAVISSON ROUTE
 GASSAWAY, WV 26624 GASSAWAY, WV 26624

OCT 7 1985

STATE OF WEST VIRGINIA
DEPARTMENT OF MINES
OIL AND GAS WELLS DIVISION

RECEIVED
SEP 20 1984

OIL & GAS DIVISION

DEPT. OF MINES

AFFIDAVIT OF PLUGGING AND FILLING WELL

AFFIDAVIT SHOULD BE MADE IN TRIPPLICATE. ONE COPY MAILED TO THE DEPARTMENT, ONE COPY TO BE RETAINED BY THE WELL OPERATOR AND THE THIRD COPY (AND EXTRA COPIES IF REQUIRED) SHOULD BE MAILED TO EACH COAL OPERATOR AT THEIR RESPECTIVE ADDRESSES.

COAL OPERATOR OR OWNER	Steve Duckworth
ADDRESS	NAME OF WELL OPERATOR Davison Rt. Box 88 - Gassaway, W.Va.
COAL OPERATOR OR OWNER	COMPLETE ADDRESS 26624
ADDRESS	Sept. 20, 1984 19
LEASE OR PROPERTY OWNER	WELL AND LOCATION Union District
ADDRESS	Tyler County
	Well No. 2 (two)
	Billy D. Hanlin Farm

STATE INSPECTOR SUPERVISING PLUGGING Robert Lowther

AFFIDAVIT

STATE OF WEST VIRGINIA,
County of _____ } SS:

Eugene Prunty and Todd Duckworth
being first duly sworn according to law depose and say that they are experienced in the work of plugging and filling oil and gas wells and were employed by Steve Duckworth, well operator, and participated in the work of plugging and filling the above well, that said work was commenced on the 21 day of May, 1984, and that the well was plugged and filled in the following manner:

SAND OR ZONE RECORD FORMATION	FILLING MATERIAL	PLUGS USED SIZE & KIND	CASING	
			CSG PULLED	CSG LEFT IN
	Cleaned out to 1581'			
	Filled hole with Gel			
	Cement 1581' to 1481'			
	Cement 1200' to 1100'			
	Cement 800' to 700'			
	Cement 150' to Surface			
	Set marker and reclaimed according to rules and regulations.			
GOAL SEAMS			DESCRIPTION OF MONUMENT	
(NAME)				
(NAME)				
(NAME)				
(NAME)				

and that the work of plugging and filling said well was completed on the 29 day of May, 1984

And further deponents saith not.

Sworn to and subscribed before me this 20 day of September, 1984

Eugene Prunty
Todd Duckworth
Albert B. Stewart

My commission expires:
Aug 9, 1988

Notary Public.
Permit No. 095-1046-P