

West Virginia Department of Environmental Protection
Office of Oil & Gas

WELL LOCATION FORM: GPS

API: 47- 095 - 1088 WELL NO: No.6

FARM NAME: Ben C. Jackman

RESPONSIBLE PARTY NAME: Gastar Exploration, Ltd.

COUNTY: Tyler DISTRICT: McElroy

QUADRANGLE: Shirley 7.5'

SURFACE OWNER: Louis Blattner

ROYALTY OWNER: Louis Blattner et al.

UTM GPS NORTHING: 4,363,357 (NAD 83)

UTM GPS EASTING: 517,953 (NAD 83) GPS ELEVATION: 350 m. 1149 ft.

The Responsible Party named above has chosen to submit GPS coordinates in lieu of preparing a new well location plat for a plugging permit on the above well. The Office of Oil & Gas will not accept GPS coordinates that do not meet the following requirements:

1. Datum: NAD 1983, Zone:17 North, Coordinate Units: meters, Altitude: height above mean sea level (MSL) - meters.
2. Accuracy to Datum - 3.05 meters
3. Data Collection Method:

Survey Grade GPS	<input type="checkbox"/>	Post Processed Differential	<input type="checkbox"/>
		Real-Time Differential	<input type="checkbox"/>
Mapping Grade GPS	<input checked="" type="checkbox"/>	Post Processed Differential	<input checked="" type="checkbox"/>
		Real-Time Differential	<input type="checkbox"/>

I the undersigned, hereby certify this data is correct to the best of my knowledge and belief and shows all the information required by law and the regulations issued and prescribed by the Office of Oil and Gas.

Michael Q. McCown Mike McCown
Signature


September 8, 2013
Date

COO & Designated Agent
Title

Received

OCT 2 2013

SUBJECT WELL
Ben C. Jackman No.6
47-095-1088

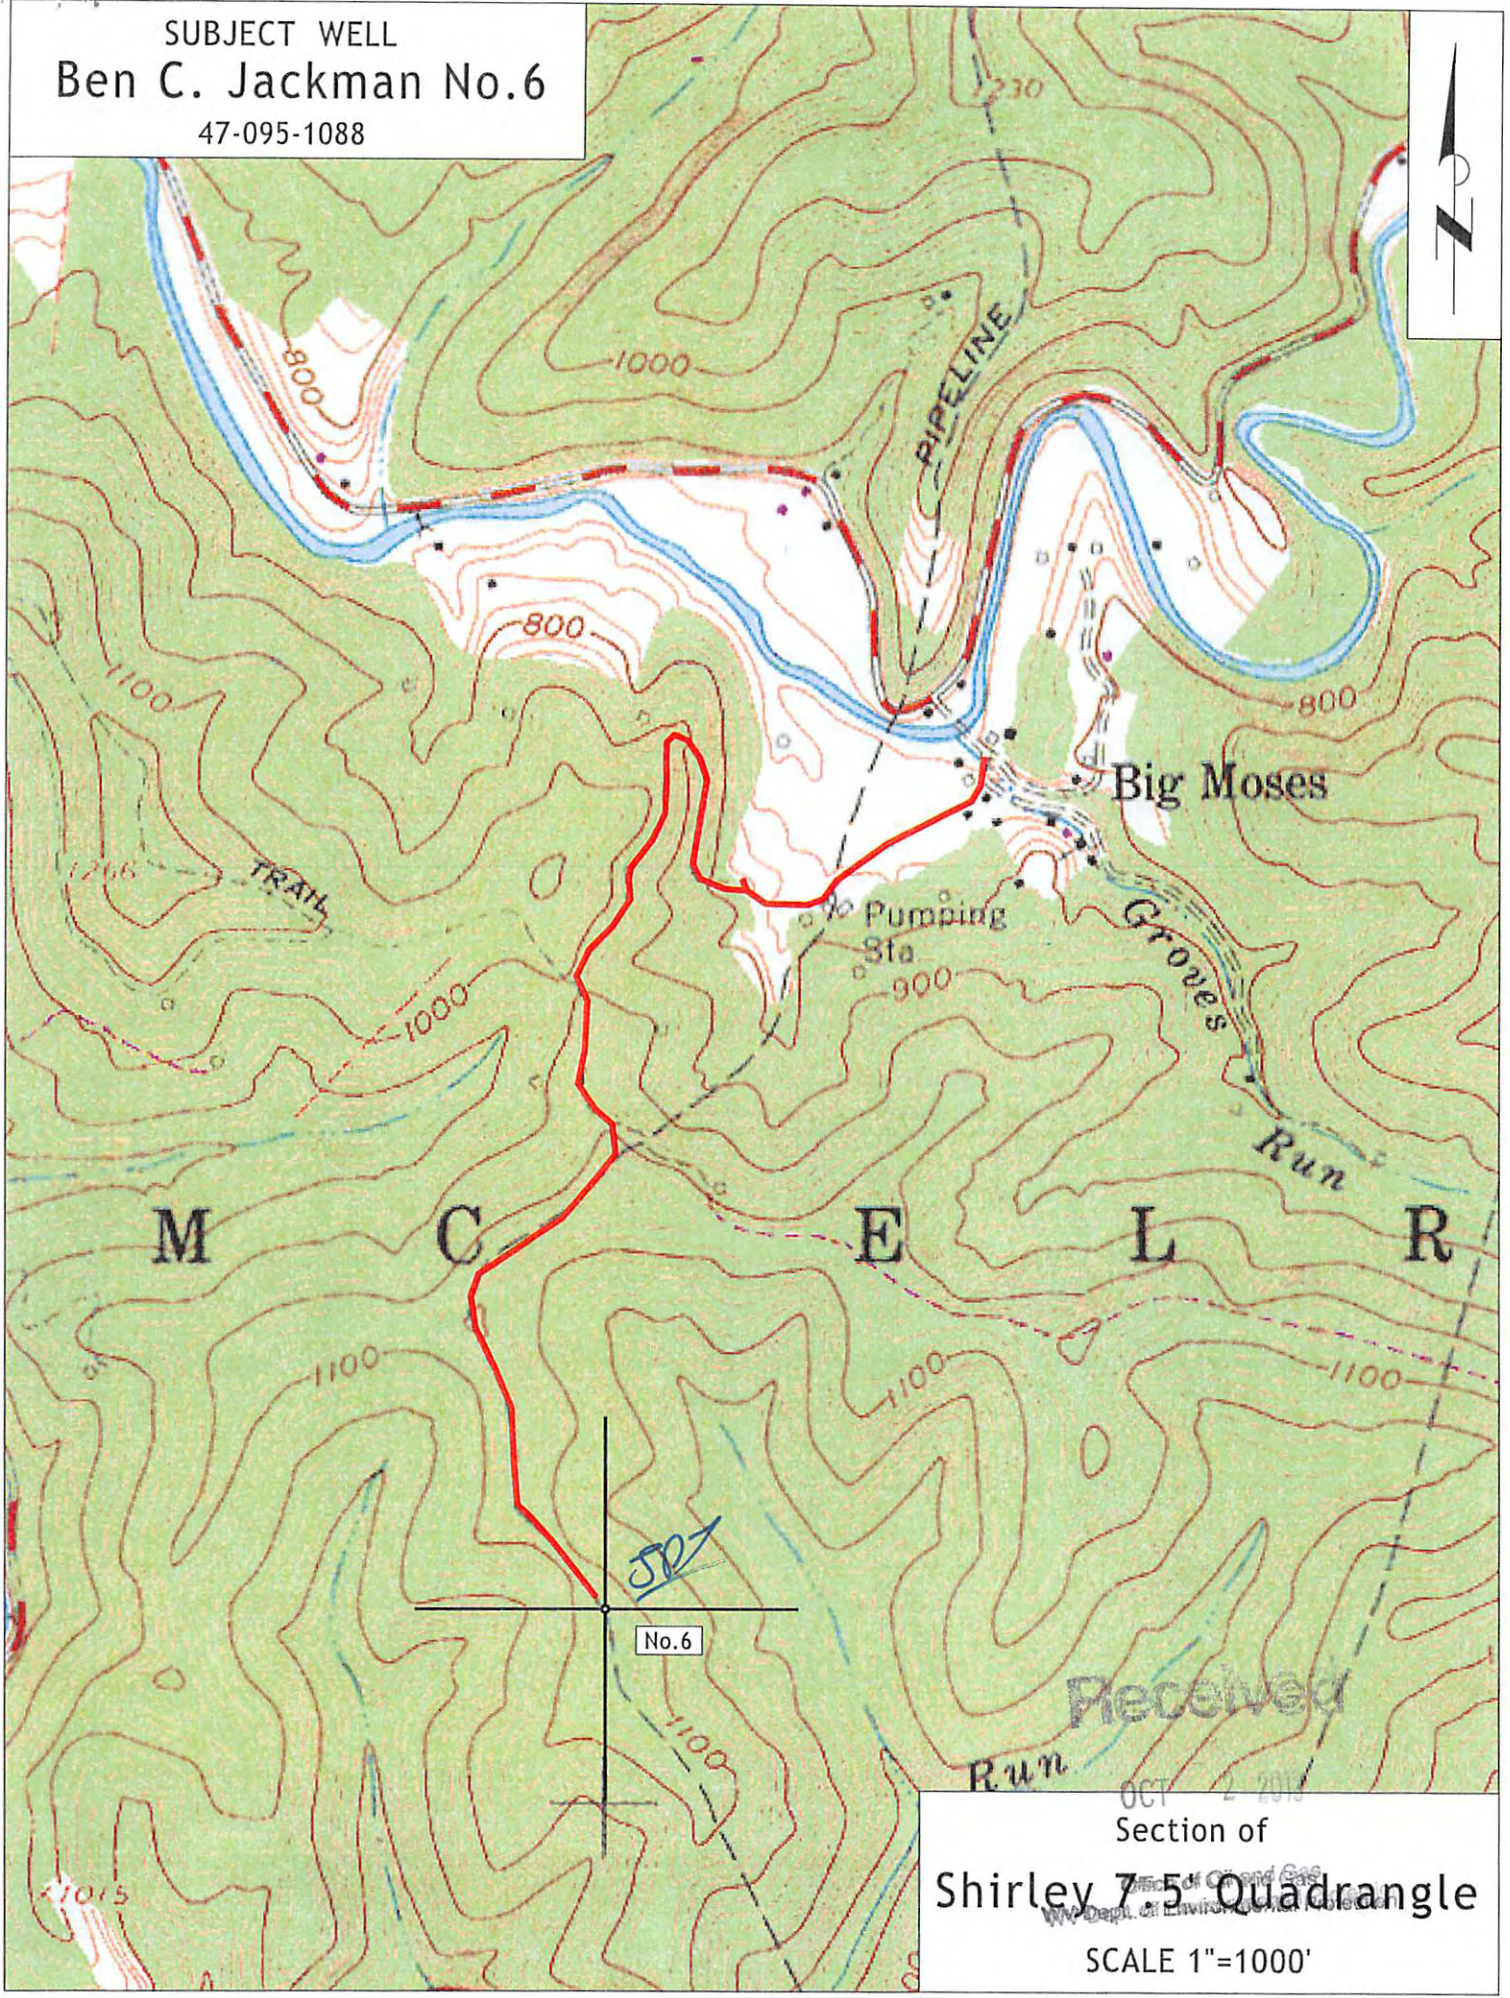

Received
OCT 2 2013
Section of
Shirley 7.5 Quadrangle
SCALE 1"=1000'