

9501126P

WW-7  
5-02

West Virginia Department of Environmental Protection  
Office of Oil & Gas

**WELL LOCATION FORM: GPS**

API: 47- 095 - 1126 WELL NO: No.19

FARM NAME: F.R. Ball

RESPONSIBLE PARTY NAME: HG Energy, LLC

COUNTY: Tyler DISTRICT: McElroy

QUADRANGLE: Centerpoint 7.5'

SURFACE OWNER: Betty Jean Hayes

ROYALTY OWNER: American Energy Partners LLC, et al.

UTM GPS NORTHING: 4,367,137

UTM GPS EASTING: 527,257 GPS ELEVATION: 367 m. (1204ft)

The Responsible Party named above has chosen to submit GPS coordinates in lieu of preparing a new well location plat for a plugging permit on the above well. The Office of Oil & Gas will not accept GPS coordinates that do not meet the following requirements:

1. Datum: NAD 1983, Zone:17 North, Coordinate Units: meters, Altitude: height above mean sea level (MSL) - meters.
2. Accuracy to Datum - 3.05 meters
3. Data Collection Method:

Survey Grade GPS	<input type="checkbox"/>	Post Processed Differential	<input type="checkbox"/>
		Real-Time Differential	<input type="checkbox"/>
Mapping Grade GPS	<input checked="" type="checkbox"/>	Post Processed Differential	<input checked="" type="checkbox"/>
		Real-Time Differential	<input type="checkbox"/>

I the undersigned, hereby certify this data is correct to the best of my knowledge and belief and shows all the information required by law and the regulations issued and prescribed by the Office of Oil and Gas.

Diane White  
Signature


February 19, 2015  
Date

Designated Agent  
Title

Received  
Office of Oil & Gas  
APR 29 2015  
07/03/2015



SUBJECT WELL  
F.R. Ball No. 19  
47-095-1126

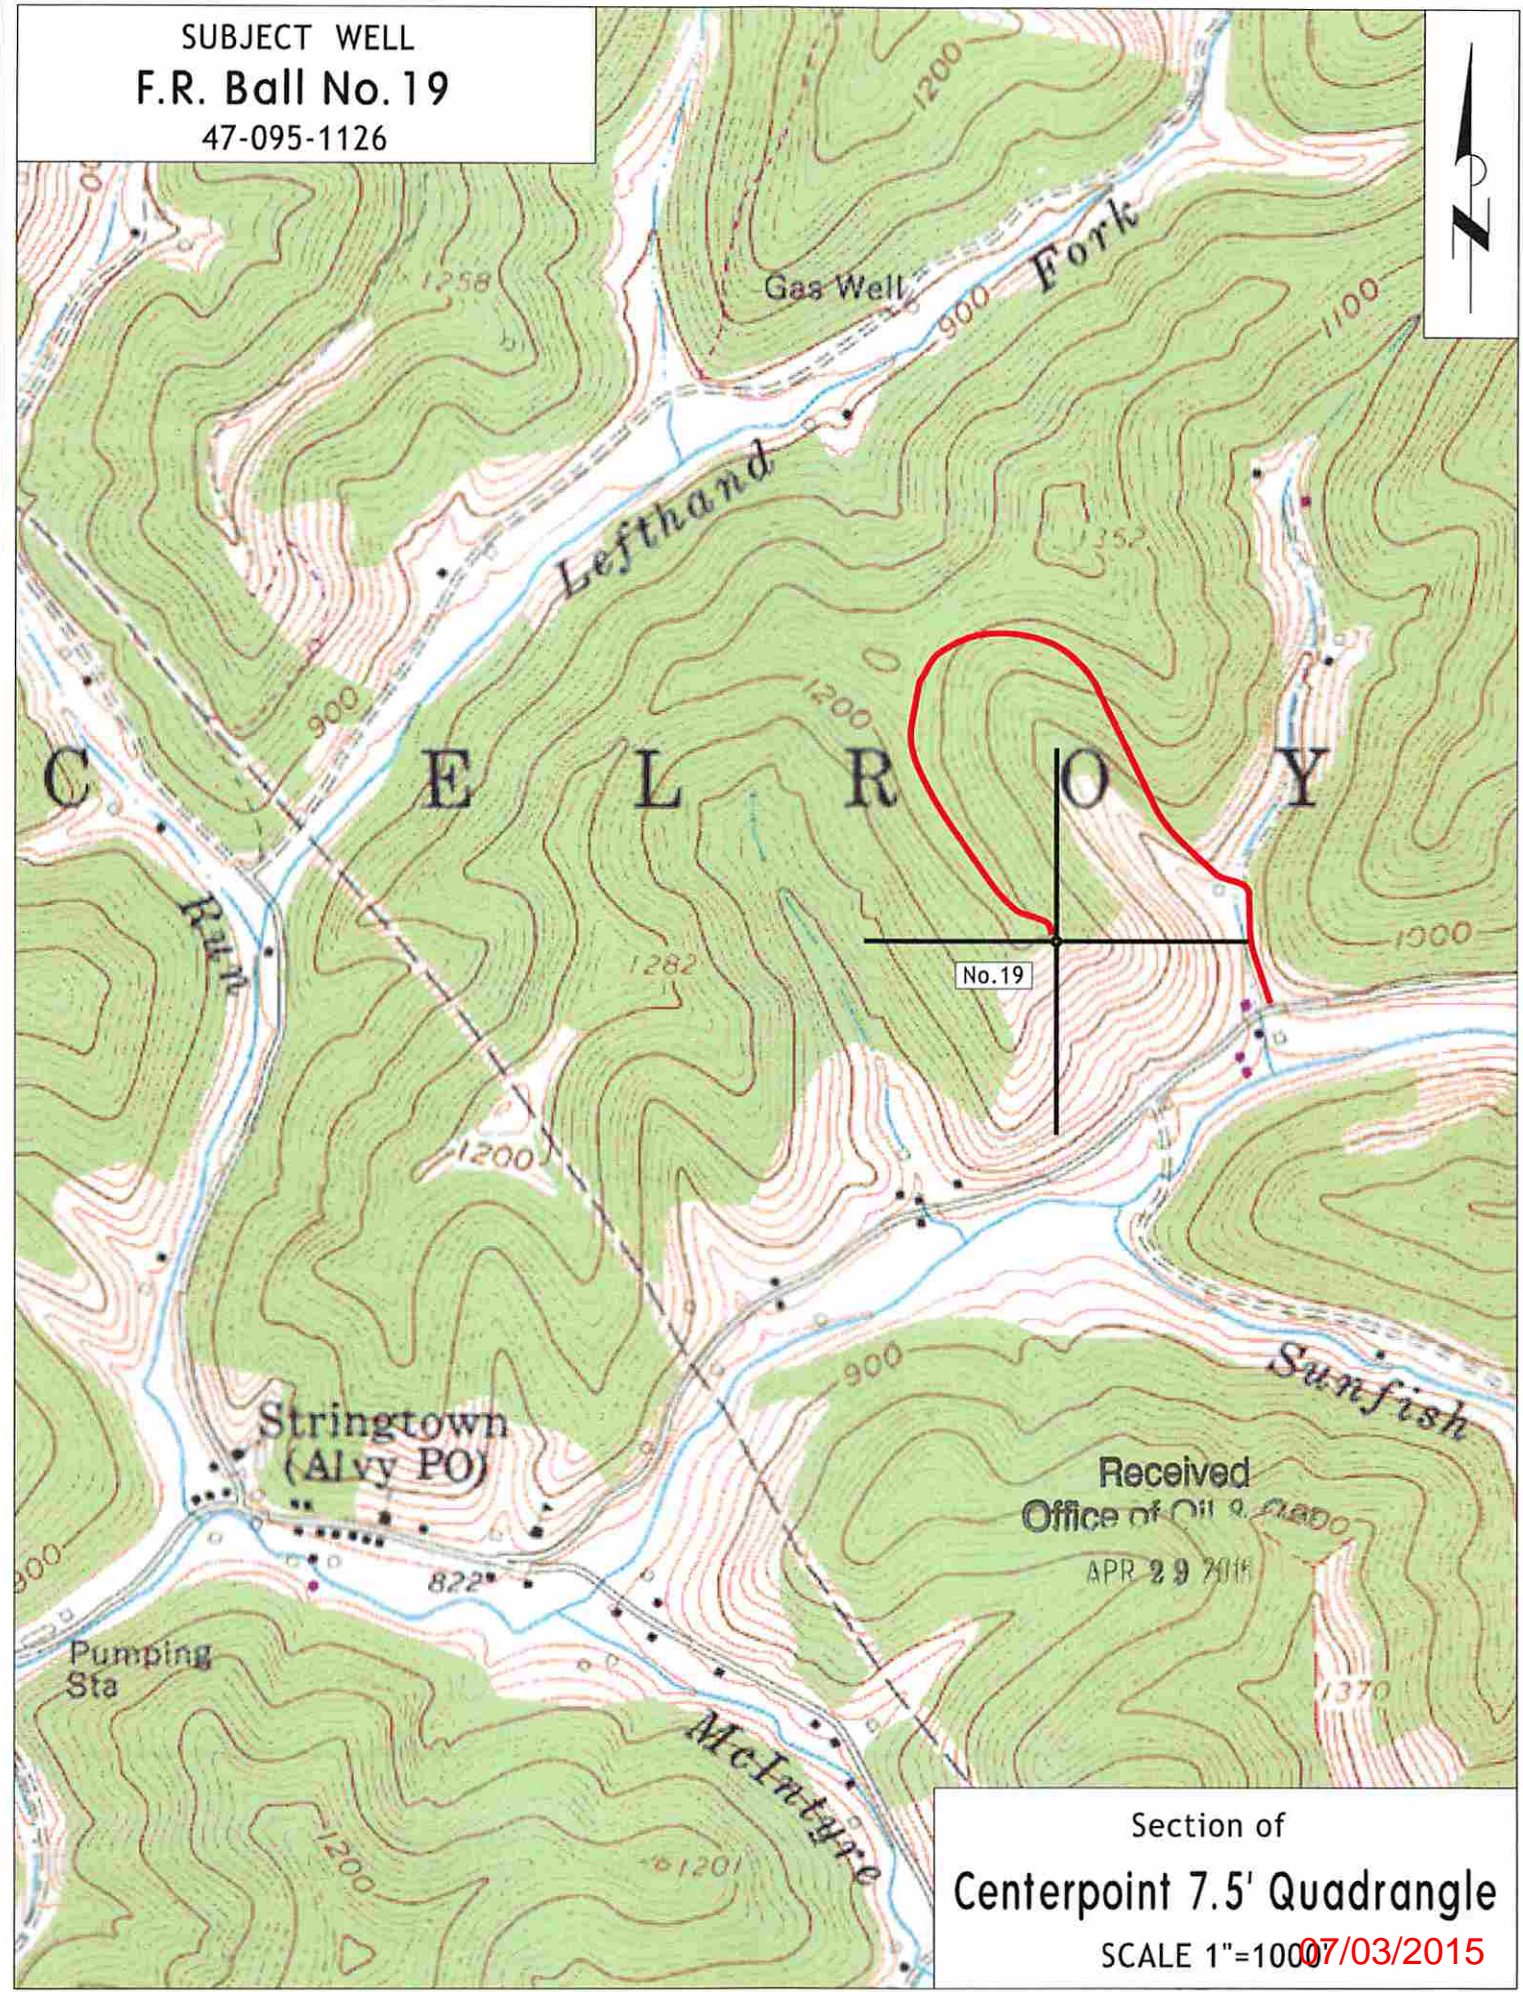

Section of  
**Centerpoint 7.5' Quadrangle**  
SCALE 1"=1000' 07/03/2015