


4709501397P

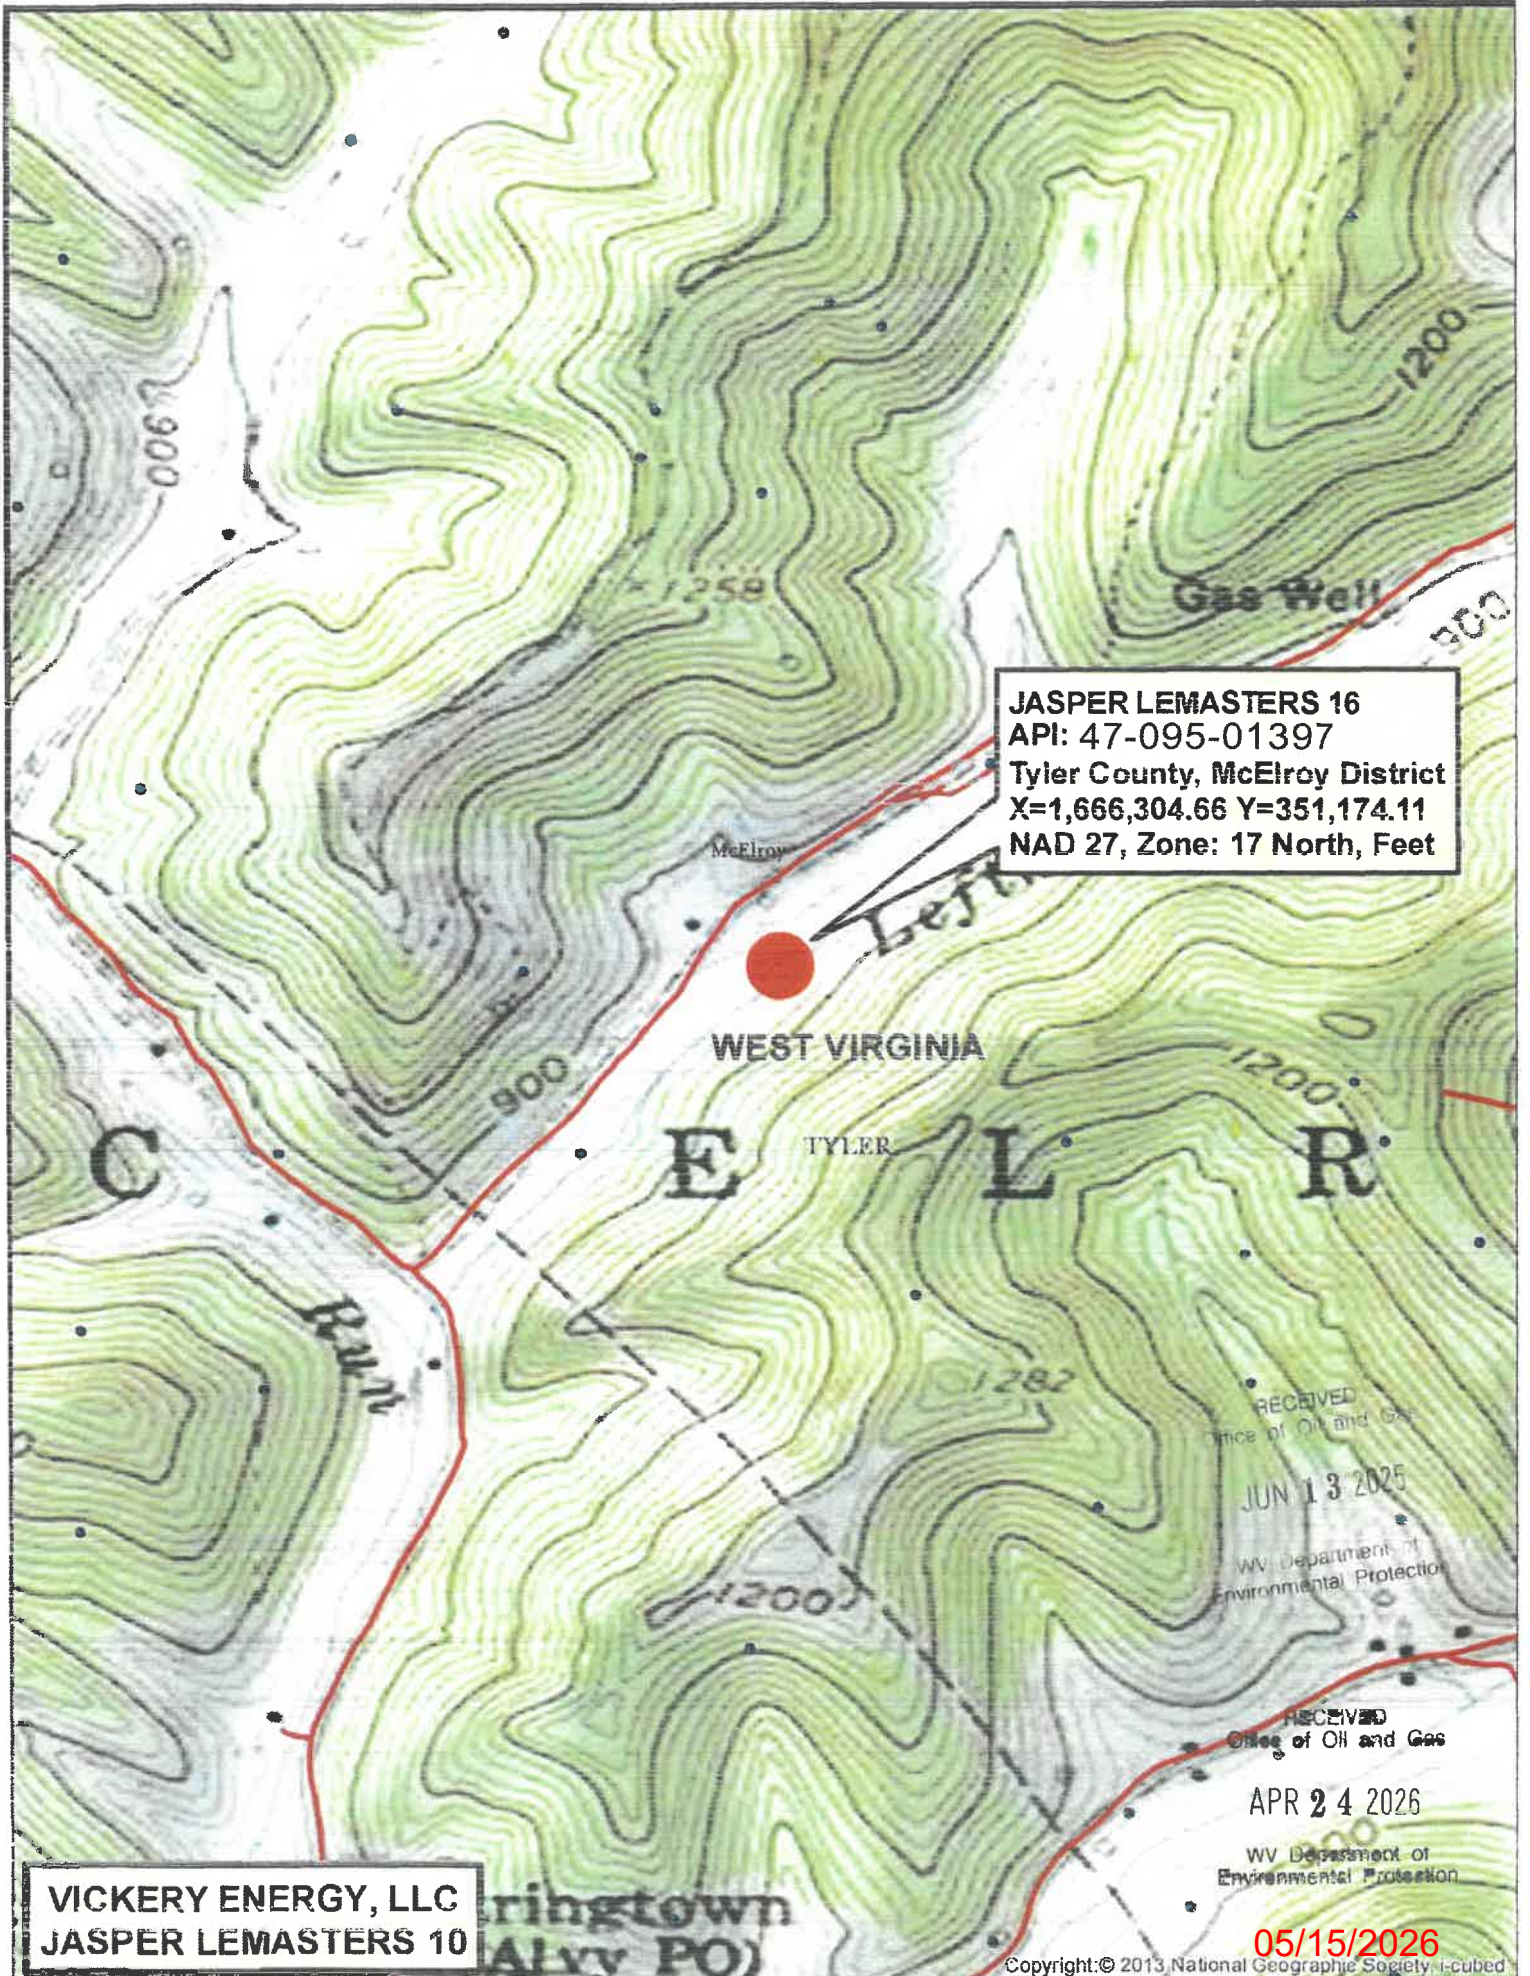

JASPER LEMASTERS 16
API: 47-095-01397
Tyler County, McElroy District
X=1,666,304.66 Y=351,174.11
NAD 27, Zone: 17 North, Feet

VICKERY ENERGY, LLC
JASPER LEMASTERS 10

RECEIVED
Office of Oil and Gas
JUN 13 2025
WV Department of
Environmental Protection

RECEIVED
Office of Oil and Gas
APR 24 2026
WV Department of
Environmental Protection

05/15/2026

Oil&Gas

Wells, Horizontal Only

WellStatus

- Active Well
- Permit Issued
- Permit Application
- Plugged

Wells, Active Status Only


WellUse

- Brine Disposal
- Fluid Injection
- Gas Production
- House Gas
- Observation
- Oil Production
- Production
- Solution Mining
- Storage
- Vent
- <all other values>

Wells, Other than Active Status

WellUse

- Brine Disposal
- Fluid Injection
- Gas Production
- House Gas
- Observation
- Oil Production
- Production
- Solution Mining

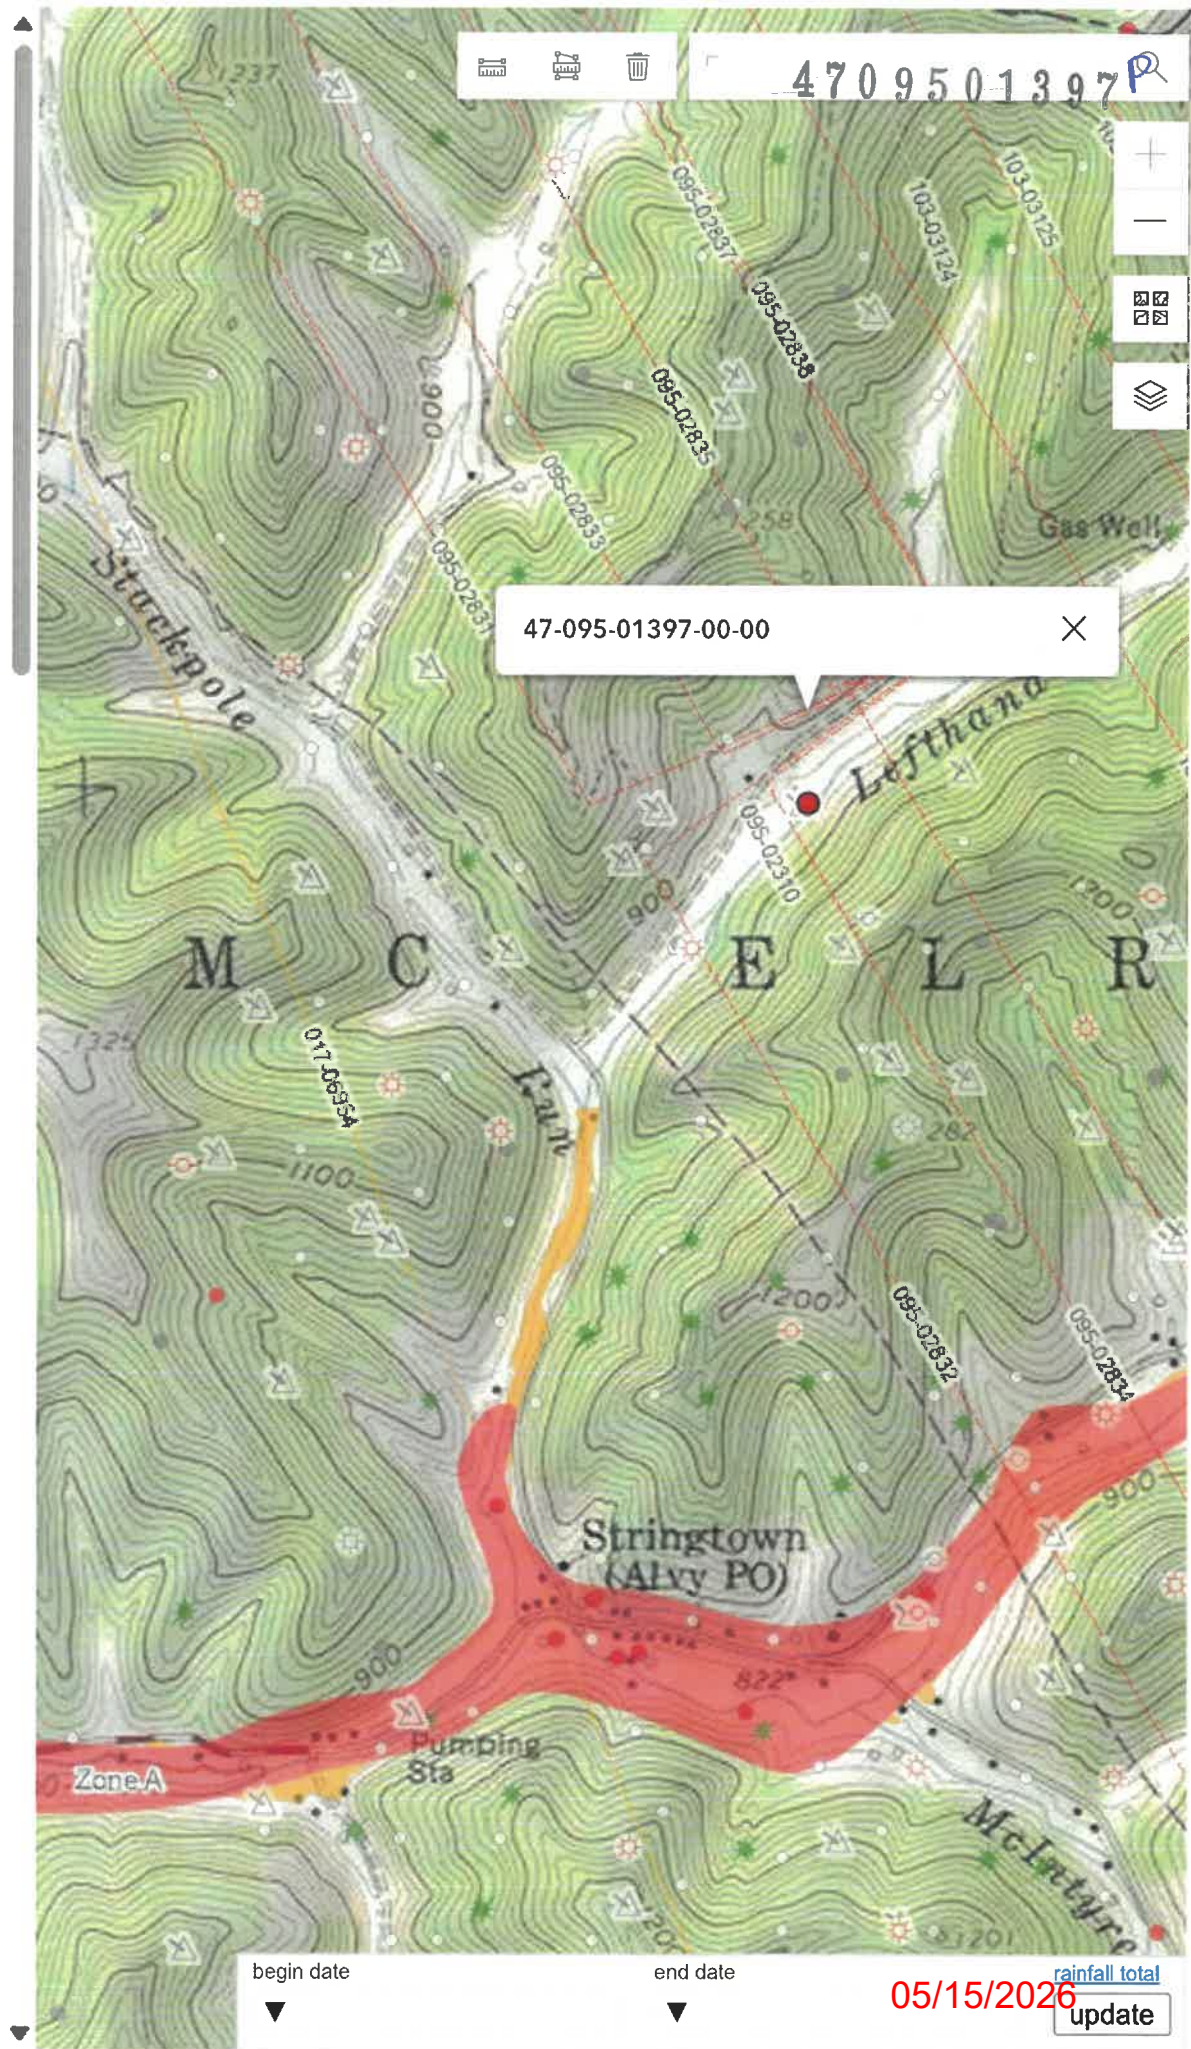

begin date

end date

05/15/2026 rainfall total update

WW-7
8-30-06



West Virginia Department of Environmental Protection
Office of Oil and Gas

WELL LOCATION FORM: GPS

API: 47-095-01397 WELL NO.: 16

FARM NAME: Lemasters, Jasper

RESPONSIBLE PARTY NAME: Vickery Energy, LLC

COUNTY: Tyler DISTRICT: McElroy

QUADRANGLE: Centerpoint 7.5'

SURFACE OWNER: Jerry Walters

ROYALTY OWNER: Stringtown Unit 1

UTM GPS NORTHING: 4367662.99

UTM GPS EASTING: 526389.30 GPS ELEVATION: 854'

The Responsible Party named above has chosen to submit GPS coordinates in lieu of preparing a new well location plat for a plugging permit or assigned API number on the above well. The Office of Oil and Gas will not accept GPS coordinates that do not meet the following requirements:

1. Datum: NAD 1983, Zone: 17 North, Coordinate Units: meters, Altitude: height above mean sea level (MSL) – meters.
2. Accuracy to Datum – 3.05 meters
3. Data Collection Method:

Survey grade GPS ____: Post Processed Differential ____

Real-Time Differential ____

Mapping Grade GPS : Post Processed Differential ____

Real-Time Differential ____

RECEIVED
Office of Oil and Gas

APR 24 2026

4. Letter size copy of the topography map showing the well location.

I the undersigned, hereby certify this data is correct to the best of my knowledge and belief and shows all the information required by law and the regulations issued and prescribed by the Office of Oil and Gas.

David Oliver
Digitally signed by David Oliver
Date: 2026.03.03 08:17:38
-05'00'

Pipeline&Facility Administrator

3/3/2026

Signature

Title

Date

05/15/2026