

Longitude - 80° 41' 37.3"

7.625'

LATITUDE 39° 27' 30"


Longitude - 39° 29' 58.3"

NOTES ON SURVEY

1 - The survey drawing shown hereon is from the original drilling permit plat dated 5/29/86 by Curtis A. Lucas, P.S. Plat was re-drafted to show updated surface owner names and as-dripped Latitude and Longitude information.

2 - Surface owners and adjoiners information obtained from the Tyler County Assessor's tax records.

3 - Well Latitude and Longitude established by field survey and scaled from Centerpoint 7.5' Quadrangle.

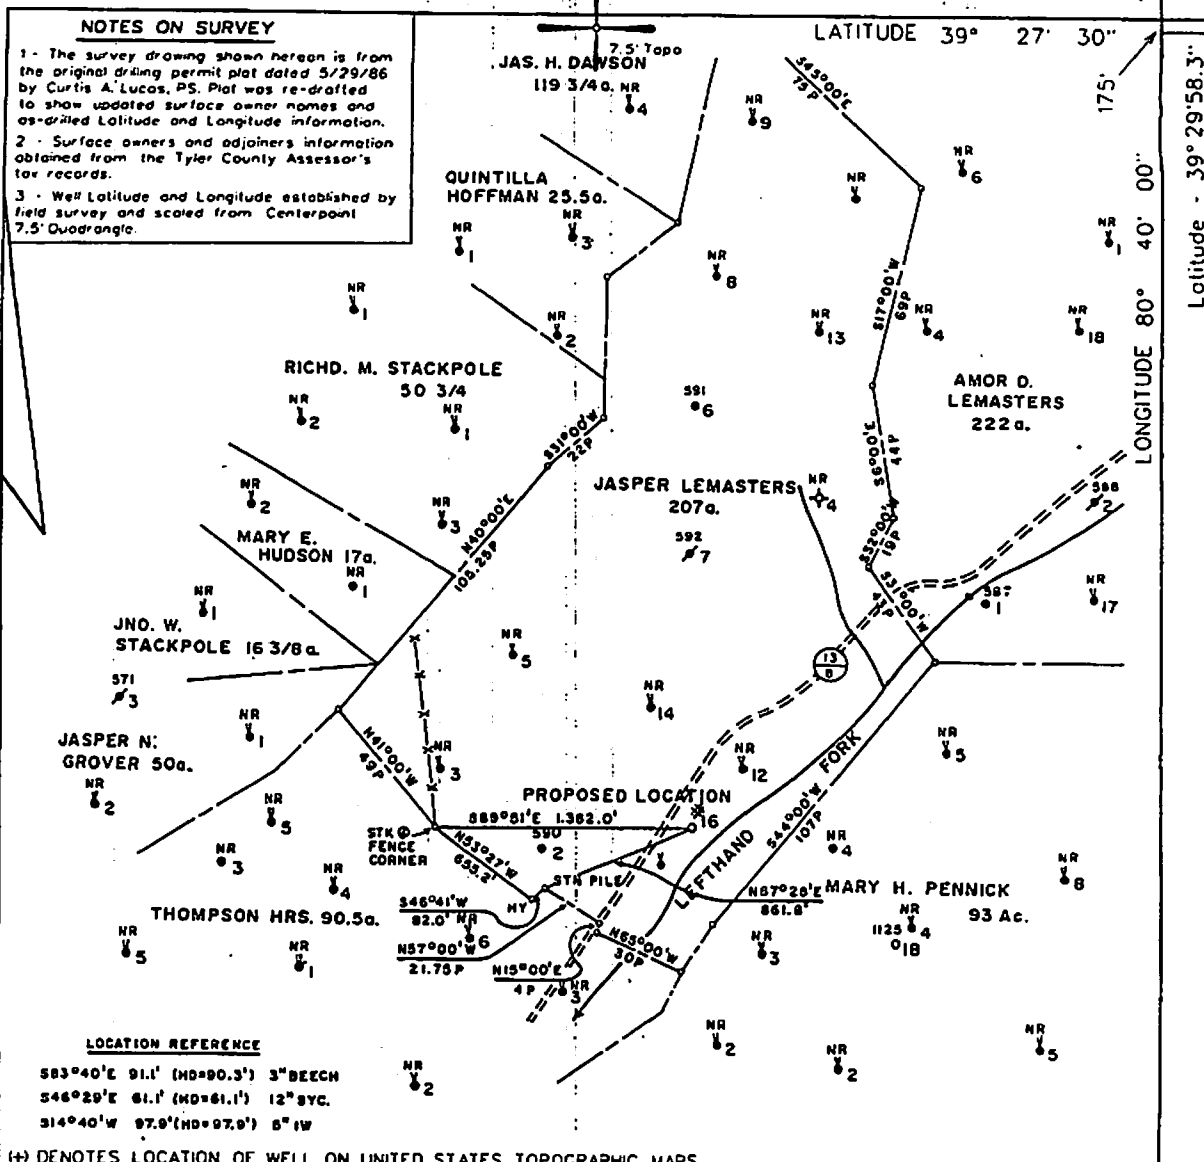

LOCATION REFERENCE


583°40'E 91.1' (HD=90.3') 3" BEECH
 548°29'E 81.1' (HD=81.1') 12" NYC.
 314°40'W 97.8' (HD=97.8') 6" IW

(H) DENOTES LOCATION OF WELL ON UNITED STATES TOPOGRAPHIC MAPS

FILE NO. 1753
 MAP NO. N47 N 1 S E W 5
 SCALE 1" = 800'
 MINIMUM DEGREE OF ACCURACY 1 in 200
 PROVEN SOURCE OF ELEVATION East Resources Co. Records

I THE UNDERSIGNED, HEREBY CERTIFY THAT THIS PLAT IS CORRECT TO THE BEST OF MY KNOWLEDGE AND BELIEF AND SHOWS ALL THE INFORMATION REQUIRED BY LAW AND THE REGULATIONS ISSUED AND PRESCRIBED BY THE DEPARTMENT OF MINES.

(SIGNED) *[Signature]*
 TIMOTHY P. ROUSH PS 793

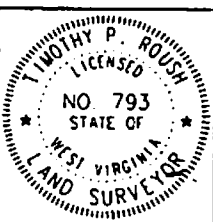

WEST VIRGINIA
 Division of Environmental Protection
 Office of Oil and Gas
 1356 Honsford St.
 Charleston, West Virginia 25301



DATE September 25, 2002
 FARM Jasper Lemasters NO. 16
 API WELL NO. 47-095-01397F

WELL TYPE: OIL GAS LIQUID INJECTION _____ WASTE DISPOSAL _____
 (IF "GAS") PRODUCTION STORAGE _____ DEEP _____ SHALLOW

LOCATION: ELEVATION 854' WATERSHED Lefthand Fork
 DISTRICT McElroy COUNTY Tyler
 QUADRANGLE Centerpoint 7.5'

SURFACE OWNER Jerry Walters ACREAGE 86.44 Ac.
 OIL & GAS ROYALTY OWNER Don E. Riddle LEASE ACREAGE 207 Ac.
 LEASE NO. RG 2171-00

PROPOSED WORK: DRILL _____ CONVERT _____ DRILL DEEPER _____ REDRILL _____ FRACTURE OR STIMULATE PLUG OFF OLD FORMATION _____ PERFORATE NEW FORMATION _____ OTHER PHYSICAL CHANGE IN WELL (SPECIFY) _____

PLUG AND ABANDON _____ CLEAN OUT AND REPLUG _____
 TARGET FORMATION Gordon ESTIMATED DEPTH 2.860'

WELL OPERATOR East Resources, Inc. DESIGNATED AGENT Michael McCown
 ADDRESS P. O. Box 5519 ADDRESS P. O. Box 5519
Vienna, W.Va. 26105 Vienna, W.Va. 26105

CANCELLED