


INSTRUCTIONS

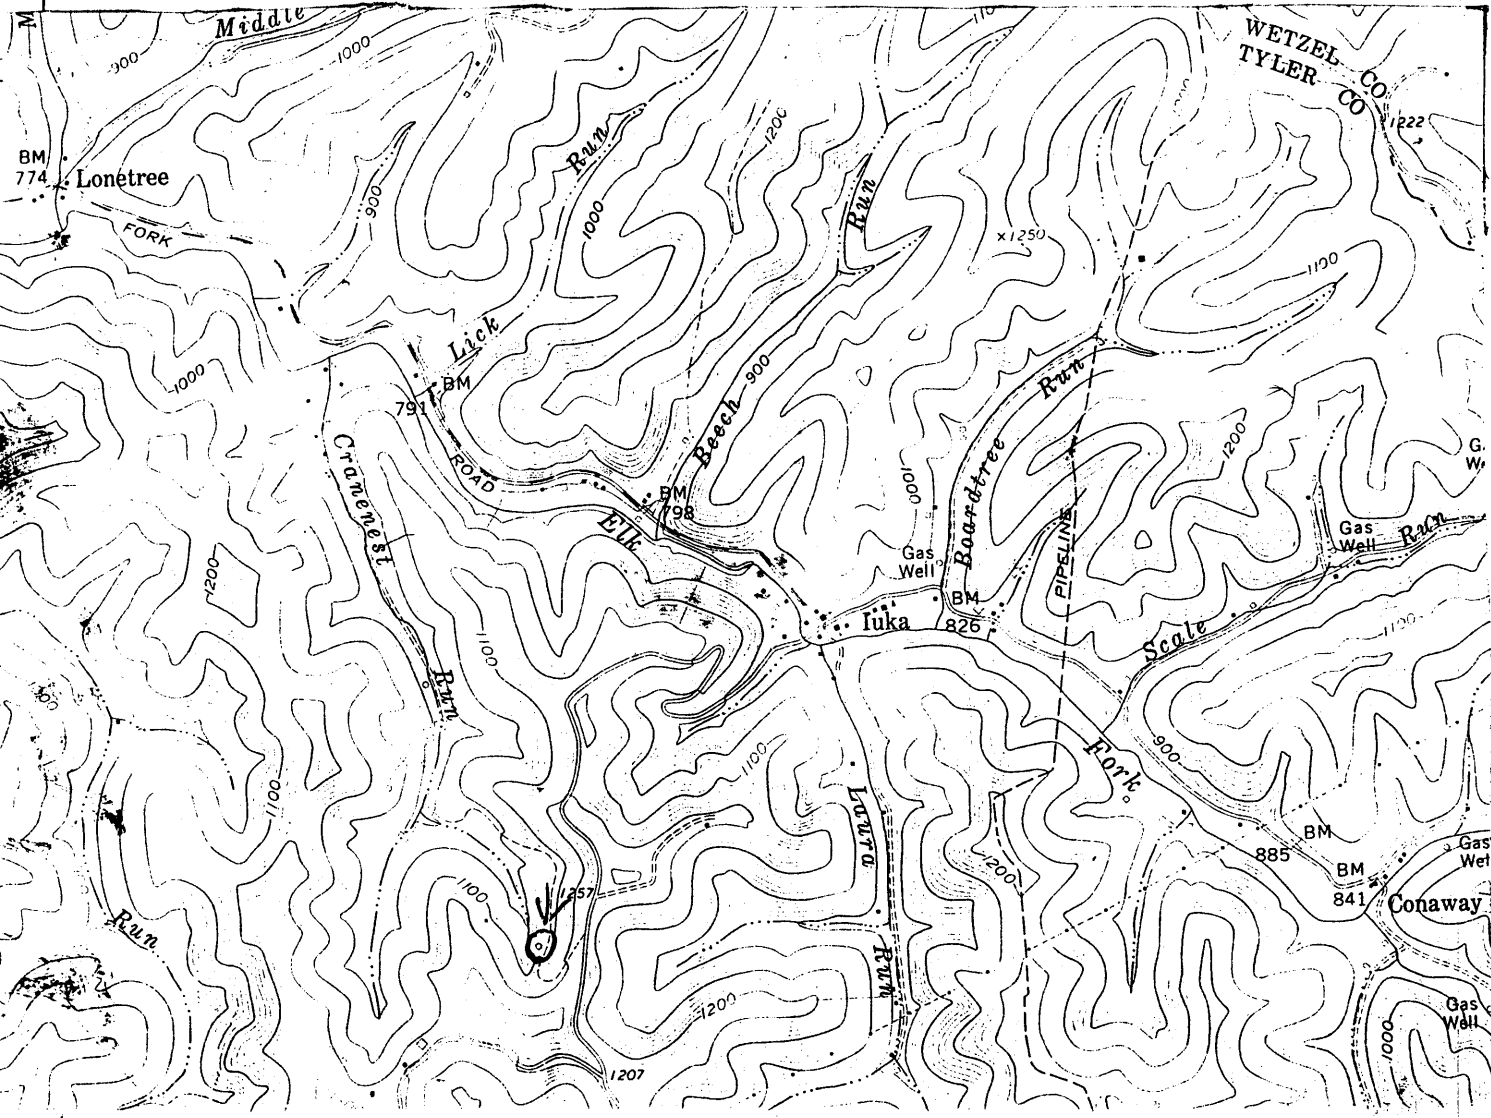

70 51 00 E 80 49 45

I, the undersigned, Hereby certify that this plat is correct to the best of my knowledge and belief.

SIGNED \_\_\_\_\_

TITLE Owner

DATE 5/24, 1970

OPERATORS WELL NO. #2 MYERS

API WELL NO. 095-1451

STATE OF WEST VIRGINIA  
DEPARTMENT OF ENERGY  
OIL AND GAS DIVISION

WELL TYPE: OIL  GAS  LIQUID INJECTION \_\_\_\_\_ WASTE DISPOSAL \_\_\_\_\_  
(ie. "GAS" PRODUCTION  STORAGE \_\_\_\_\_ DEEP \_\_\_\_\_ SHALLOW

LOCATION: ELEVATION \_\_\_\_\_ WATER SHED ELK FORK  
DISTRICT ELLSWORTH COUNTY TYLER  
QUADRANGLE PORTERS FALLS

SURFACE OWNER WALTER MYERS ACREAGE 69

OIL & GAS ROYALTY OWNER WALTER MYERS LEASE ACREAGE \_\_\_\_\_  
LEASE NO. \_\_\_\_\_

PRODUCING FORMATION Big INJUN TOTAL DEPTH 2,180

WELL OPERATOR Edna Conkey 4192 DESIGNATED AGENT \_\_\_\_\_

ADDRESS HCR 26360 Box 70 ADDRESS \_\_\_\_\_  
Leader W.Va.

11756