

LATITUDE

393230

804730

LONGITUDE

75' loc — 0

2.35
0.10

7'5' ~~0.15~~ topo location

7.5' loc _____

15' loc 5.235
(calc.) 2.32W

Company _____

Farm _____

LOCATION MAP

Quad Porters Falls / New Martinsville SE


County _____

District Ellsworth

WELL LOCATION MAP

File No. 095 1453

INSTRUCTIONS

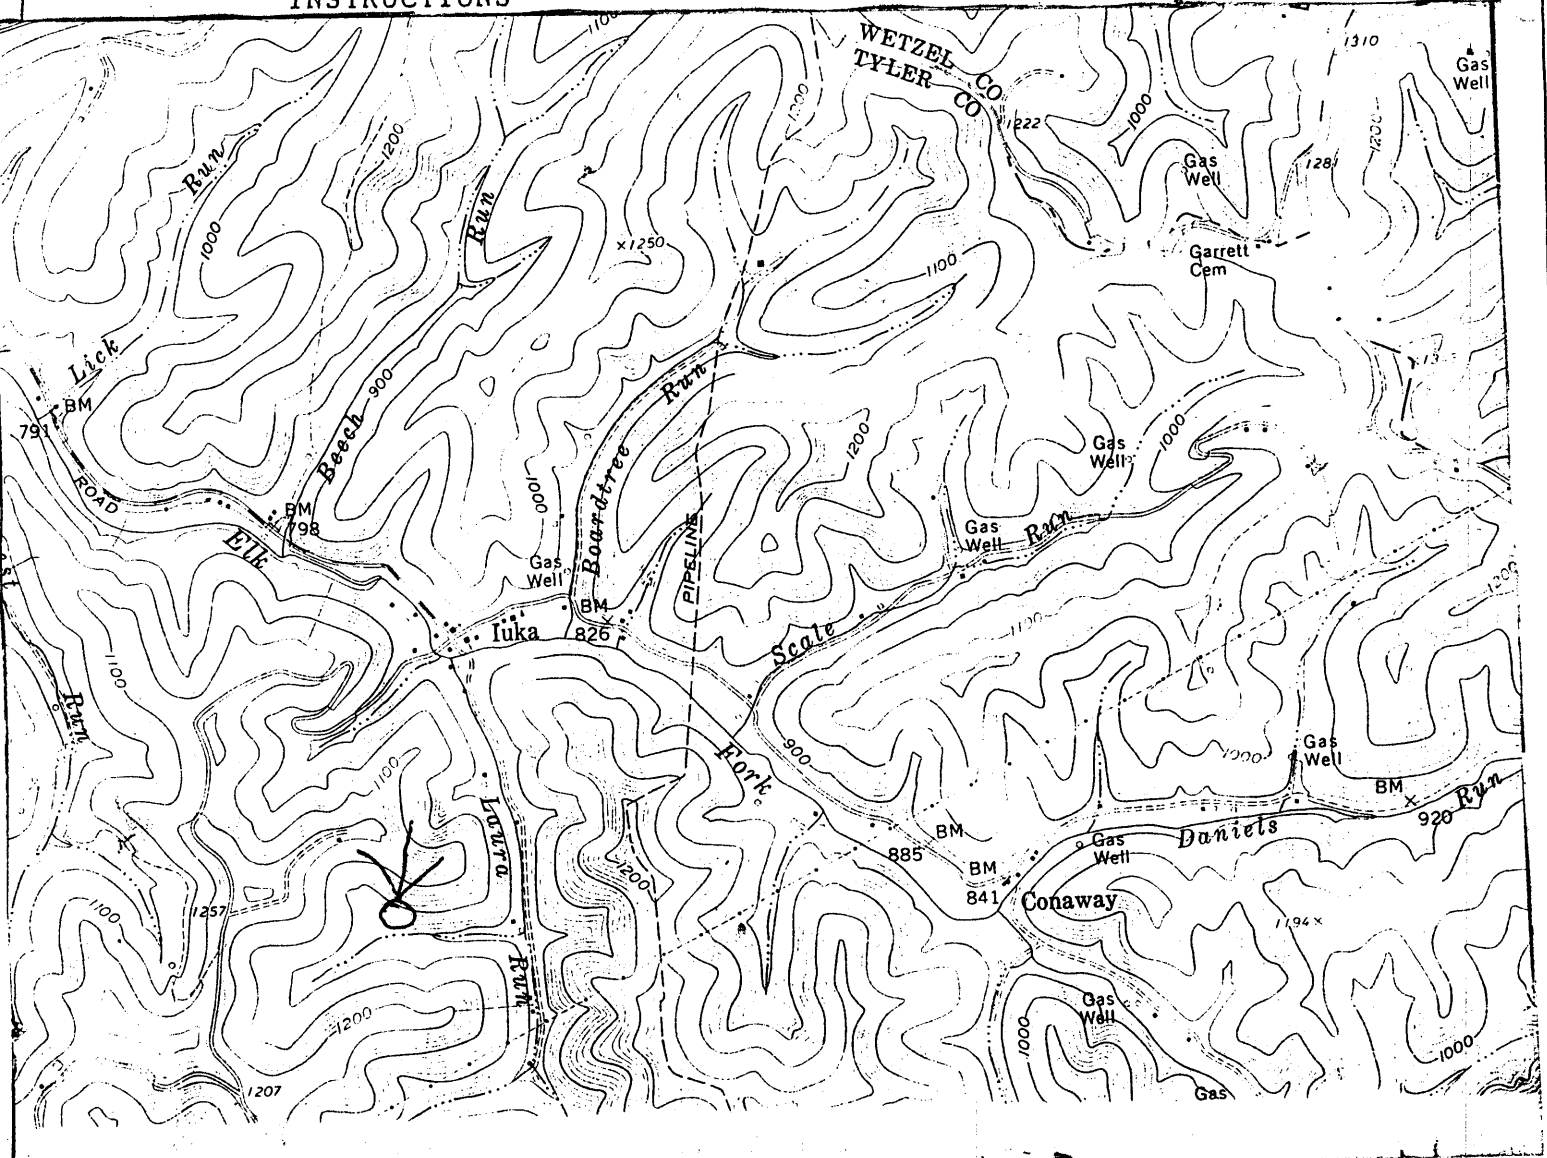

LONGITUDE 80 43 25

I, the undersigned, Hereby certify that this plat is correct to the best of my knowledge and belief.

SIGNED Edna Conkey

TITLE OWNER

DATE 5/24, 1990

OPERATORS WELL NO. #1 STEPHAN'S

API WELL NO. 095-1453

STATE OF WEST VIRGINIA
DEPARTMENT OF ENERGY
OIL AND GAS DIVISION

WELL TYPE: OIL GAS LIQUID INJECTION WASTE DISPOSAL
(IF "GAS" PRODUCTION NO MCF STORAGE DEEP SHALLOW

LOCATION: ELEVATION _____ WATER SHED ELK FORK
DISTRICT ELLSWORTH COUNTY TYLER
QUADRANGLE PORTERS FALLS

SURFACE OWNER C. A. Wade ACREAGE 86 1/2

OIL & GAS ROYALTY OWNER _____ LEASE ACREAGE 86 1/2
LEASE NO. L-2936

PRODUCING FORMATION Gordon TOTAL DEPTH 2960

WELL OPERATOR Edna Conkey 4192 DESIGNATED AGENT _____

ADDRESS HCF 26360 Box 70 ADDRESS _____

Reader W.Va.

11758