


FILE NO. \_\_\_\_\_  
 DRAWING NO. \_\_\_\_\_  
 SCALE 1" = 800'  
 MINIMUM DEGREE OF ACCURACY 1/200  
 PROVEN SOURCE OF ELEVATION API 47-095-0742  
 ELEV. 842

I THE UNDERSIGNED, HEREBY CERTIFY THAT THIS PLAT IS CORRECT TO THE BEST OF MY KNOWLEDGE AND BELIEF AND SHOWS ALL THE INFORMATION REQUIRED BY LAW AND THE REGULATIONS ISSUED AND PRESCRIBED BY THE DEPARTMENT OF MINES.

(SIGNED) Curtis A Lucas  
 R.P.E. \_\_\_\_\_ L.L.S. 275

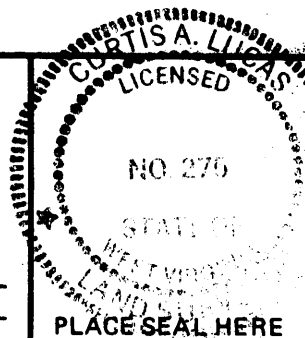

(+) DENOTES LOCATION OF WELL ON UNITED STATES TOPOGRAPHIC MAPS

FORM IV-6 (8-78)



DATE MARCH 15, 1993  
 OPERATOR'S WELL NO. 1  
 API WELL NO. 47-095-1494-P  
 STATE COUNTY PERMIT

STATE OF WEST VIRGINIA  
 DEPARTMENT OF MINES  
 OIL AND GAS DIVISION

WELL TYPE: OIL \_\_\_ GAS \_\_\_ LIQUID INJECTION \_\_\_ WASTE DISPOSAL \_\_\_  
 (IF "GAS,") PRODUCTION \_\_\_ STORAGE \_\_\_ DEEP \_\_\_ SHALLOW \_\_\_  
 LOCATION: ELEVATION 862 WATER SHED SANCHO CREEK  
 DISTRICT CENTERVILLE COUNTY TYLER  
 QUADRANGLE MIDDLE BOURNE West Union C  
 SURFACE OWNER LESTER LOUGH ACREAGE 149  
 OIL & GAS ROYALTY OWNER \_\_\_\_\_ LEASE ACREAGE \_\_\_\_\_  
 LEASE NO. \_\_\_\_\_  
 PROPOSED WORK: DRILL \_\_\_ CONVERT \_\_\_ DRILL DEEPER \_\_\_ REDRILL \_\_\_ FRACTURE OR  
 STIMULATE \_\_\_ PLUG OFF OLD FORMATION \_\_\_ PERFORATE NEW  
 FORMATION \_\_\_ OTHER PHYSICAL CHANGE IN WELL (SPECIFY) \_\_\_\_\_

MAY 07 1993

PLUG AND ABANDON  CLEAN OUT AND REPLUG \_\_\_  
 TARGET FORMATION \_\_\_\_\_ ESTIMATED DEPTH \_\_\_\_\_  
 WELL OPERATOR HYDROCARBON WELL SERVICE DESIGNATED AGENT ALVIN SORGAN  
 ADDRESS P O DRAWER 976 ADDRESS P O DRAWER 976  
BUCKHANNON WV 26201 BUCKHANNON WV 26201

STATE OF WEST VIRGINIA  
DEPARTMENT OF ENERGY  
DIVISION OF OIL AND GAS

AFFIDAVIT OF PLUGGING AND FILLING WELL

AFFIDAVITE SHOULD BE IN TRIPLICATE, one copy mailed to the Division, one copy to be retained by the Well Operator and the third copy (and extra copies if required) should be mailed to each coal operator at their respective addresses.

Farm name: Lester Lough Operator Well No.: #1

LOCATION: Elevation: 862.00 Quadrangle: Middlebourne  
 District: Meade County: Tyler  
 Latitude: 11650 Feet South of 39 Deg. 25 Min. 0 Sec.  
 Longitude 8600 Feet West of 80 Deg. 52 Min. 30 Sec.

Well type: OIL \_\_\_\_\_ GAS \_\_\_\_\_

Company: WV Division of Environmental Protection Coal Operator \_\_\_\_\_  
10 McJunkin Road or Owner \_\_\_\_\_  
Nitro WV 25143-2506

Agent: \_\_\_\_\_ Coal Operator \_\_\_\_\_  
 Inspector: Mike Underwood or Owner \_\_\_\_\_  
 Permit Issued: \_\_\_\_\_  
 5/3/93

AFFIDAVIT

STATE OF WEST VIRGINIA,  
County of Upshur ss:


Delbert Fisher and Alvin Sorcan being first duly sworn according to law depose and say that they are experienced in the work of plugging and filling oil and gas wells and were employed by WV Division of Environmental Protection, well operator, and participated in the work of plugging and filling the above well, that said work was commenced on the 15 day of February, 1993, and that the well was plugged and filled in the following manner:

TYPE	FROM	TO	PIPE REMOVED	LEFT
cement	38	surface		

Description of monument: 7" casing 5 feet out of ground

and that the work of plugging and filling said well was completed on the 17 day of February, 1993.

And furthur deponents saith not. Delbert Fisher  
Alvin Sorcan  
 Sworn and subscribe before me this 24 day of February, 1993  
 My commission expires: June 16, 1993

 OFFICIAL SEAL  
 NOTARY PUBLIC  
 STATE OF WEST VIRGINIA  
 Joyce K. Harlow  
 Smith 1, Box 217-B, French Creek, 26214