

STATE OF WEST VIRGINIA
DIVISION OF ENVIRONMENTAL PROTECTION
SECTION OF OIL AND GAS

WELL REGISTER ASSIGNMENT

This API Number 47- 95-01567, issued to WALTERS, CARL E/JERRY L/DOROT is evidence of permission to operate the well that is referenced at the location described on the attached plat, subject to the provisions of Chapters 22 and 22B of the West Virginia Code of 1931, as amended, and all rules and regulations promulgated thereunder. The name and telephone number of the Oil and Gas Inspector for this well is MIKE UNDERWOOD - 304-782-1043.

Spills or emergency discharges must be reported to 1-800-654-3312.

Failure to abide by all statutory and regulatory provisions governing all duties and operations hereunder may result in suspension or revocation of your permits and in addition may result in civil and/or criminal penalties.

The enclosed WR-35 must be completed by you and returned to this office. In addition annual production reports must be submitted on this well and failure to do so may require you to plug the well.

Theodore M. Streit
Chief

By: 


Title: _____

Operator's Well No: W.E. ASH #1

Farm Name: WRIGHT, H.R. HEIRS

API Well Number : 47- 95-01567 N

Date Issued : 01/03/94

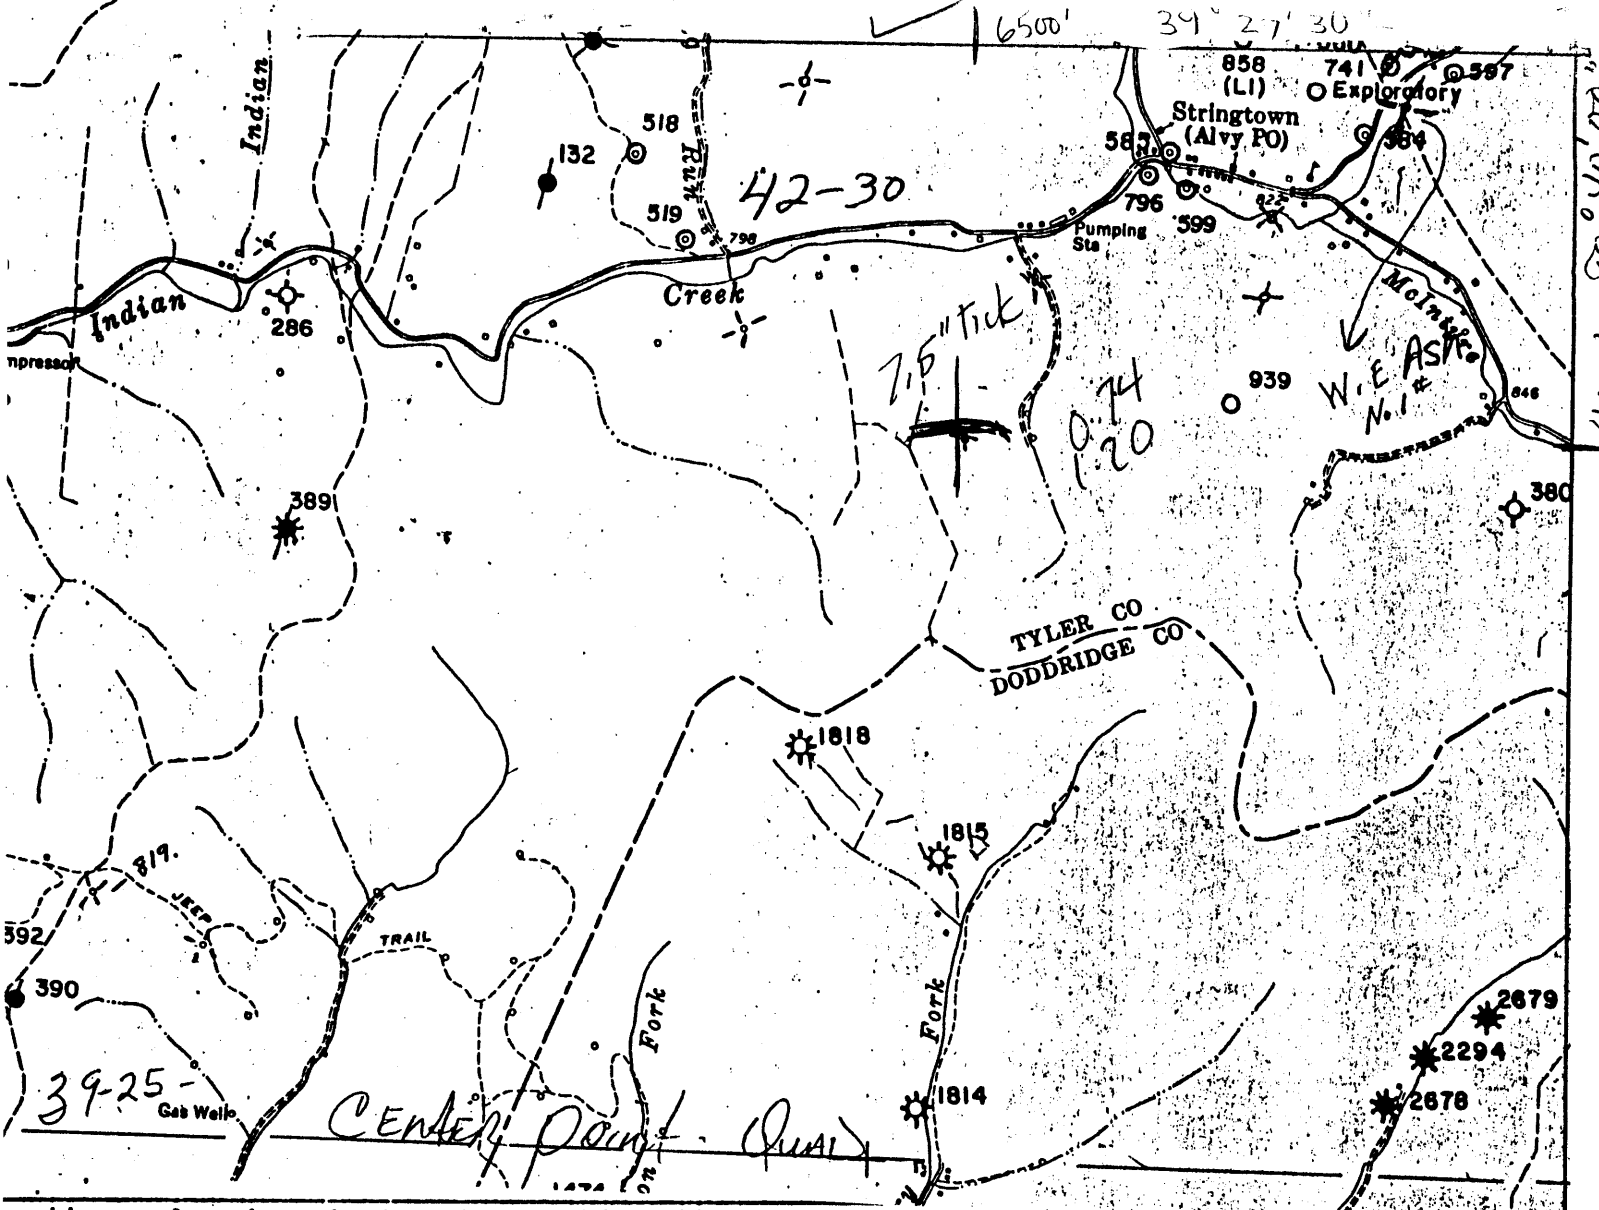

I, the undersigned, hereby certify that this plat is correct to the best of my knowledge and belief.

3.625 } calc 15'
1.20W } loc.

SIGNED Carl E. Walters

TITLE Partner & Agent

DATE August 12, 19 93

OPERATORS WELL NO. 1

API WELL NO. 095-1567-N

17892
AUG 27 93
Permitting
Office of Oil & Gas

STATE OF WEST VIRGINIA
DEPARTMENT OF ENERGY
OIL AND GAS DIVISION

WELL TYPE: OIL X GAS _____ LIQUID INJECTION _____ WASTE DISPOSAL _____
TYPE "GAS" PRODUCTION _____ STORAGE _____ DEEP _____ SHALLOW _____

LOCATION: ELEVATION 825 WATER SHED Indian Creek
DISTRICT McElroy COUNTY Tyler
QUADRANGLE CENTER POINT 286 + 15' NW

SURFACE OWNER H.R. Wright Heirs ACREAGE _____

OIL & GAS ROYALTY OWNER Pennzoil, H.R. Wright Heirs LEASE ACREAGE 1/2
LEASE NO. _____

PRODUCING FORMATION Gordon TOTAL DEPTH 2696

WELL OPERATOR Carl E. Jerry L. & Dorothy Walters DESIGNATED AGENT Carl E. Walters

ADDRESS HC 62 Box 81B ADDRESS HC 62 Box 81B

Alvy, WV. 26322

Alvy, WV. 26322

741-1567-N