

I, the undersigned, hereby certify that this plat is correct to the best of my knowledge and belief.

SIGNED Lowell P BEE  
 TITLE President

**RECEIVED**  
 WV Division of  
 Environmental Protection

OCT 0 8 93

DATE August 2, 19 93

Permitting  
 Office of Oil & Gas

OPERATORS WELL NO. # 644

API WELL NO. 095-1580-D

⊗ WELL SITE

18130

STATE OF WEST VIRGINIA  
 DEPARTMENT OF ENERGY  
 OIL AND GAS DIVISION

TYPE: OIL  GAS  LIQUID INJECTION  WASTE DISPOSAL   
 AS" PRODUCTION  STORAGE  DEEP  SHALLOW

LN: ELEVATION 875 WATER SHED Big Run  
 DISTRICT McELROY COUNTY FYLER  
 QUADRANGLE SHIRLEY 601 West Union NE

SURFACE OWNER GARY NICHOLS ACREAGE 143

OIL & GAS ROYALTY OWNER \_\_\_\_\_ LEASE ACREAGE 143  
 LEASE NO. L-2958 (1900)

PRODUCING FORMATION Big Lime TOTAL DEPTH 1748


WELL OPERATOR BEECHLICK OIL, INC. DESIGNATED AGENT Lowell P BEE

ADDRESS RT 3 BOX 26 ADDRESS RT 3 BOX 62

SALEM, WV 26426 SALEM, WV 26426

304-782-3963

Section 2

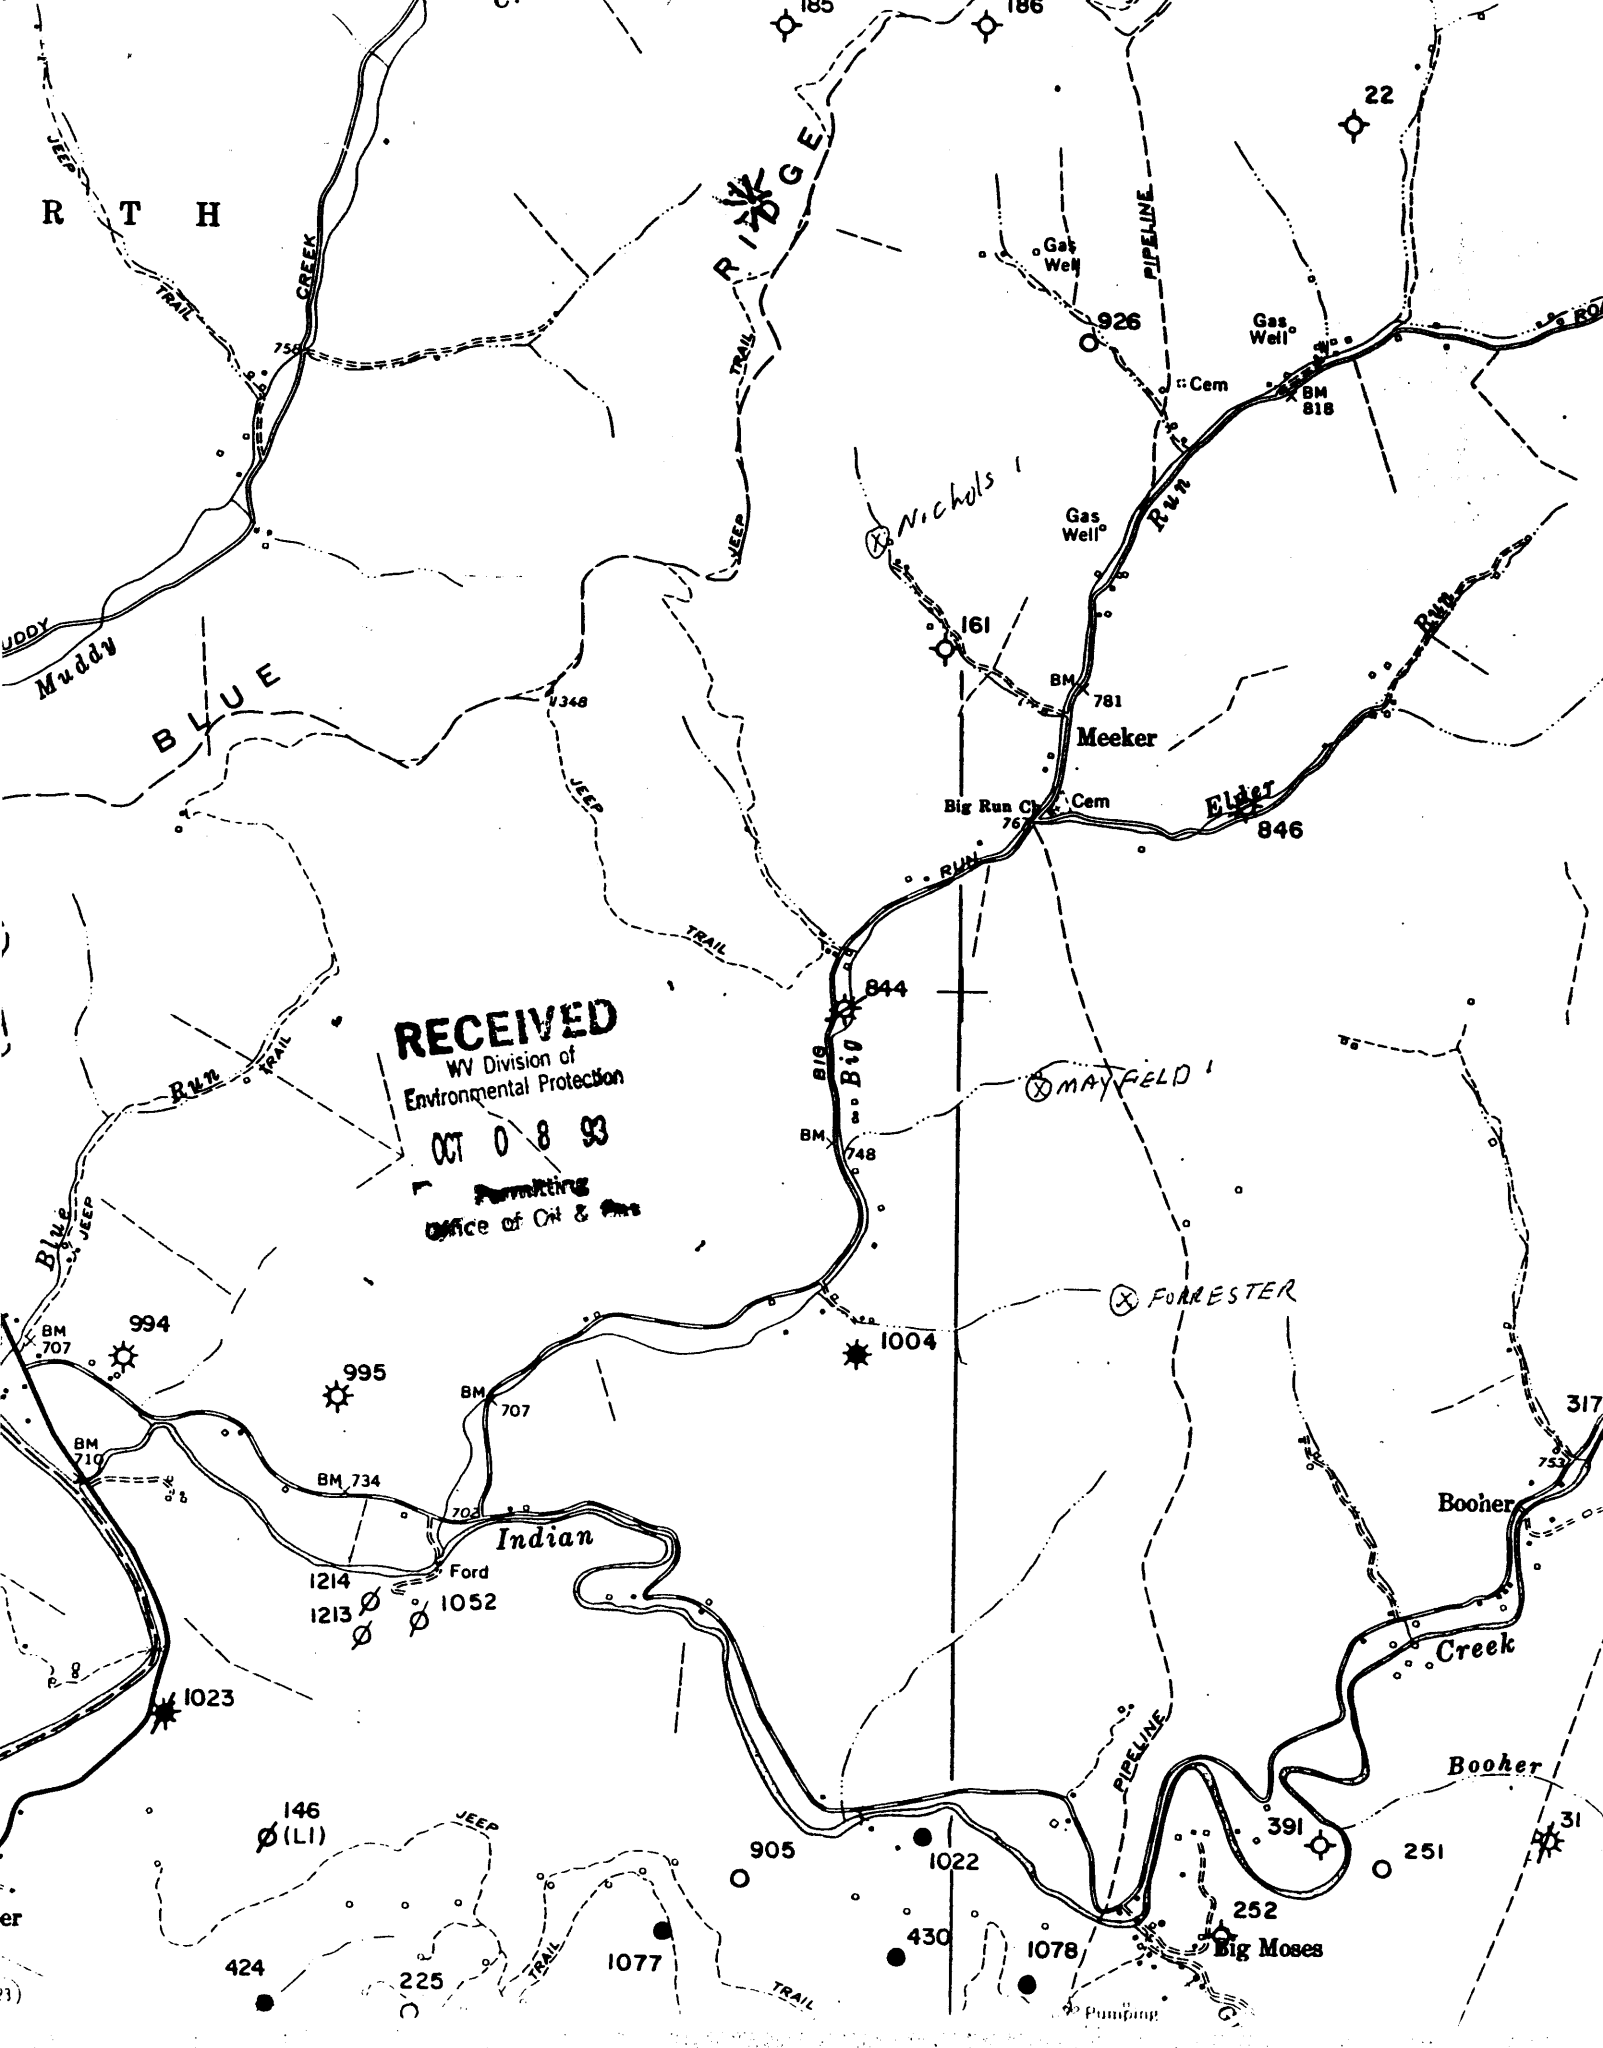

STATE OF WEST VIRGINIA  
DIVISION OF ENVIRONMENTAL PROTECTION  
SECTION OF OIL AND GAS

WELL REGISTER ASSIGNMENT

This API Number 47- 95-01580, issued to BEECHLICK OIL, INC. is evidence of permission to operate the well that is referenced at the location described on the attached plat, subject to the provisions of Chapters 22 and 22B of the West Virginia Code of 1931, as amended, and all rules and regulations promulgated thereunder. The name and telephone number of the Oil and Gas Inspector for this well is MIKE UNDERWOOD - 304-782-1043.

Spills or emergency discharges must be reported to 1-800-654-3312.

Failure to abide by all statutory and regulatory provisions governing all duties and operations hereunder may result in suspension or revocation of your permits and in addition may result in civil and/or criminal penalties.

The enclosed WR-35 must be completed by you and returned to this office. In addition annual production reports must be submitted on this well and failure to do so may require you to plug the well.

Theodore M. Streit  
Chief

By: 

Title: \_\_\_\_\_

Operator's Well No: NICHOLS #644

Farm Name: NICHOLS, GARY

API Well Number : 47- 95-01580 N

Date Issued : 02/07/94