

9501658A

WW-7
5-02

MAG
7/14/15

West Virginia Department of Environmental Protection
Office of Oil & Gas

WELL LOCATION FORM: GPS

API: 47- 095 - 1658 WELL NO: 6

FARM NAME: Joshua Haught No.6

RESPONSIBLE PARTY NAME: H.G. Energy, LLC

COUNTY: Tyler DISTRICT: McElroy

QUADRANGLE: Centerpoint 7.5'

SURFACE OWNER: David & Barbara Lemasters

ROYALTY OWNER: American Energy Partners, LLC et al.

UTM GPS NORTHING: 4,365,161 (NAD 83)

UTM GPS EASTING: 525,368 (NAD 83) GPS ELEVATION: 340 m. (1120')

The Responsible Party named above has chosen to submit GPS coordinates in lieu of preparing a new well location plat for a plugging permit on the above well. The Office of Oil & Gas will not accept GPS coordinates that do not meet the following requirements:

1. Datum: NAD 1983, Zone:17 North, Coordinate Units: meters, Altitude: height above mean sea level (MSL) - meters.
2. Accuracy to Datum - 3.05 meters
3. Data Collection Method:

Survey Grade GPS Post Processed Differential
 Real-Time Differential

Mapping Grade GPS Post Processed Differential
 Real-Time Differential

RECEIVED
Office of Oil and Gas

JUL 27 2015

I the undersigned, hereby certify this data is correct to the best of my knowledge and belief and shows all the information required by law and the regulations issued and prescribed by the Office of Oil and Gas. WV Department of Environmental Protection


Diane White Diane C. White
Signature

Designated Agent
Title

June 3, 2015
Date

08/07/2015

SUBJECT WELL
Joshua Haught No.6
47-095-1658

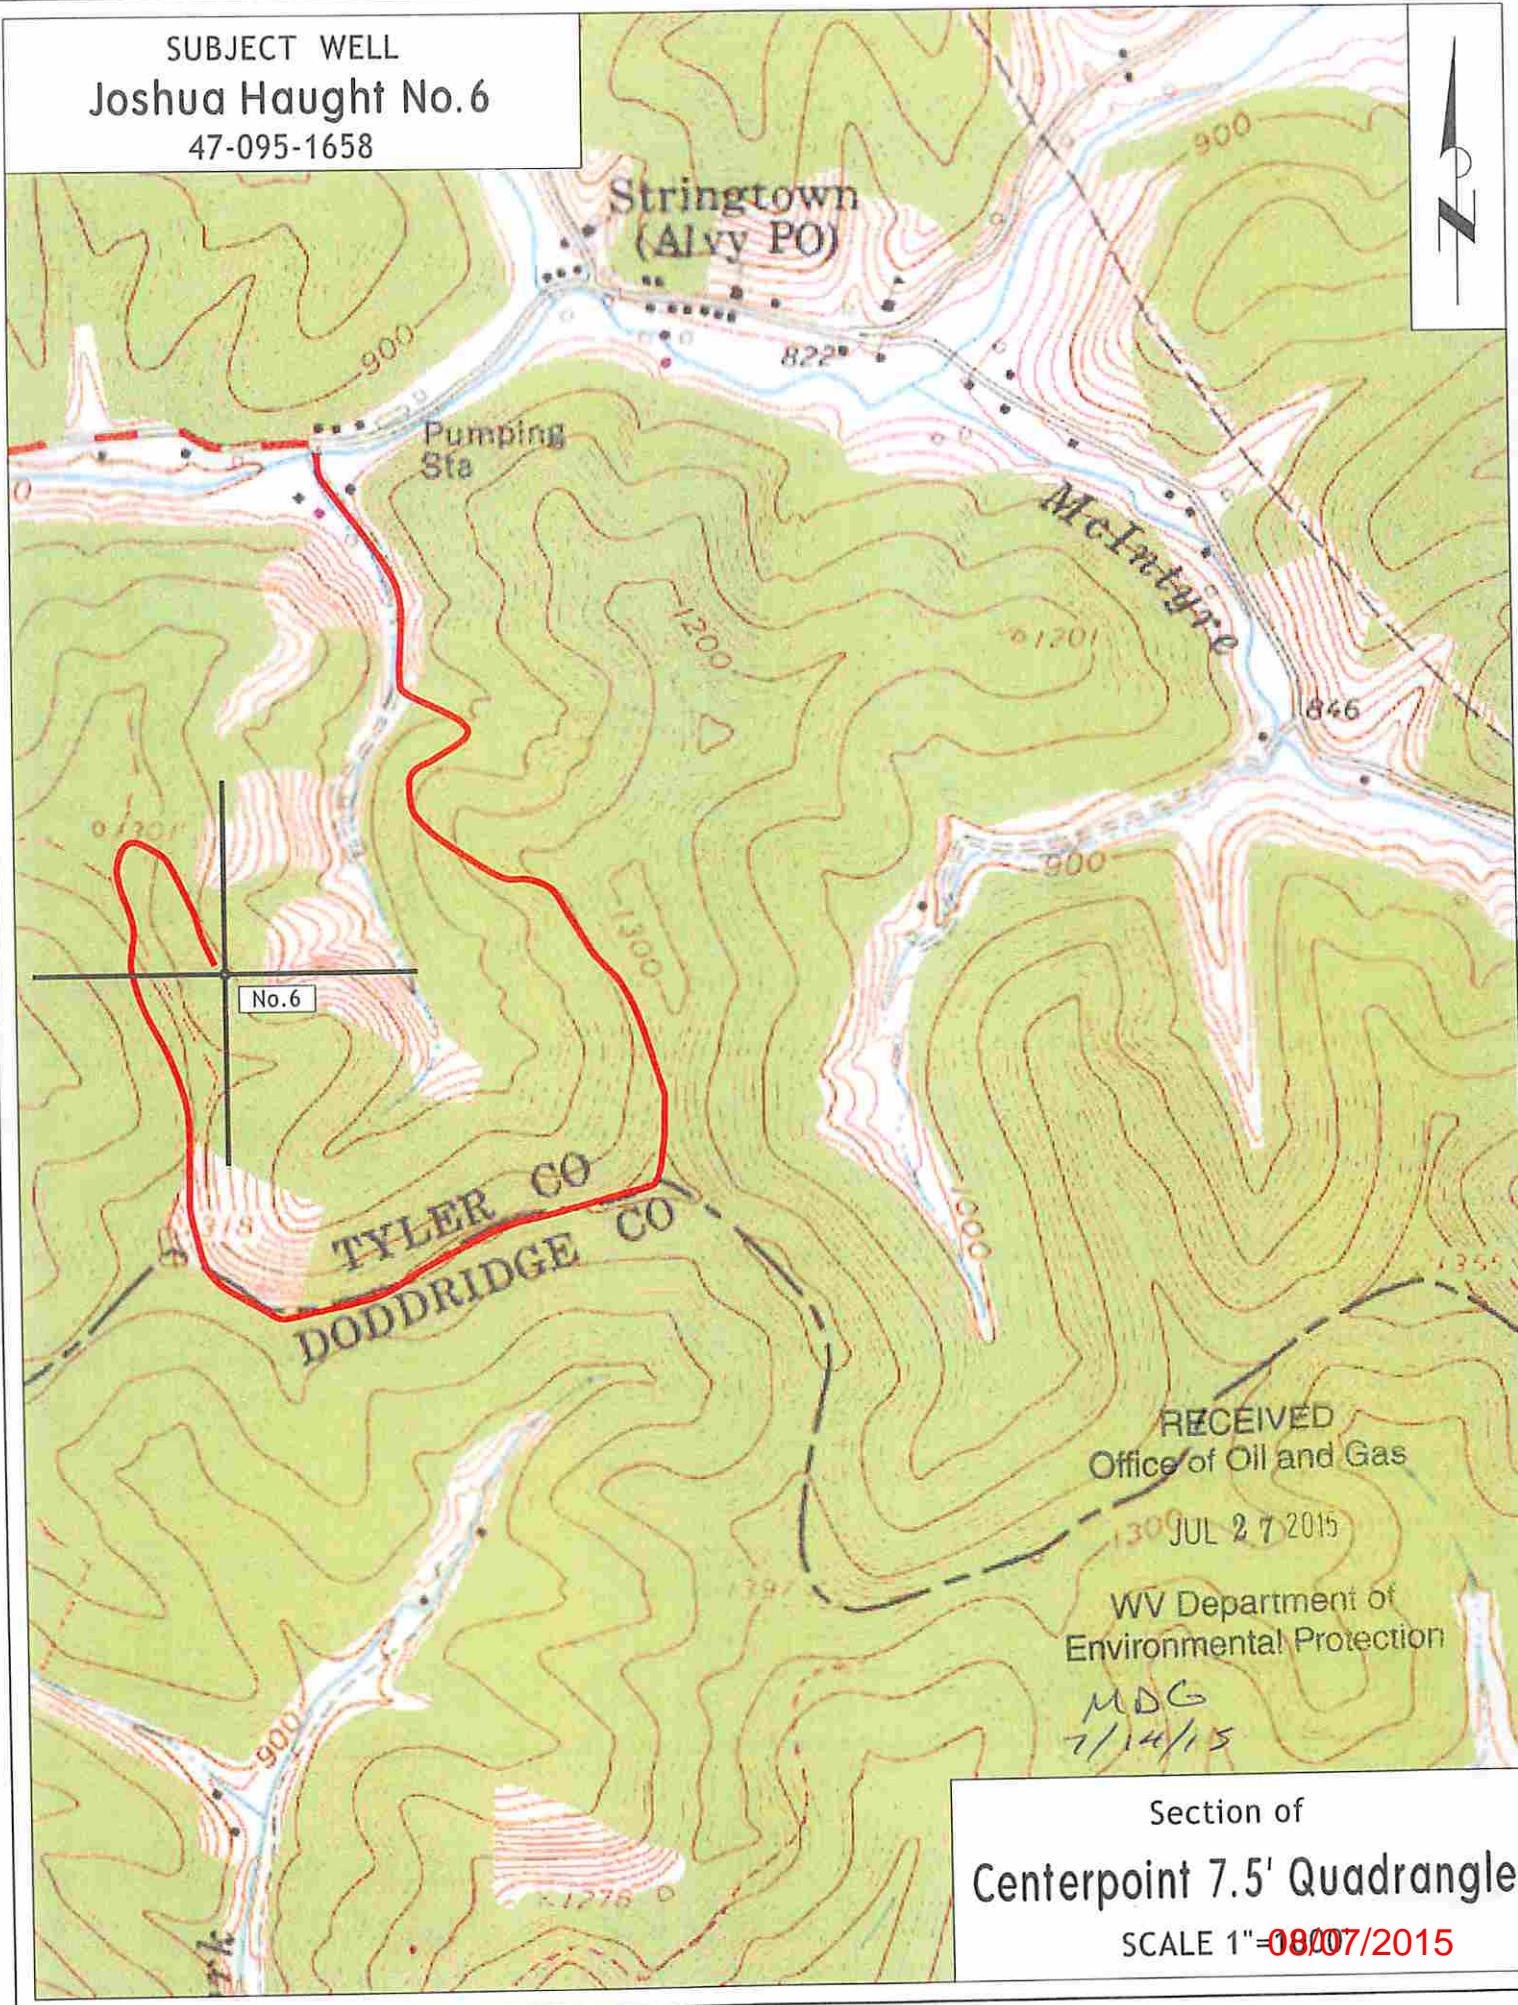

RECEIVED
Office of Oil and Gas

JUL 27 2015

WV Department of
Environmental Protection

MDC
7/14/15

Section of
Centerpoint 7.5' Quadrangle

SCALE 1" = 800'

08/07/2015