


RECEIVED
OFFICE OF OIL AND GAS
DEC 06 1996
WV Division of
Environmental Protection

23005

11,850'
"057'30" 8057'30"

I, the undersigned, hereby certify that this plat is correct to the best of my knowledge and belief.

SIGNED Loren E. Bagley
TITLE President

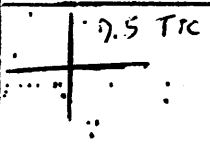

DATE 12/3, 1996
EPH Wells OPERATORS WELL NO. 36
API WELL NO. 095-1674-N

STATE OF WEST VIRGINIA
DEPARTMENT OF ENERGY
OIL AND GAS DIVISION

WELL TYPE: OIL GAS LIQUID INJECTION _____ WASTE DISPOSAL _____
(IE "GAS" PRODUCTION _____ STORAGE _____ DEEP _____ SHALLOW

LOCATION: ELEVATION 870 WATER SHED Ohio River
DISTRICT Lincoln COUNTY Tyler
QUADRANGLE Paden City

SURFACE OWNER Brent Rutherford ACREAGE _____

OIL & GAS ROYALTY OWNER EPH Wells Heirs LEASE ACREAGE 452
LEASE NO. _____

PRODUCING FORMATION Big Injun TOTAL DEPTH 1741

WELL OPERATOR Sancho Oil & Gas DESIGNATED AGENT Loren E. Bagley


ADDRESS P.O. Box 197 ADDRESS same
St. Marys, WV
26770

095-1634-2

13,360'

EPA Wells #36

1100'
4377
39° 32' 30"

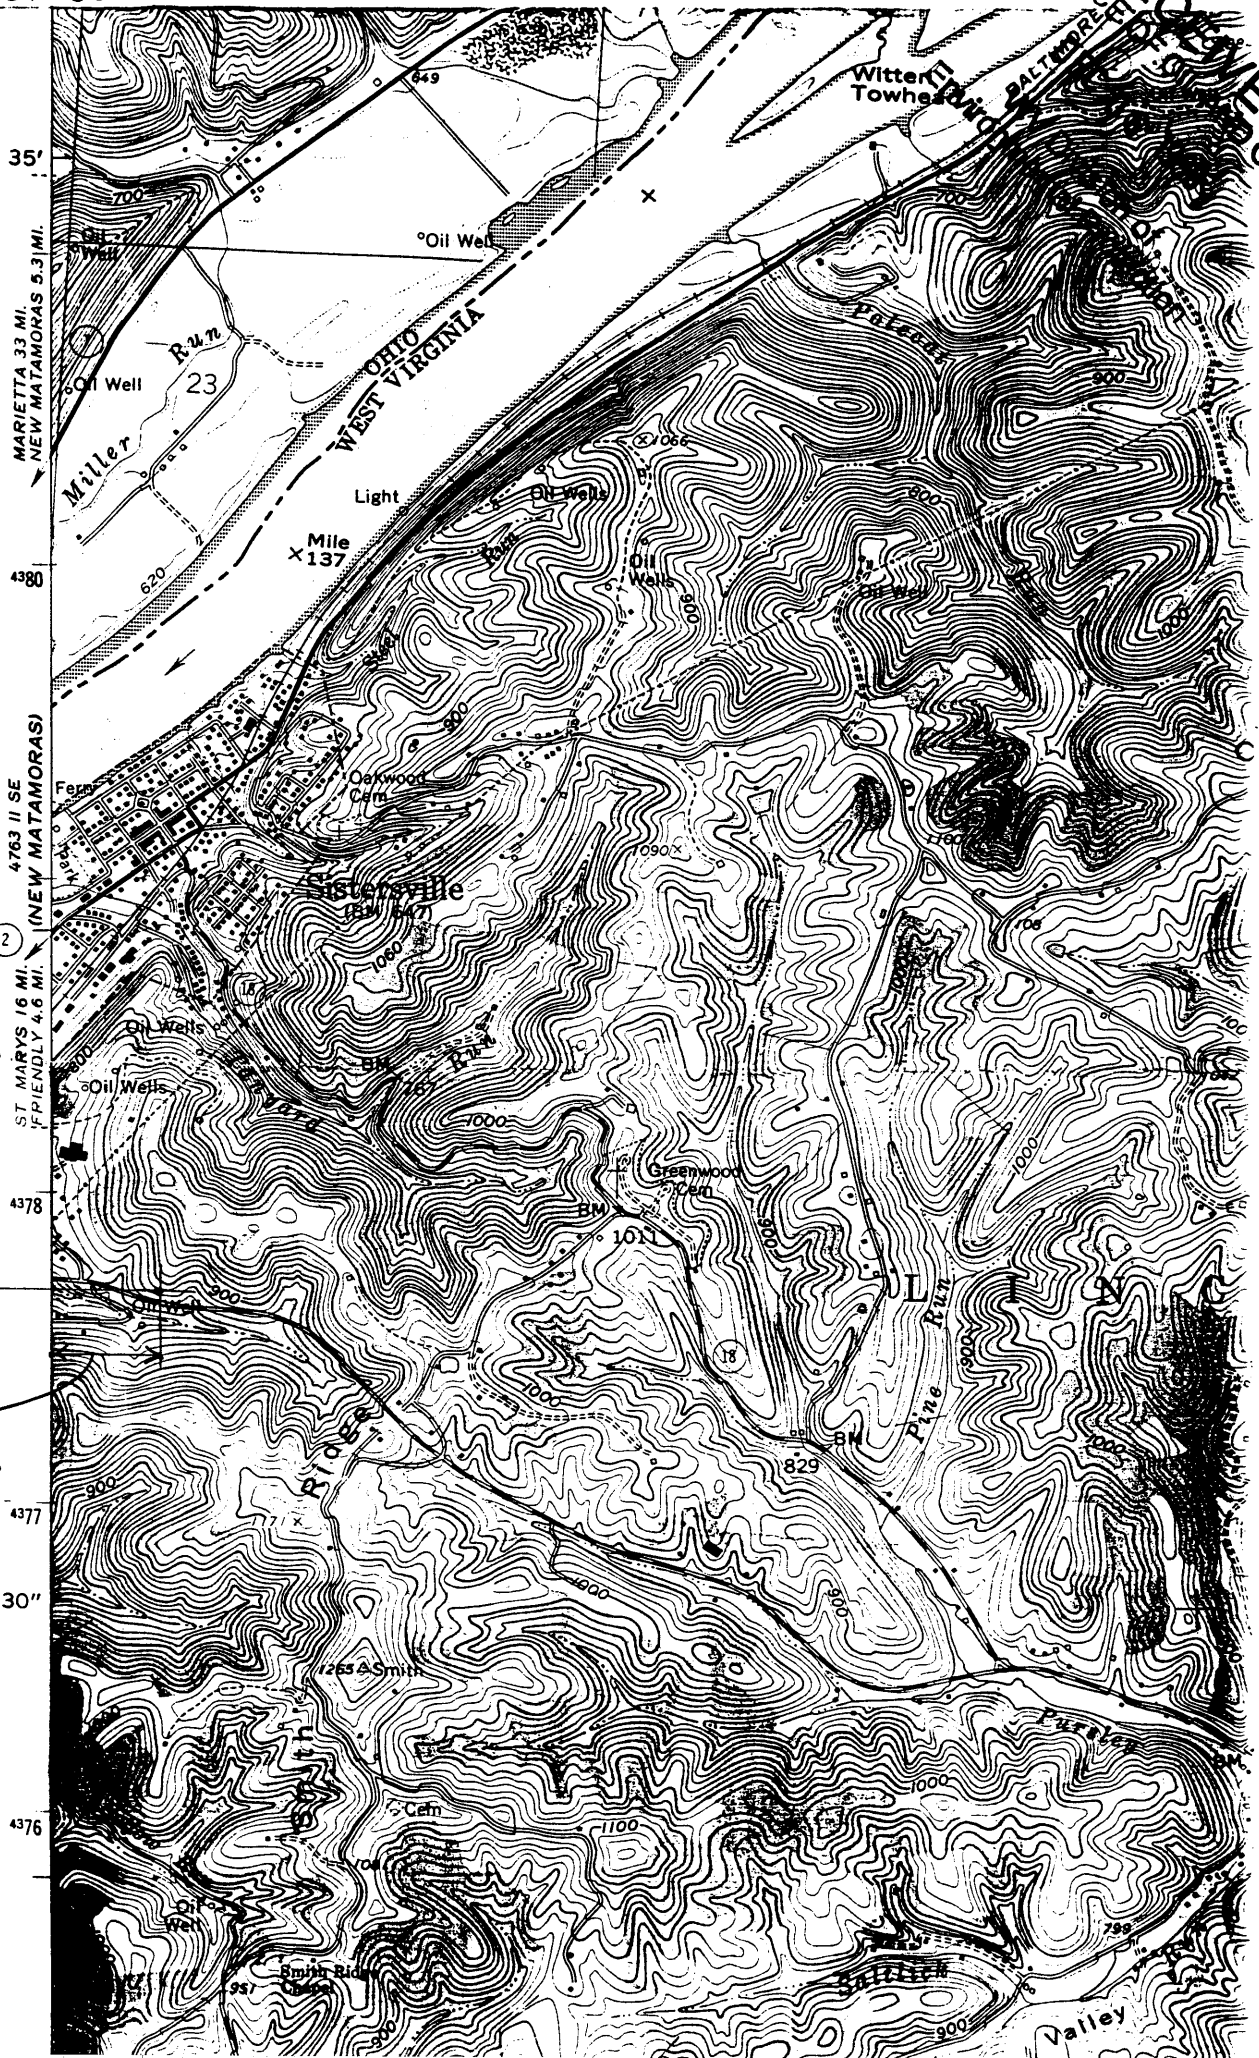

STATE OF WEST VIRGINIA
DIVISION OF ENVIRONMENTAL PROTECTION
SECTION OF OIL AND GAS

WELL REGISTER ASSIGNMENT

This API Number 47- 95-01674, issued to SANCHO OIL & GAS CORPORATION is evidence of permission to operate the well that is referenced at the location described on the attached plat, subject to the provisions of Chapters 22 and 22B of the West Virginia Code of 1931, as amended, and all rules and regulations promulgated thereunder. The name and telephone number of the Oil and Gas Inspector for this well is MIKE UNDERWOOD -
304-288-4604.

Spills or emergency discharges must be reported to 1-800-654-3312.

Failure to abide by all statutory and regulatory provisions governing all duties and operations hereunder may result in suspension or revocation of your permits and in addition may result in civil and/or criminal penalties.

The enclosed WR-35 must be completed by you and returned to this office. In addition annual production reports must be submitted on this well and failure to do so may require you to plug the well.

Theodore M. Streit
Chief

By: 

Title: _____

Operator's Well No: EPH WELLS #36

Farm Name: RUTHERFORD, BRENT

API Well Number : 47- 95-01674 N

Date Issued : 12/16/96