


(+) DENOTES LOCATION OF WELL ON UNITED STATES TOPOGRAPHIC MAPS

FILE NO. _____
 DRAWING NO. _____
 SCALE 1" = 500'
 MINIMUM DEGREE OF ACCURACY 1:200
 PROVEN SOURCE OF ELEVATION G.P.S. SURVEY

I THE UNDERSIGNED, HEREBY CERTIFY THAT THIS PLAT IS CORRECT TO THE BEST OF MY KNOWLEDGE AND BELIEF AND SHOWS ALL THE INFORMATION REQUIRED BY LAW AND THE REGULATIONS ISSUED AND PRESCRIBED BY THE DEPARTMENT OF ENERGY AND MINING (SIGNED) [Signature] R.P.E. _____ P.S. 551

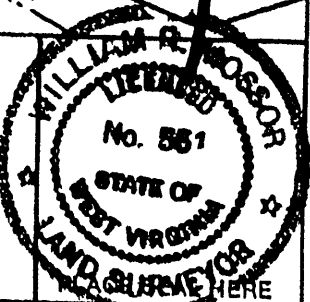

STATE OF WEST VIRGINIA
 DEPARTMENT OF ENERGY
 DIVISION OF OIL AND GAS



DATE 9 JUNE, 2003
 OPERATOR'S WELL NO. # 5
 API WELL NO. 47 095 01754

WELL TYPE: OIL GAS LIQUID INJECTION _____ WASTE DISPOSAL _____
 (IF "GAS,") PRODUCTION STORAGE _____ DEEP _____ SHALLOW
 LOCATION: ELEVATION 1040' WATER SHED MIDDLE ISLAND CREEK
 DISTRICT CENTERVILLE COUNTY TYLER
 QUADRANGLE SHIRLEY
 SURFACE OWNER RUTH MEREDITH ACREAGE 97.5
 OIL & GAS ROYALTY OWNER RUTH MEREDITH LEASE ACREAGE 100
 PROPOSED WORK: DRILL CONVERT _____ DRILL DEEPER _____ REDRILL _____ FRACTURE OR STIMULATE _____ PLUG OFF OLD FORMATION _____ PERFORATE NEW FORMATION _____ OTHER PHYSICAL CHANGE IN WELL (SPECIFY) _____

PLUG AND ABANDON _____ CLEAN OUT AND REPLUG _____
 TARGET FORMATION BENSON ESTIMATED DEPTH 5500'
 WELL OPERATOR SANCHO OEG DESIGNATED AGENT LOREN BAGLEY
 ADDRESS P.O. BOX 179 ADDRESS P.O. BOX 179
ST. MARYS, WV 26170 ST. MARYS, WV 26362

FORM WW-6

COUNTY NAME TYLER
 PERMIT 1754

(Beersville 366)

JUN 11 2003

State of West Virginia
Department of Environmental Protection
Office of Oil and Gas

MK

Well Operator's Report of Well Work

Farm name: Ruth Meredith Operator Well No.: 5

LOCATION: Elevation: 1040' Quadrangle: Middlebourne

District: Centerville County: Tyler
Latitude: Feet South of 39 Deg. 24 Min. 01.5 Sec.
Longitude: Feet West of 80 Deg. 51 Min. 44.1 Sec.

Company: Sancho O & G Corp

	Casing & Tubing	Used in drilling	Left in well	Cement fill up Cu. Ft.
Address: <u>Box 179 St Mary's, WV 23170</u>				
Agent: <u>Loren E. Bagley</u>	<u>13 3/8"</u>	<u>43'</u>	<u>43'</u>	
Inspector: <u>Mike Underwood</u>				
Date Permit Issued: <u>7/30/2003</u>	<u>9 5/8"</u>	<u>325'</u>	<u>325'</u>	<u>110 SKS</u>
Date Well Work Commenced: <u>8/28/03</u>				
Date Well Work Completed: <u>9/9/03</u>	<u>7"</u>	<u>2228'</u>	<u>2228'</u>	<u>295 SKS</u>
Verbal Plugging:				
Date Permission granted on: <u>N/A</u>	<u>4 1/2"</u>	<u>5147'</u>	<u>5147'</u>	<u>80 SKS</u>
Rotary X Cable Rig				
Total Depth (feet): <u>5180'</u>				
Fresh Water Depth (ft.):				
Salt Water Depth (ft.): <u>1540'</u>				
Is coal being mined in area (N/Y)? <u>N</u>				
Coal Depths (ft.):				

OPEN FLOW DATA

Producing formation Benson Pay zone depth (ft) 5010'
Gas: Initial open flow NA MCF/d Oil: Initial open flow NA Bbl/d
Final open flow 2380 MCF/d Oil: Final open flow NA Bbl/d
Time of open flow between initial and final tests NA Hours
Static rock Pressure 1700 psig (surface pressure) after 48 Hours

Second Producing formation Riley Pay zone depth (ft) 4625'
Gas: Initial open flow NA MCF/d Oil: Initial open flow NA Bbl/d
Final open flow co-mingled MCF/d Oil: Final open flow NA Bbl/d
Time of open flow between initial and final tests Hours
Static rock Pressure co-mingled psig (surface pressure) after Hours

NOTE: ON BACK OF THIS FORM PUT THE FOLLOWING: 1). DETAILS OF PERFORATED INTERVALS, FRACTURING OR STIMULATING, PHYSICAL CHANGE, ETC. 2). THE WELL LOG WHICH IS A SYSTEMATIC DETAILED GEOLOGICAL RECORD OF ALL FORMATIONS, INCLUDING COAL ENCOUNTERED BY THE WELLBORE.

Signed: *Neil M. Sullivan*
By: Neil M. Sullivan
Date: 10-1-03

RECEIVED
Office of Oil & Gas
Office of Chief
OCT 23 2003
WV Department of
Environmental Protection

TYL 1754

NOV 14 2003

9/09/03

Perfed Benson 5006'- 5012' (36 shots). BD 4400#. 50 sks 80/100, 350 sks 20/40, 97,000 SCFN2.
Perfed Riley 4600'- 4634' (90 shots). BD 4000#. 300 sks 20/40, 75 qual foam, 344,000 SCFN2.

ROCK DESCRIPTION	DEPTH
FILL	10
RED CLAY	22
BROWN SANDSTONE	27
SAND	34
SANDY SHALE	85
RED ROCK	90
SANDY SHALE	130
SAND	185
SANDY SHALE	215
RED ROCK	225
SAND	230
RED ROCK	240
SANDY SHALE	345
RED ROCK	360
SANDY SHALE	480
SAND	570
SANDY SHALE	570
SAND	600
SANDY SHALE	720
SAND	750
SANDY SHALE	830
RED ROCK	850
SAND	885
RED ROCK	910
SAND	930
SANDY SHALE	990
SAND	1020
SANDY SHALE	1170
SAND	1260
SANDY SHALE	1320
SAND	1410
SANDY SHALE	1440
SAND	1540
SANDY SHALE	1600
SAND	1880
LIME	1925
SHALE	1935
SAND	1955
SHALE	1968
SAND	2280
SANDY SHALE	2320
SAND	2430
SHALE	2460
SANDY SHALE	2520
SHALE	2700
SANDY SHALE	2850
SHALE	3000
SANDY SHALE	3090
SHALE	3150
SAND	3180
SHALE	3210
SANDY SHALE	3270
SHALE	3300
SAND	3330
SHALE	3360
SAND	3420
SHALE	3450
SAND	3480
SANDY SHALE	3540
SAND	3570
SANDY SHALE	3630
SHALE	3660
SANDY SHALE	3750
SHALE	3780
SANDY SHALE	3840
SHALE	3900
SANDY SHALE	4000
SHALE	4110
SANDY SHALE	4185
SHALE	4600
SANDY SHALE	4120
SHALE	1630
SANDY SHALE	5000
SAND	5020
SANDY SHALE	5180 TD