

7220'
LATITUDE 39° 25'


LAT. 39° 24' 10.7"
LONG. 80° 51' 32.1"

LONGITUDE 80° 50' 49.40'

(+) DENOTES LOCATION OF WELL ON UNITED STATES TOPOGRAPHIC MAPS

FILE NO. _____
DRAWING NO. _____
SCALE 1" = 1000'
MINIMUM DEGREE OF ACCURACY 1:200
PROVEN SOURCE OF ELEVATION G.P.S SURVEY

I THE UNDERSIGNED, HEREBY CERTIFY THAT THIS PLAT IS CORRECT TO THE BEST OF MY KNOWLEDGE AND BELIEF AND SHOWS ALL THE INFORMATION REQUIRED BY LAW AND THE REGULATIONS ISSUED AND PRESCRIBED BY THE DEPARTMENT OF ENERGY
(SIGNATURE) _____
R.P.E. _____ P.S. 551

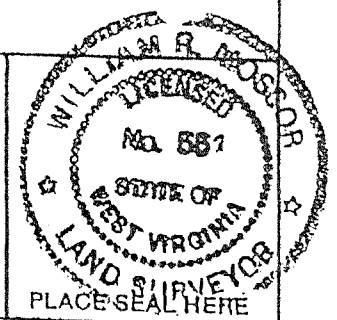

STATE OF WEST VIRGINIA
DEPARTMENT OF ENERGY
DIVISION OF OIL AND GAS



DATE 9 JUNE 20 03
OPERATOR'S WELL NO. # 3
API WELL NO. 47-095-01756

WELL TYPE: OIL GAS LIQUID INJECTION _____ WASTE DISPOSAL _____
(IF "GAS,") PRODUCTION STORAGE _____ DEEP _____ SHALLOW
LOCATION: ELEVATION 990 WATER SHED PURGATORY RUN
DISTRICT CENTERVILLE COUNTY TYLER
QUADRANGLE SHIRLEY
SURFACE OWNER RICHARD E. DEULLEY ACREAGE 113
OIL & GAS ROYALTY OWNER DENNIS L. SPENCER, JR LEASE ACREAGE 221
PROPOSED WORK: DRILL CONVERT _____ DRILL DEEPER _____ REDRILL _____ FRACTURE OR STIMULATE _____ PLUG OFF OLD FORMATION _____ PERFORATE NEW FORMATION _____ OTHER PHYSICAL CHANGE IN WELL (SPECIFY) _____

PLUG AND ABANDON _____ CLEAN OUT AND REPLUG _____
TARGET FORMATION BENSON ESTIMATED DEPTH 5500'
WELL OPERATOR SANCHO OIL & GAS DESIGNATED AGENT LAREN BAGLEY
ADDRESS P.O. BOX 179 ST. MARYS, WV 26170 ADDRESS P.O. BOX 179 ST. MARYS, WV 26170

COUNTY NAME TYLER
PERMIT 1756

State of West Virginia
Department of Environmental Protection
Office of Oil and Gas

Well Operator's Report of Well Work

RECEIVED
Office of Oil & Gas
Office of Chief
OCT 23 2003
WV Department of
Environmental Protection

Farm name: Dennis Spencer Operator Well No.: 3

LOCATION: Elevation: 990' Quadrangle: Middlebourne

District: Centerville County: Tyler
Latitude: Feet South of 39 Deg. 24 Min. 10.7 Sec.
Longitude: Feet West of 80 Deg. 51 Min. 32.1 Sec.

Company: Sancho O & G Corp

	Casing & Tubing	Used in drilling	Left in well	Cement fill up Cu. Ft.
Address: <u>Box 179 St Mary's, WV 23170</u>				
Agent: <u>Loren E. Bagley</u>	<u>13 3/8"</u>	<u>43'</u>	<u>43'</u>	
Inspector: <u>Mike Underwood</u>				
Date Permit Issued: <u>9/4/2003</u>	<u>9 5/8"</u>	<u>293'</u>	<u>293'</u>	<u>100 SKS</u>
Date Well Work Commenced: <u>9/12/03</u>				
Date Well Work Completed: <u>9/23/03</u>	<u>7"</u>	<u>2214'</u>	<u>2214'</u>	<u>295 SKS</u>
Verbal Plugging:				
Date Permission granted on: <u>N/A</u>	<u>4 1/2"</u>	<u>5063'</u>	<u>5063'</u>	<u>80 SKS</u>
Rotary X Cable Rig				
Total Depth (feet): <u>5130'</u>				
Fresh Water Depth (ft.):				
Salt Water Depth (ft.): <u>1825'</u>				
Is coal being mined in area (N/Y)? <u>N</u>				
Coal Depths (ft.):				

OPEN FLOW DATA

Producing formation Benson Pay zone depth (ft) 4950'
Gas: Initial open flow NA MCF/d Oil: Initial open flow NA Bbl/d
Final open flow 2100 MCF/d Oil: Final open flow NA Bbl/d
Time of open flow between initial and final tests NA Hours
Static rock Pressure 1850 psig (surface pressure) after 48 Hours

Second Producing formation Riley Pay zone depth (ft) 4560
Gas: Initial open flow NA MCF/d Oil: Initial open flow NA Bbl/d
Final open flow co-mingled MCF/d Oil: Final open flow NA Bbl/d
Time of open flow between initial and final tests NA Hours
Static rock Pressure co-mingled psig (surface pressure) after NA Hours

NOTE: ON BACK OF THIS FORM PUT THE FOLLOWING: 1). DETAILS OF PERFORATED INTERVALS, FRACTURING OR STIMULATING, PHYSICAL CHANGE, ETC. 2). THE WELL LOG WHICH IS A SYSTEMATIC DETAILED GEOLOGICAL RECORD OF ALL FORMATIONS, INCLUDING COAL ENCOUNTERED BY THE WELLBORE.

KPC

Signed: Neil M. Sullivan
By: Neil M. Sullivan
Date: 10-1-03

TYL 1756

NOV 14 2003

9/23/03

Perfed Benson: 4946'-4954' (48 shots). BD 3913#, 50 sks 80/100, 350 sks 20/40, 101,000 SCFN2, ISIP 1403#.

Perfed Riley: 4541'-4574' (112 shots), BD 3800#, 315 sks 20/40, 365,000 SCFN2, ISIP 2702#.

ROCK DESCRIPTION	DEPTH
CLAY	12
SHALE	27
SANDY SHALE	34
RED ROCK	40
SANDY SHALE	110
SHALE	200
SANDY SHALE	375
SAND/RED ROCK	500
SAND	800
RED ROCK	855
SAND	870
SANDY SHALE	900
SHALE	930
SANDY SHALE	1030
RED ROCK	1048
SANDY SHALE	1110
SAND	1200
SANDY SHALE	1260
SAND	1350
SANDY SHALE	1410
SAND	1530
SANDY SHALE	1560
SAND	1620
SANDY SHALE	1650
SAND	1710
SANDY SHALE	1740
SAND	1850
LIME	1925
SHALE	1945
SANDY SHALE	1956
SAND	1990
SAND	2030
SANDY SHALE	2310
SAND	2370
SANDY SHALE	2400
SAND	2580
SANDY SHALE	2610
SAND	2700
SANDY SHALE	2730
SAND	2760
SANDY SHALE	2890
SAND	2950
SANDY SHALE	3090
SAND	3180
SANDY SHALE	3300
SHALE	3330
SANDY SHALE	3390
SAND	3420
SANDY SHALE	3900
SHALE	4080
SAND	4140
SANDY SHALE	4170
SAND	4200
SANDY SHALE	4350
SHALE	4380
SAND	4410
SANDY SHALE	4550
SAND	4570
SANDY SHALE	4945
SAND	4970
SANDY SHALE	5130 TD