


4709501776P

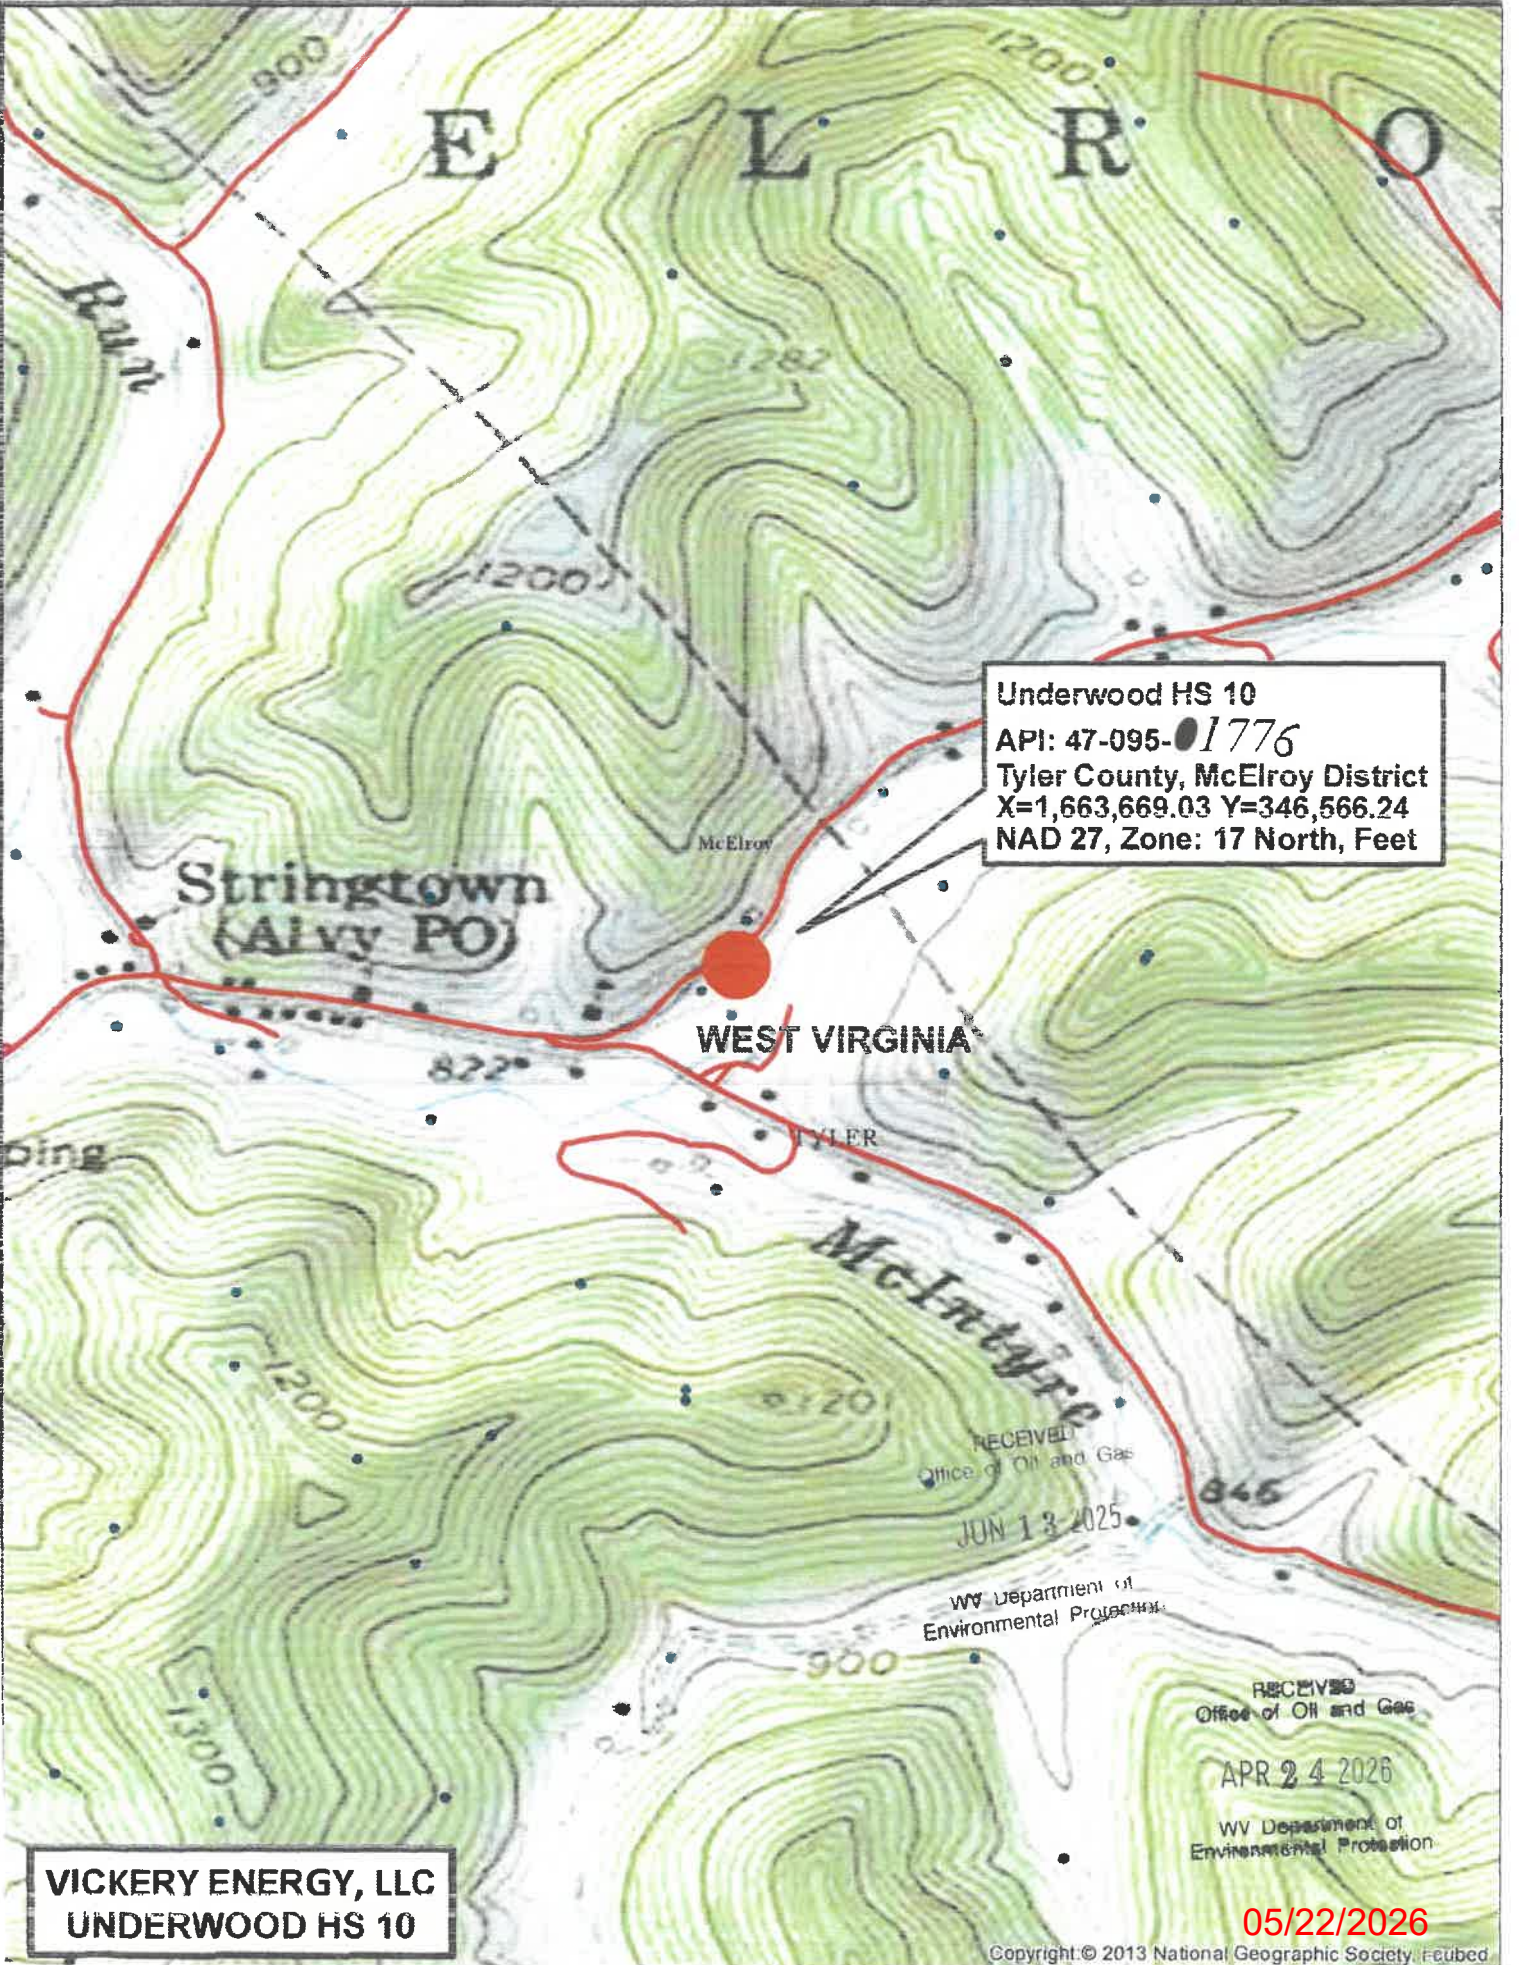

Underwood HS 10  
 API: 47-095-01776  
 Tyler County, McElroy District  
 X=1,663,669.03 Y=346,566.24  
 NAD 27, Zone: 17 North, Feet

**VICKERY ENERGY, LLC**  
**UNDERWOOD HS 10**

RECEIVED  
 Office of Oil and Gas  
 JUN 13 2025  
 WV Department of  
 Environmental Protection

RECEIVED  
 Office of Oil and Gas  
 APR 24 2026  
 WV Department of  
 Environmental Protection

05/22/2026

WW-7  
8-30-06



West Virginia Department of Environmental Protection  
Office of Oil and Gas

**WELL LOCATION FORM: GPS**

API: 47-095-01776 WELL NO.: 10

FARM NAME: Underwood

RESPONSIBLE PARTY NAME: Vickery Energy, LLC

COUNTY: Tyler DISTRICT: McElroy

QUADRANGLE: Centerpoint 7.5'

SURFACE OWNER: Jason Glover

ROYALTY OWNER: Stringtown Unit 3

UTM GPS NORTHING: 4366256.82

UTM GPS EASTING: 526606.45 GPS ELEVATION: 812'

The Responsible Party named above has chosen to submit GPS coordinates in lieu of preparing a new well location plat for a plugging permit or assigned API number on the above well. The Office of Oil and Gas will not accept GPS coordinates that do not meet the following requirements:

1. Datum: NAD 1983, Zone: 17 North, Coordinate Units: meters, Altitude: height above mean sea level (MSL) – meters.
2. Accuracy to Datum – 3.05 meters
3. Data Collection Method:

Survey grade GPS  : Post Processed Differential

Real-Time Differential

Mapping Grade GPS  : Post Processed Differential

Real-Time Differential

4. Letter size copy of the topography map showing the well location.

I the undersigned, hereby certify this data is correct to the best of my knowledge and belief and shows all the information required by law and the regulations issued and prescribed by the Office of Oil and Gas.

David Oliver  
Digitally signed by David Oliver  
Date: 2026.03.03 10:41:54  
-05'00'

Pipeline&Facility Administrator

3/3/2026

Signature

Title

Date

RECEIVED  
Office of Oil and Gas

APR 24 2026

WV Department of  
Environmental Protection

05/22/2026