


West Virginia Department of Environmental Protection Office of Oil and Gas

WELL LOCATION FORM: GPS


API: 47-095-01847	WELL NO.: 1	6
FARM NAME: McIntyre, E		
RESPONSIBLE PARTY NAME:	Harman Brown	
COUNTY: Tyler	DISTRICT: MC	Elroy
QUADRANGLE: Centerpoi	nt 7.5'	
SURFACE OWNER: Glover	& Coastal Lumber	
ROYALTY OWNER: Stringto	own Unit 3	
UTM GPS NORTHING: 43641	40.27	
UTM GPS EASTING: 526466	.44 GPS ELEVAT	_{ION:} 1339'
height above mean sea let 2. Accuracy to Datum – 3.0 3. Data Collection Method:	: 17 North, Coordinate Units; movel (MSL) – meters. 5 meters	
Survey grade GPS: Post Processed Differential		MAR 2 2 2024
Mapping Grade GPS X : Post Processed Differential		WV Department of Environmental Protection
	I-Time Differential	
4. Letter size copy of the to I the undersigned, hereby certify this belief and shows all the information prescribed by the Office of Oil and O David Oliver Dignally signed by David Oliver Date: 2024.02.29 14:18.26	required by law and the regulations.	knowledge and ons issued and
-05,00,	Facilities/Pipeline Engineer Title	2/29/24 Date
Signature	Title	Date

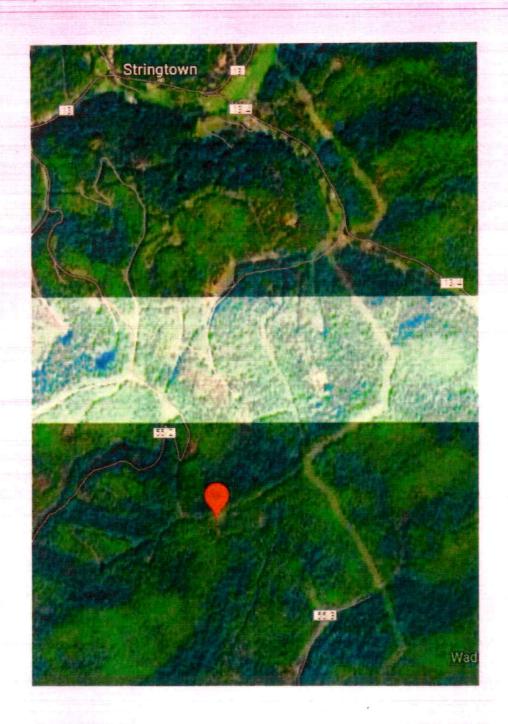

RECEIVED Office of Oil and Gas

MAR 2 2 2024

WW Department of Environmental Protection

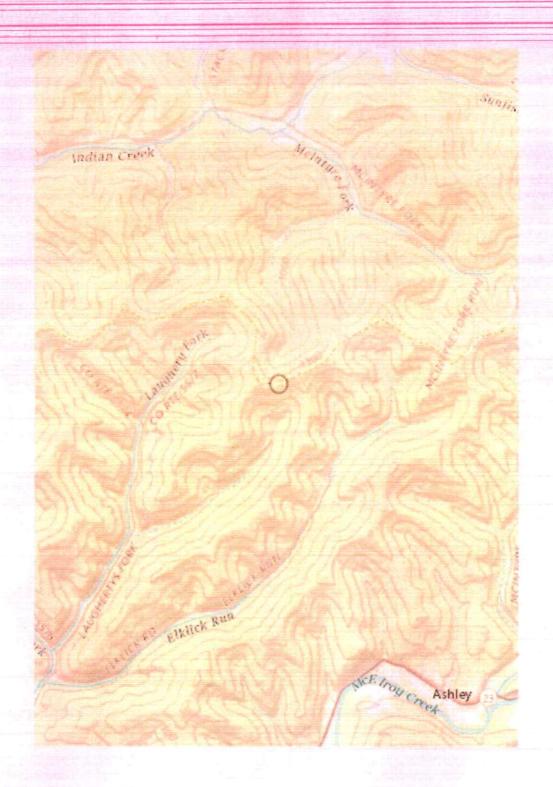

RECEIVED
Office of Oil and Gas

MAR 2 2 2024

WV Department of Environmental 04/26/2024