

WW-7
8-30-06

4709501988P



West Virginia Department of Environmental Protection
Office of Oil and Gas
WELL LOCATION FORM: GPS

API: 47-095-01988 WELL NO.: 10

FARM NAME: Oliver Pitts

RESPONSIBLE PARTY NAME: Harman Brown

COUNTY: Tyler DISTRICT: McElroy

QUADRANGLE: Centerpoint

SURFACE OWNER: Elden & Irene Nichols

ROYALTY OWNER: _____

UTM GPS NORTHING: 4365904.20

UTM GPS EASTING: 525872.69 GPS ELEVATION: 1095'

The Responsible Party named above has chosen to submit GPS coordinates in lieu of preparing a new well location plat for a plugging permit or assigned API number on the above well. The Office of Oil and Gas will not accept GPS coordinates that do not meet the following requirements:

1. Datum: NAD 1983, Zone: 17 North, Coordinate Units: meters, Altitude: height above mean sea level (MSL) – meters.
2. Accuracy to Datum – 3.05 meters
3. Data Collection Method:

Survey grade GPS _____: Post Processed Differential _____

Real-Time Differential _____

Mapping Grade GPS _____: Post Processed Differential _____

Real-Time Differential _____

RECEIVED
Office of Oil and Gas

MAR 15 2021

4. Letter size copy of the topography map showing the well location

I the undersigned, hereby certify this data is correct to the best of my knowledge and belief and shows all the information required by law and the regulations issued and prescribed by the Office of Oil and Gas.

[Signature]
Signature


Facilities/Pipeline Engineer
Title

2/11/21
Date

JOB
2/23/2021

08/13/2021

4709501988P

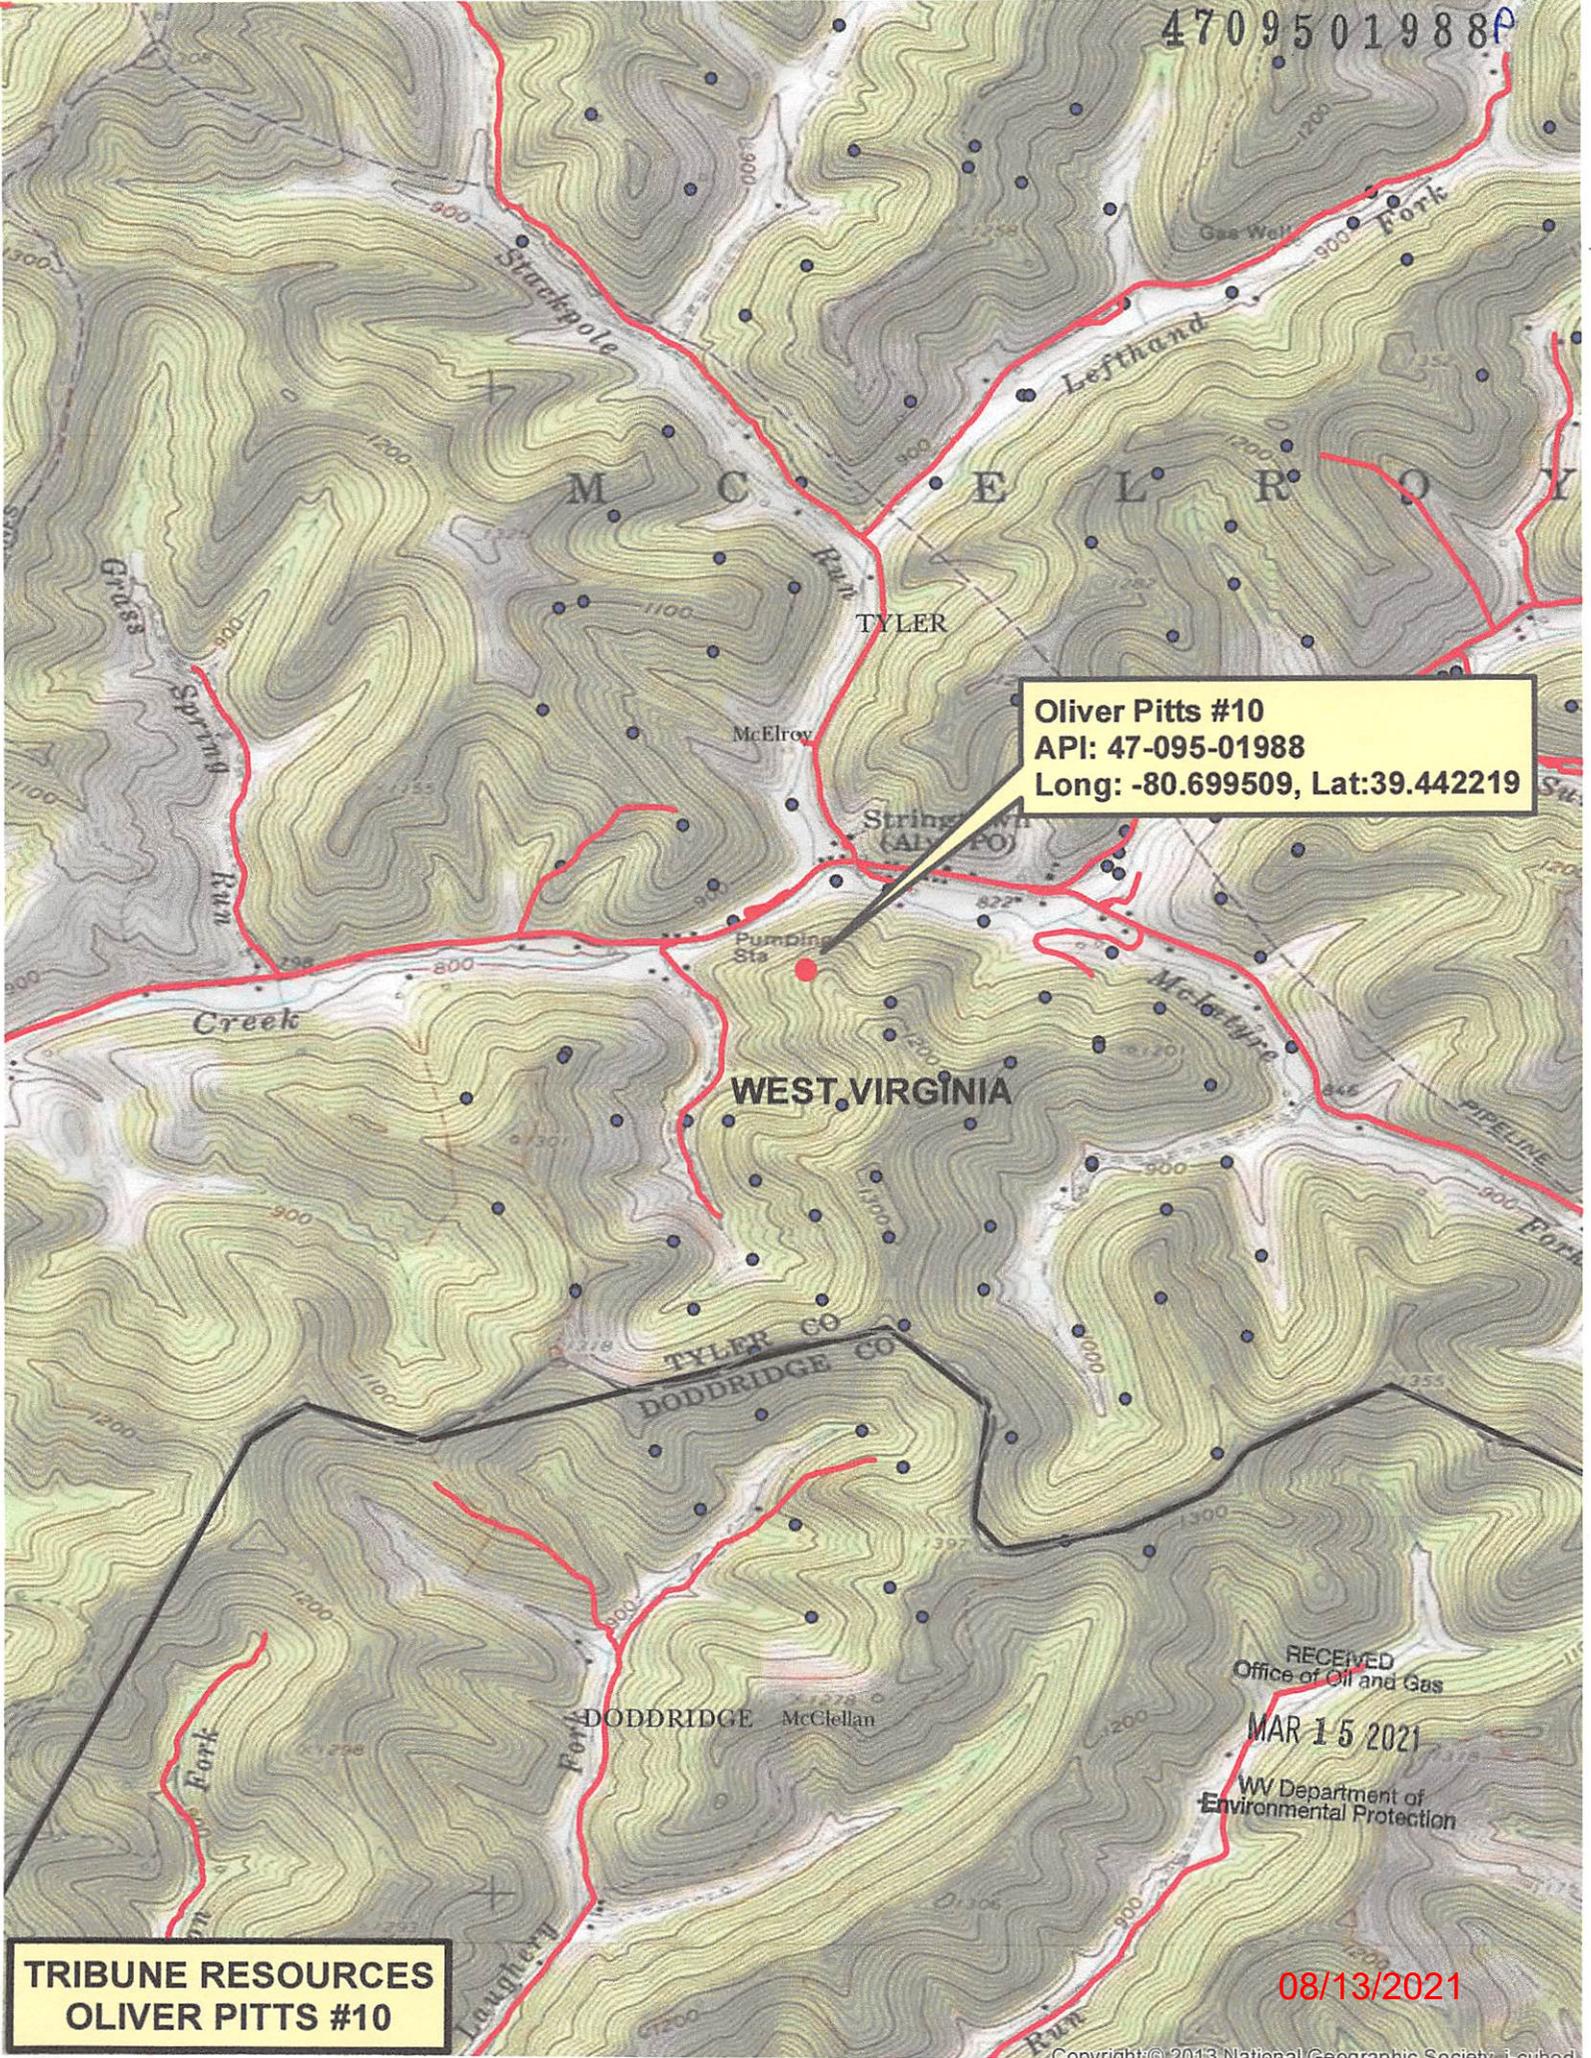

Oliver Pitts #10
API: 47-095-01988
Long: -80.699509, Lat:39.442219

TRIBUNE RESOURCES
OLIVER PITTS #10

RECEIVED
Office of Oil and Gas
MAR 15 2021
WV Department of
Environmental Protection

08/13/2021