



Triad Hunter

PATHFINDER
A Schlumberger Company

Borehole: Original Borehole	Well: Triad Hunter Stewart Winland 1301	Field: WV Tyler County (NAD 27)	Structure: Triad Hunter Stewart Winland Pad
Gravity & Magnetic Parameters Model: HGSIM 2013 MagDec: -7.59°	Dip: 87.26° FS: 62261.73mT Gravity FS: 989.330mgals (8.9066 Based)	Surface Location: NAD27 West Virginia State Plane, Northern Zone, US Feet Lat: N 39 33 33.22 Long: W 80 54 26.66 Easting: 1582607mUS	Wellbore: 9892 Hunter Skt: Stewart Winland Plan: 1301 Hunter Stewart Winland 1301 Gyro-MWD DR to update TVD Ref: K&B (200' above MSL) K&B (200' above MSL) Gyro-MWD DR to update

Surfing	STRM	Easting	103667	Latitude	N 39 33 33.22	Longitude	W 80 54 26.66	WGS 84 Elev.	M 200
Target Description	Strat	Dimension	Struc	Length	Surfing	Coord	TVD	WGS	Local Coord
Triad Hunter Stewart Winland 1301	Shale	50.00	50.00	4.00	W 80 54 26.66	1582607.00	-406.00	328.50	103667.00
Triad Hunter Stewart Winland 1301	Shale	50.00	50.00	4.00	W 80 54 26.66	1582607.00	-406.00	328.50	103667.00


PART	Area	Survey Tool	Survey Tool Code	Version/Tool	Run Size	Logging Size	MD Press	MD Tc	Survey Frequency #	MD Run (msec)	MD Run (min)	MD Run (hr)	Comments
1	1	SLS_MWD	SLS-MWD	04	30	30	3	33	Ad Site	1.20	1.20		
2	2	SLS_MWD	SLS-MWD	04	30	30	3	33	Ad Site	4.00	4.00		
3	3	SLS_MWD	SLS-MWD	04	30	30	3	33	Ad Site	168.00	168.00		
4	4	SLS_MWD	SLS-MWD	04	30	30	3	33	Ad Site	172.00	172.00		

Critical Point	MD	SHL	ASB	TVD	VNEC	NV/NM	SH/NM	DLR
SHL	5.00	5.00	5.00	5.00	5.00	0.00	5.00	0.00
Final Survey	12413.00	81.75	339.27	8081.47	8729.24	8117.23	1068.14	0.44
Projection to TD	12478.00	81.75	339.27	8081.47	8729.24	8175.51	1068.31	0.28

Grid
Mag True
Grid North
Tot Corr (Mag-G) = -0.876"
Mag Dec (-7.595°)
Grid Conv (-0.919")

- Triad Hunter Stewart Winland 1301 Gyro-MWD DR to update
- Triad Hunter Stewart Winland 1301 Rev1 SLS 2-Jan-14
- Triad Hunter Stewart Winland 1301 Rev1 SLS 2-Jan-14
- Triad Hunter Stewart Winland 1301 Rev1 SLS 2-Jan-14
- Triad Hunter Stewart Winland 1301 Rev1 SLS 2-Jan-14
- Triad Hunter Stewart Winland 1301 SHL
- Triad Hunter Stewart Winland 1301 1st print from SKI Database
- Triad Hunter Stewart Winland 1301 LP
- Triad Hunter Stewart Winland 1301 Plot Plan

RECEIVED
Office of Oil and Gas
DEC 11 2014
WV Department of
Environmental Protection

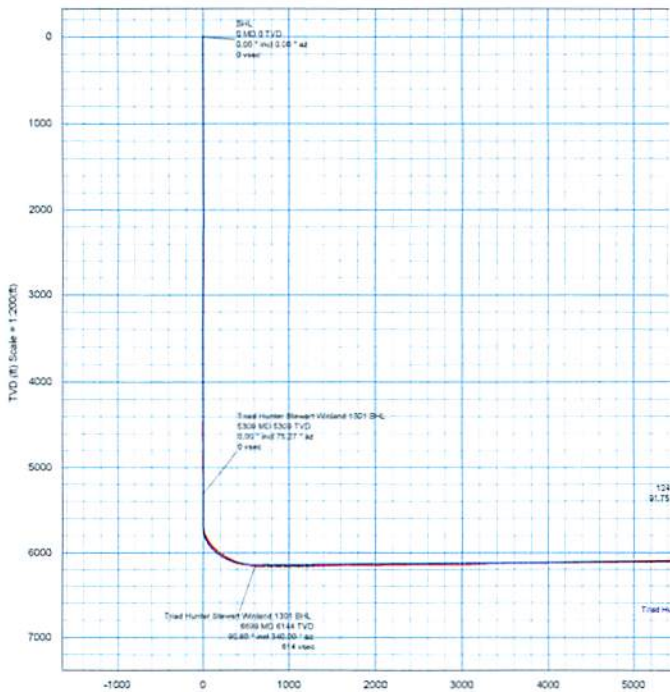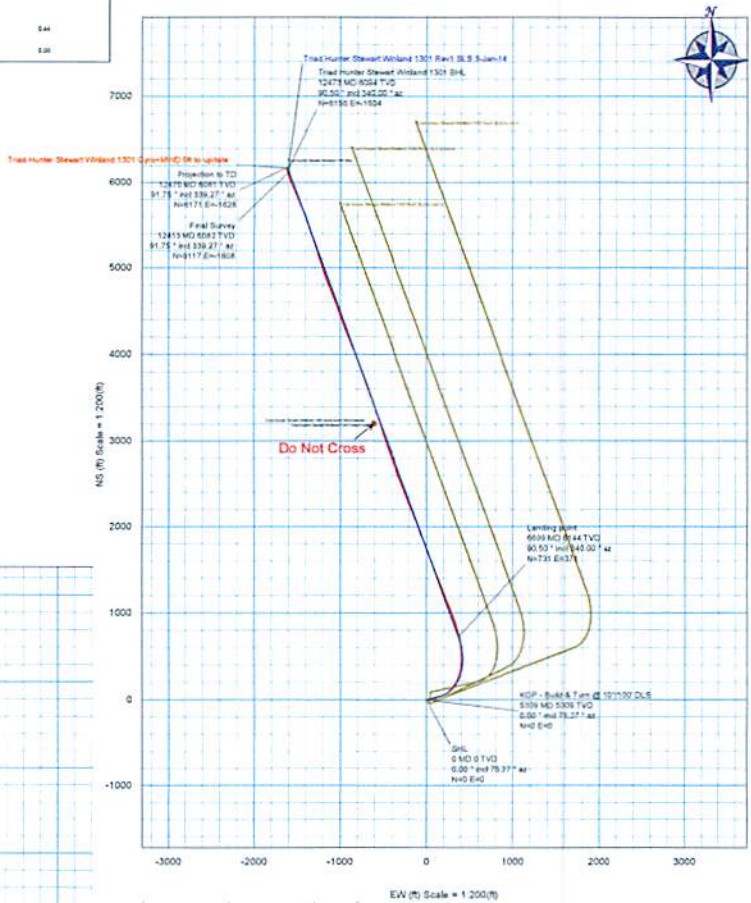

RECEIVED
Office of Oil and Gas
FEB 02 2015

RECEIVED
Office of Oil and Gas
DEC 11 2014
WV Department of
Environmental Protection

Triad Hunter Stewart Winland 1301 Surveys 0ft to 12470ft MD Survey Geodetic Report (Def Survey)



RECEIVED
Office of Oil and Gas
FEB 09 2015

WV Department of
Environmental Protection

RECEIVED
Office of Oil and Gas

DEC 11 2014

WV Department of
Environmental Protection

Report Date:	January 23, 2014 - 01:28 PM	Survey / DLS Computation:	Minimum Curvature / Lubinski
Client:	Triad Hunter	Vertical Section Azimuth:	345.396 ° (Grid North)
Field:	WV Tyler County (NAD 27)	Vertical Section Origin:	0.000 ft, 0.000 ft
Structure / Slot:	Triad Hunter Stewart Winland Pad / Triad Hunter Stewart Winland 1301	TVD Reference Datum:	KB
Well:	Triad Hunter Stewart Winland 1301	TVD Reference Elevation:	928.000 ft above MSL
Borehole:	Original Borehole	Seabed / Ground Elevation:	906.000 ft above MSL
UWI / API#:	Unknown / Unknown	Magnetic Declination:	-7.595 °
Survey Name:	Triad Hunter Stewart Winland 1301 Surveys 0ft to 12470ft MD	Total Gravity Field Strength:	999.3381mgn (9.80665 Based)
Survey Date:	January 09, 2014	Gravity Model:	GARM
Tort / AHD / DDI / ERD Ratio:	218.310 ° / 6773.604 ft / 6.476 / 1.100	Total Magnetic Field Strength:	52351.739 nT
Coordinate Reference System:	NAD27 West Virginia State Plane, Northern Zone, US Feet	Magnetic Dip Angle:	67.050 °
Location Lat / Long:	N 39° 30' 33.32036", W 80° 56' 25.54655"	Declination Date:	January 09, 2014
Location Grid N/E Y/X:	N 370850.000 ftUS, E 1593601.000 ftUS	Magnetic Declination Model:	HDGM 2013
CRS Grid Convergence Angle:	-0.9187 °	North Reference:	Grid North
Grid Scale Factor:	0.99994281	Grid Convergence Used:	-0.9187 °
Version / Patch:	2.7.1043.0	Total Corr Mag North->Grid North:	-6.6762 °
		Local Coord Referenced To:	Well Head

Comments	MD (ft)	Incl (°)	Azim Grid (°)	TVD (ft)	TVDSS (ft)	VSEC (ft)	NS (ft)	EW (ft)	DLS (°/100ft)	BR (°/100ft)	TR (°/100ft)	Northing (ftUS)	Easting (ftUS)	Latitude (N/S ° ' ")	Longitude (E/W ° ' ")
SHL	0.00	0.00	0.00	0.00	-928.00	0.00	0.00	0.00	N/A	N/A	N/A	370850.00	1593601.00	N 39 30 33.32	W 80 56 25.55
	100.00	0.07	193.64	100.00	-828.00	-0.05	-0.06	-0.01	0.07	0.07	0.00	370849.94	1593600.99	N 39 30 33.32	W 80 56 25.55
	200.00	0.01	247.47	200.00	-728.00	-0.11	-0.12	-0.04	0.06	-0.06	53.83	370849.88	1593600.96	N 39 30 33.32	W 80 56 25.55
	300.00	0.08	229.85	300.00	-628.00	-0.14	-0.17	-0.10	0.07	0.07	-17.62	370849.83	1593600.90	N 39 30 33.32	W 80 56 25.55
	400.00	0.07	225.47	400.00	-528.00	-0.20	-0.26	-0.20	0.01	-0.01	-4.38	370849.74	1593600.80	N 39 30 33.32	W 80 56 25.55
	500.00	0.03	223.87	500.00	-428.00	-0.24	-0.32	-0.26	0.04	-0.04	-1.60	370849.68	1593600.74	N 39 30 33.32	W 80 56 25.55
	600.00	0.12	224.49	600.00	-328.00	-0.31	-0.41	-0.35	0.09	0.09	0.62	370849.59	1593600.65	N 39 30 33.32	W 80 56 25.55
	700.00	0.16	227.96	700.00	-228.00	-0.43	-0.58	-0.53	0.04	0.04	3.47	370849.42	1593600.47	N 39 30 33.31	W 80 56 25.55
	800.00	0.12	253.13	800.00	-128.00	-0.50	-0.71	-0.73	0.07	-0.04	25.17	370849.29	1593600.27	N 39 30 33.31	W 80 56 25.56
	900.00	0.23	299.79	900.00	-28.00	-0.36	-0.64	-1.00	0.17	0.11	46.66	370849.36	1593600.00	N 39 30 33.31	W 80 56 25.56
	1000.00	0.08	303.64	1000.00	72.00	-0.17	-0.50	-1.24	0.15	-0.15	3.85	370849.50	1593599.76	N 39 30 33.32	W 80 56 25.56
	1100.00	0.10	308.82	1100.00	172.00	-0.05	-0.40	-1.36	0.02	0.02	5.18	370849.60	1593599.64	N 39 30 33.32	W 80 56 25.56
	1200.00	0.07	283.33	1200.00	272.00	0.05	-0.34	-1.49	0.05	-0.03	-25.49	370849.66	1593599.51	N 39 30 33.32	W 80 56 25.57
	1300.00	0.05	246.09	1300.00	372.00	0.07	-0.34	-1.59	0.04	-0.02	-37.24	370849.66	1593599.41	N 39 30 33.32	W 80 56 25.57
	1400.00	0.08	195.30	1400.00	472.00	0.00	-0.42	-1.65	0.06	0.03	-50.79	370849.58	1593599.35	N 39 30 33.32	W 80 56 25.57
	1500.00	0.12	197.02	1500.00	572.00	-0.15	-0.59	-1.70	0.04	0.04	1.72	370849.41	1593599.30	N 39 30 33.31	W 80 56 25.57
	1600.00	0.10	194.27	1600.00	672.00	-0.31	-0.78	-1.75	0.02	-0.02	-2.75	370849.22	1593599.25	N 39 30 33.31	W 80 56 25.57
	1700.00	0.18	190.57	1700.00	772.00	-0.53	-1.02	-1.80	0.08	0.08	-3.70	370848.98	1593599.20	N 39 30 33.31	W 80 56 25.57
	1800.00	0.12	192.12	1800.00	872.00	-0.76	-1.27	-1.85	0.06	-0.06	1.55	370848.73	1593599.15	N 39 30 33.31	W 80 56 25.57
	1900.00	0.09	166.97	1900.00	972.00	-0.94	-1.45	-1.85	0.05	-0.03	-25.15	370848.55	1593599.15	N 39 30 33.31	W 80 56 25.57

Table with columns: Comments, MD (ft), Incl (°), Azim Grid (°), TVD (ft), TVDSS (ft), VSEC (ft), NS (ft), EW (ft), DLS (ft/100ft), BR (ft/100ft), TR (ft/100ft), Northing (ftUS), Easting (ftUS), Latitude (N/S ° ' ''), Longitude (E/W ° ' ''). The table contains 15 columns of data representing borehole measurements and coordinates. A large 'RECEIVED' stamp is overlaid on the bottom right section of the table.

Comments	MD (ft)	Incl (°)	Azim Grid (°)	TVD (ft)	TVDSS (ft)	VSEC (ft)	NS (ft)	EW (ft)	DLS (°/100ft)	BR (°/100ft)	TR (°/100ft)	Northing (ftUS)	Easting (ftUS)	Latitude (N/S ° °' ")	Longitude (E/W ° °' ")
	5761.00	45.15	67.72	5711.86	4783.86	0.72	48.34	182.66	10.54	6.20	-12.32	370898.34	1593783.64	N 39 30 33.83	W 80 56 23.23
	5805.00	45.63	61.99	5742.77	4814.77	6.46	61.64	210.98	9.33	1.09	-13.02	370911.64	1593811.97	N 39 30 33.96	W 80 56 22.87
	5848.00	46.28	54.69	5772.69	4844.69	15.52	77.86	237.25	12.29	1.51	-16.98	370927.85	1593838.24	N 39 30 34.13	W 80 56 22.54
	5892.00	47.07	47.55	5802.90	4874.90	28.67	97.93	262.13	11.94	1.80	-16.23	370947.93	1593863.11	N 39 30 34.33	W 80 56 22.22
	5936.00	47.68	42.91	5832.70	4904.70	44.94	120.72	285.10	7.88	1.39	-10.55	370970.72	1593886.08	N 39 30 34.56	W 80 56 21.93
	5979.00	48.41	37.82	5861.46	4933.46	63.29	145.08	305.79	8.96	1.70	-11.84	370995.07	1593906.77	N 39 30 34.80	W 80 56 21.68
	6023.00	50.06	35.37	5890.19	4962.19	84.18	171.84	325.65	5.64	3.75	-5.57	371021.83	1593926.63	N 39 30 35.07	W 80 56 21.43
	6066.00	51.87	31.19	5917.28	4989.28	106.58	199.76	343.95	8.64	4.21	-9.72	371049.74	1593944.93	N 39 30 35.35	W 80 56 21.20
	6110.00	54.15	25.87	5943.76	5015.76	132.22	230.62	360.71	10.96	5.18	-12.09	371080.61	1593961.68	N 39 30 35.66	W 80 56 20.99
	6153.00	56.24	21.03	5968.32	5040.32	160.02	263.00	374.73	10.44	4.86	-11.26	371112.99	1593975.71	N 39 30 35.98	W 80 56 20.82
	6197.00	57.93	16.75	5992.23	5064.23	190.82	297.94	386.67	9.02	3.84	-9.73	371147.92	1593987.65	N 39 30 36.33	W 80 56 20.67
	6241.00	59.38	12.86	6015.13	5087.13	223.55	334.26	396.26	8.24	3.30	-8.84	371184.24	1593997.24	N 39 30 36.69	W 80 56 20.56
	6284.00	60.92	8.59	6036.53	5108.53	257.25	370.89	403.19	9.33	3.58	-9.93	371220.87	1594004.16	N 39 30 37.05	W 80 56 20.48
	6328.00	63.36	4.94	6057.10	5129.10	293.47	409.51	407.76	9.19	5.55	-8.30	371259.49	1594008.73	N 39 30 37.43	W 80 56 20.43
	6372.00	65.62	1.63	6076.05	5148.05	331.26	449.15	410.02	8.51	5.14	-7.52	371299.12	1594011.00	N 39 30 37.82	W 80 56 20.41
	6413.00	67.93	359.48	6092.22	5164.22	367.62	486.82	410.38	7.41	5.63	-5.24	371336.79	1594011.35	N 39 30 38.20	W 80 56 20.41
	6459.00	70.77	357.09	6108.44	5180.44	409.57	529.84	409.08	7.86	6.17	-5.20	371379.80	1594010.06	N 39 30 38.62	W 80 56 20.44
	6503.00	74.04	354.34	6121.75	5193.75	450.83	571.65	405.94	9.52	7.43	-6.25	371421.62	1594006.92	N 39 30 39.03	W 80 56 20.48
	6546.00	76.44	351.95	6132.70	5204.70	492.02	612.93	400.97	7.75	5.58	-5.56	371462.89	1594001.95	N 39 30 39.44	W 80 56 20.56
	6590.00	78.41	349.19	6142.28	5214.28	534.79	655.28	393.93	7.58	4.48	-6.27	371505.24	1593994.91	N 39 30 39.86	W 80 56 20.66
	6634.00	81.02	348.45	6150.14	5222.14	578.00	697.75	385.54	6.16	5.93	-1.68	371547.71	1593986.52	N 39 30 40.28	W 80 56 20.77
	6677.00	86.11	347.43	6154.96	5226.96	620.67	739.52	376.61	12.07	11.84	-2.37	371589.48	1593977.59	N 39 30 40.69	W 80 56 20.89
	6721.00	91.20	346.56	6155.99	5227.99	664.63	782.37	366.72	11.74	11.57	-1.98	371632.32	1593967.70	N 39 30 41.11	W 80 56 21.03
	6764.00	92.65	345.78	6154.54	5226.54	707.60	824.10	356.45	3.83	3.37	-1.81	371674.05	1593957.42	N 39 30 41.52	W 80 56 21.17
	6808.00	92.03	343.77	6152.75	5224.75	751.56	866.51	344.90	4.78	-1.41	-4.57	371716.46	1593945.88	N 39 30 41.94	W 80 56 21.32
	6852.00	91.41	341.59	6151.43	5223.43	795.48	908.50	331.81	5.15	-1.41	-4.95	371758.44	1593932.79	N 39 30 42.35	W 80 56 21.50
	6895.00	91.72	339.85	6150.25	5222.25	838.32	949.07	317.62	4.11	0.72	-4.05	371799.01	1593918.60	N 39 30 42.75	W 80 56 21.69
	6939.00	91.68	338.75	6148.95	5220.95	882.05	990.21	302.07	2.50	-0.09	-2.50	371840.15	1593903.05	N 39 30 43.15	W 80 56 21.90
	6983.00	89.59	337.90	6148.46	5220.46	925.71	1031.09	285.82	5.13	-4.75	-1.93	371881.03	1593886.80	N 39 30 43.55	W 80 56 22.11
	7026.00	89.35	337.16	6148.86	5220.86	968.31	1070.83	269.39	1.81	-0.56	-1.72	371920.76	1593870.37	N 39 30 43.95	W 80 56 22.33
	7070.00	89.21	337.31	6149.41	5221.41	1011.86	1111.40	252.36	0.47	-0.32	0.34	371961.33	1593853.35	N 39 30 44.34	W 80 56 22.55
	7114.00	89.31	337.18	6149.98	5221.98	1055.41	1151.97	235.35	0.37	0.23	-0.30	372001.90	1593836.33	N 39 30 44.74	W 80 56 22.78
	7157.00	91.07	338.18	6149.83	5221.83	1098.02	1191.74	219.02	4.71	4.09	2.33	372041.67	1593820.00	N 39 30 45.13	W 80 56 23.00
	7201.00	91.41	338.01	6148.88	5220.88	1141.65	1232.56	202.60	0.86	0.77	-0.39	372082.48	1593803.59	N 39 30 45.53	W 80 56 23.21
	7244.00	90.93	337.77	6148.00	5220.00	1184.27	1272.39	186.42	1.25	-1.12	-0.56	372122.31	1593787.41	N 39 30 45.92	W 80 56 23.43
	7288.00	90.41	337.65	6147.49	5219.49	1227.87	1313.10	169.74	0.87	-1.18	-0.27	372163.02	1593770.73	N 39 30 46.32	W 80 56 23.65
	7332.00	90.03	337.59	6147.32	5219.32	1271.47	1353.78	152.98	0.86	-0.14	-0.14	372203.70	1593753.97	N 39 30 46.72	W 80 56 23.87
	7393.00	90.07	337.66	6147.27	5219.27	1331.91	1410.19	129.76	0.71	0.07	0.11	372260.10	1593730.75	N 39 30 47.28	W 80 56 24.18
	7486.00	91.44	338.34	6146.04	5218.04	1424.13	1496.41	94.83	1.64	1.47	0.73	372346.32	1593695.92	N 39 30 48.12	W 80 56 24.64
	7578.00	91.37	339.85	6143.79	5215.79	1515.54	1582.32	62.11	1.64	-0.08	1.64	372432.23	1593663.11	N 39 30 48.97	W 80 56 25.08
	7640.00	90.79	340.09	6142.62	5214.62	1577.25	1640.56	40.88	1.01	-0.94	0.39	372490.46	1593641.88	N 39 30 49.54	W 80 56 25.36
	7702.00	90.48	339.12	6141.93	5213.93	1638.93	1698.67	19.27	1.64	-0.50	-1.56	372548.57	1593620.27	N 39 30 50.11	W 80 56 25.65
	7792.00	90.79	339.25	6140.93	5212.93	1728.40	1782.79	-12.71	0.37	0.34	0.14	372632.69	1593588.30	N 39 30 50.94	W 80 56 26.07
	7884.00	90.17	339.49	6140.16	5212.16	1819.88	1868.89	-45.12	0.72	-0.67	0.26	372718.78	1593555.88	N 39 30 51.78	W 80 56 26.50
	7976.00	90.34	339.64	6139.75	5211.75	1911.41	1955.10	-77.24	0.26	0.18	0.16	372804.98	1593523.77	N 39 30 52.63	W 80 56 26.93

RECEIVED
Office of Oil and Gas
FEB 02 2015
WV Department
Environmental Protection

MA Debarth
C/O

Comments	MD (ft)	Incl (°)	Azim Grid (°)	TVD (ft)	TVDSS (ft)	VSEC (ft)	NS (ft)	EW (ft)	DLS (°/100ft)	BR (°/100ft)	TR (°/100ft)	Northing (ftUS)	Easting (ftUS)	Latitude (N/S ° ' ")	Longitude (E/W ° ' ")
	8067.00	90.65	339.51	6138.97	5210.97	2001.93	2040.37	-109.00	0.37	0.34	-0.14	372890.25	1593492.01	N 39 30 53.47	W 80 56 27.35
	8159.00	90.62	337.88	6137.95	5209.95	2093.30	2128.08	-142.42	1.77	-0.03	-1.77	372975.95	1593458.59	N 39 30 54.31	W 80 56 27.80
	8252.00	90.31	338.15	6137.19	5209.19	2185.52	2212.31	-177.23	0.44	-0.33	0.29	373062.18	1593423.78	N 39 30 55.15	W 80 56 28.28
	8339.00	90.52	338.63	6136.56	5208.56	2271.87	2293.19	-209.27	0.60	0.24	0.55	373143.06	1593391.74	N 39 30 55.95	W 80 56 28.69
	8426.00	91.10	339.77	6135.33	5207.33	2358.35	2374.51	-240.16	1.47	0.67	1.31	373224.37	1593360.85	N 39 30 56.75	W 80 56 29.10
	8514.00	90.83	339.74	6133.85	5205.85	2445.91	2457.07	-270.81	0.31	-0.31	-0.03	373306.92	1593330.41	N 39 30 57.56	W 80 56 29.50
	8601.00	91.03	339.15	6132.44	5204.44	2532.43	2538.52	-301.15	0.72	0.23	-0.68	373388.37	1593299.87	N 39 30 58.36	W 80 56 29.91
	8688.00	90.00	337.72	6131.66	5203.66	2618.78	2619.42	-333.13	2.03	-1.18	-1.64	373469.26	1593267.89	N 39 30 59.15	W 80 56 30.33
	8775.00	90.07	339.45	6131.60	5203.60	2705.17	2700.41	-364.89	1.99	0.08	1.99	373550.25	1593236.13	N 39 30 59.95	W 80 56 30.75
	8862.00	89.28	340.24	6132.10	5204.10	2791.76	2782.08	-394.87	1.28	-0.91	0.91	373631.92	1593206.16	N 39 31 0.75	W 80 56 31.15
	8950.00	89.38	340.96	6133.13	5205.13	2879.44	2865.08	-424.10	0.83	0.11	0.82	373714.91	1593176.93	N 39 31 1.57	W 80 56 31.54
	9037.00	91.10	342.06	6132.76	5204.76	2966.24	2947.58	-451.69	2.35	1.98	1.26	373797.41	1593149.34	N 39 31 2.38	W 80 56 31.91
	9124.00	90.79	341.81	6131.33	5203.33	3053.07	3030.28	-478.66	0.46	-0.36	-0.29	373880.10	1593122.37	N 39 31 3.19	W 80 56 32.27
	9211.00	92.37	342.54	6128.93	5200.93	3139.89	3113.07	-505.28	2.00	1.82	0.84	373962.89	1593095.75	N 39 31 4.00	W 80 56 32.63
	9298.00	92.27	341.90	6125.41	5197.41	3226.69	3195.85	-531.83	0.74	-0.11	-0.74	374045.66	1593069.21	N 39 31 4.82	W 80 56 32.99
	9386.00	91.20	341.02	6122.74	5194.74	3314.44	3279.24	-559.79	1.57	-1.22	-1.00	374129.04	1593041.24	N 39 31 5.64	W 80 56 33.36
	9473.00	91.27	341.35	6120.87	5192.87	3401.18	3361.57	-587.85	0.39	0.08	0.38	374211.37	1593013.19	N 39 31 6.45	W 80 56 33.73
	9560.00	90.79	340.82	6119.30	5191.30	3487.92	3443.86	-616.04	0.82	-0.55	-0.61	374293.65	1592984.99	N 39 31 7.26	W 80 56 34.11
	9648.00	90.28	341.01	6118.48	5190.48	3575.65	3527.02	-644.81	0.62	-0.58	0.22	374376.81	1592956.22	N 39 31 8.07	W 80 56 34.50
	9735.00	90.31	341.69	6118.03	5190.03	3662.43	3609.45	-672.64	0.78	0.03	0.78	374459.23	1592928.40	N 39 31 8.88	W 80 56 34.87
	9822.00	89.93	339.19	6117.85	5189.85	3749.10	3691.42	-701.76	2.91	-0.44	-2.87	374541.20	1592899.28	N 39 31 9.69	W 80 56 35.26
	9910.00	90.52	339.15	6117.50	5189.50	3836.58	3773.67	-733.05	0.67	0.67	-0.05	374623.44	1592867.99	N 39 31 10.50	W 80 56 35.67
	9997.00	90.48	338.61	6116.75	5188.75	3923.01	3854.82	-764.40	0.62	-0.05	-0.62	374704.59	1592836.65	N 39 31 11.29	W 80 56 36.09
	10084.00	90.72	338.79	6115.83	5187.83	4009.41	3935.87	-796.00	0.34	0.28	0.21	374785.64	1592805.05	N 39 31 12.09	W 80 56 36.51
	10172.00	91.89	338.56	6113.83	5185.83	4096.78	4017.83	-827.99	1.35	1.33	-0.26	374867.59	1592773.06	N 39 31 12.89	W 80 56 36.93
	10259.00	91.61	338.28	6111.17	5183.17	4183.10	4098.89	-859.98	0.46	-0.32	-0.32	374948.45	1592741.07	N 39 31 13.69	W 80 56 37.36
	10346.00	91.41	337.57	6108.88	5180.88	4269.33	4179.28	-892.66	0.85	-0.23	-0.82	375029.04	1592708.39	N 39 31 14.48	W 80 56 37.79
	10434.00	90.58	337.22	6107.35	5179.35	4356.46	4260.51	-926.48	1.02	-0.94	-0.40	375110.26	1592674.57	N 39 31 15.28	W 80 56 38.24
	10521.00	90.62	338.53	6106.44	5178.44	4442.70	4341.10	-959.25	1.51	0.05	1.51	375190.84	1592641.81	N 39 31 16.07	W 80 56 38.67
	10592.00	91.48	340.45	6105.14	5177.14	4513.31	4407.58	-984.12	2.96	1.21	2.70	375257.32	1592616.94	N 39 31 16.72	W 80 56 39.00
	10680.00	91.48	341.07	6102.87	5174.87	4600.99	4490.64	-1013.10	0.70	0.00	0.70	375340.37	1592587.96	N 39 31 17.54	W 80 56 39.39
	10767.00	91.58	339.73	6100.54	5172.54	4687.63	4572.57	-1042.28	1.54	0.11	-1.54	375422.30	1592558.78	N 39 31 18.34	W 80 56 39.78
	10854.00	90.82	339.17	6098.72	5170.72	4774.14	4654.01	-1072.81	1.09	-0.87	-0.64	375503.74	1592528.25	N 39 31 19.14	W 80 56 40.19
	10941.00	90.31	337.88	6097.86	5169.86	4860.51	4734.97	-1104.66	1.59	-0.59	-1.48	375584.68	1592496.41	N 39 31 19.94	W 80 56 40.61
	11029.00	90.82	338.29	6097.00	5169.00	4947.79	4816.60	-1137.50	0.74	0.59	0.47	375666.32	1592463.57	N 39 31 20.74	W 80 56 41.05
	11116.00	91.68	341.46	6095.10	5167.10	5034.35	4898.28	-1167.42	0.99	0.99	3.64	375747.97	1592433.65	N 39 31 21.54	W 80 56 41.44
	11203.00	90.93	342.55	6093.12	5165.12	5121.18	4980.98	-1194.29	0.99	-0.86	1.25	375830.69	1592406.78	N 39 31 22.35	W 80 56 41.80
	11290.00	90.55	342.01	6091.99	5163.99	5208.04	5063.84	-1220.77	0.76	0.44	-0.62	375913.55	1592380.30	N 39 31 23.17	W 80 56 42.16
	11378.00	90.72	343.29	6091.02	5163.02	5295.93	5147.83	-1247.01	1.47	0.19	1.45	375997.53	1592354.08	N 39 31 23.99	W 80 56 42.51
	11465.00	90.96	342.11	6089.74	5161.74	5382.83	5230.89	-1272.88	1.38	0.28	-1.36	376080.58	1592328.20	N 39 31 24.81	W 80 56 42.86
	11552.00	89.62	340.80	6089.30	5161.30	5469.62	5313.37	-1300.55	2.15	-1.54	-1.51	376163.05	1592300.53	N 39 31 25.62	W 80 56 43.23
	11639.00	89.62	340.38	6089.88	5161.88	5556.31	5395.42	-1329.46	0.48	0.00	-0.48	376245.10	1592271.62	N 39 31 26.43	W 80 56 43.61
	11726.00	89.97	340.86	6090.19	5162.19	5643.00	5477.49	-1358.33	0.88	0.40	0.55	376327.16	1592242.75	N 39 31 27.23	W 80 56 44.00
	11814.00	89.83	340.36	6090.34	5162.34	5730.70	5560.50	-1387.54	0.99	-0.16	-0.57	376410.17	1592213.54	N 39 31 28.05	W 80 56 44.39
	11857.00	89.66	339.77	6090.54	5162.54	5773.51	5600.82	-1402.21	1.48	0.40	-1.37	376450.59	1592188.88	N 39 31 28.45	W 80 56 44.58

RECEIVED
 Office of Oil and Gas
 FEB 02 2015
 WV Department of
 Environmental Protection

Comments	MD (ft)	Incl (°)	Azim Grd (°)	TVD (ft)	TVDSS (ft)	VSEC (ft)	NS (ft)	EW (ft)	DLS (°/100ft)	BR (°/100ft)	TR (°/100ft)	Northing (ftUS)	Easting (ftUS)	Latitude (N/S ° ' ")	Longitude (E/W ° ' ")
	11945.00	90.10	338.94	6090.72	5162.72	5861.02	5683.27	-1433.23	1.07	0.50	-0.94	376532.93	1592167.85	N 39 31 29.26	W 80 56 45.00
	12032.00	90.28	337.94	6090.43	5162.43	5947.38	5764.18	-1465.20	1.17	0.21	-1.15	376613.84	1592135.89	N 39 31 30.05	W 80 56 45.42
	12119.00	91.48	338.48	6089.10	5161.10	6033.68	5844.95	-1497.49	1.51	1.38	0.62	376694.61	1592103.60	N 39 31 30.84	W 80 56 45.85
	12206.00	90.79	337.20	6087.37	5159.37	6119.91	5925.51	-1530.30	1.67	-0.79	-1.47	376775.16	1592070.79	N 39 31 31.63	W 80 56 46.29
	12294.00	91.34	337.17	6085.74	5157.74	6206.99	6006.61	-1564.42	0.63	0.63	-0.03	376856.25	1592036.68	N 39 31 32.43	W 80 56 46.74
	12381.00	91.75	339.13	6083.39	5155.39	6293.26	6087.32	-1596.78	2.30	0.47	2.25	376936.96	1592004.31	N 39 31 33.22	W 80 56 47.17
Final Survey	12413.00	91.75	339.27	6082.41	5154.41	6325.08	6117.22	-1608.14	0.44	0.00	0.44	376966.86	1591992.95	N 39 31 33.52	W 80 56 47.32
Projection to TD	12470.00	91.75	339.27	6080.67	5152.67	6381.71	6170.51	-1628.31	0.00	0.00	0.00	377020.14	1591972.79	N 39 31 34.04	W 80 56 47.59

Survey Type: Def Survey

Survey Error Model: ISCWSA Rev 0 *** 3-D 95.000% Confidence 2.7955 sigma
 Survey Program:

Description	Part	MD From (ft)	MD To (ft)	EOU Freq (ft)	Hole Size (in)	Casing Diameter (in)	Survey Tool Type	Borehole / Survey
	1	0.000	22.000	Act Stns	30.000	30.000	SLB_NSG+MSHOT-Depth Only	Original Borehole / Triad Hunter Stewart Winland 1301 Surveys Off to 12470R MD
	1	22.000	5180.000	Act Stns	30.000	30.000	SLB_NSG+MSHOT	Original Borehole / Triad Hunter Stewart Winland 1301 Surveys Off
	1	5180.000	12413.000	Act Stns	30.000	30.000	SLB_MWD-STD	Original Borehole / Triad Hunter Stewart Winland 1301 Surveys Off
	1	12413.000	12470.000	Act Stns	30.000	30.000	SLB_BLIND+TREND	Original Borehole / Triad Hunter Stewart Winland 1301 Surveys Off

RECEIVED
 Office of Oil and Gas
 DEC 11 2014
 WV Department of
 Environmental Protection

RECEIVED
 Office of Oil and Gas
 FEB 09 2015

WV Department of
 Environmental Protection