

west virginia department of environmental protection

Office of Oil and Gas 601 57th Street SE Charleston, WV 25304 (304) 926-0450 (304) 926-0452 fax Earl Ray Tomblin, Governor Randy C. Huffman, Cabinet Secretary www.dep.wv.gov

July 14, 2015

WELL WORK PERMIT

Horizontal 6A Well

This permit, API Well Number: 47-9502270, issued to ANTERO RESOURCES CORPORATION, is evidence of permission granted to perform the specified well work at the location described on the attached pages and located on the attached plat, subject to the provisions of Chapter 22 of the West Virginia Code of 1931, as amended, and all rules and regulations promulgated thereunder, and to all conditions and provisions outlined in the pages attached hereto. Notification shall be given by the operator to the Oil and Gas Inspector at least 24 hours prior to the construction of roads, locations, and/or pits for any permitted work. In addition, the well operator shall notify the same inspector 24 hours before any actual well work is commenced and prior to running and cementing casing. Spills or emergency discharges must be promptly reported by the operator to 1-800-642-3074 and to the Oil and Gas inspector.

Please be advised that form WR-35, Well Operators Report of Well Work is to be submitted to this office within 90 days completion of permitted well work, as should form WR-34 Discharge Monitoring Report within 30 days of discharge of pits, if applicable. Failure to abide by all statutory and regulatory provisions governing all duties and operations hereunder may result in suspension or revocation of this permit and, in addition, may result in civil and/or criminal penalties being imposed upon the operators.

In addition to the applicable requirements of this permit, and the statutes and rules governing oil and gas activity in WV, this permit may contain specific conditions which must be followed. Permit conditions are attached to this cover letter.

Per 35CSR-4-5.2.g this permit will expire in two (2) years from the issue date unless permitted well work is commenced. If there are any questions, please feel free to contact me at (304) 926-0499 ext. 1654.

James Martin

Chief

Operator's Well No: RYMER UNIT 2H

Farm Name: UNDERWOOD, RAYMOND

API Well Number: 47-9502270

Permit Type: Horizontal 6A Well

Date Issued: 07/14/2015

Promoting a healthy environment.

PERMIT CONDITIONS

West Virginia Code § 22-6A-8(d) allows the Office of Oil and Gas to place specific conditions upon this permit. Permit conditions have the same effect as law. <u>Failure to adhere to the specified permit conditions may result in enforcement action.</u>

CONDITIONS

- 1. This proposed activity may require permit coverage from the United States Army Corps of Engineers (USACE). Through this permit, you are hereby being advised to consult with USACE regarding this proposed activity.
- 2. If the operator encounters an unanticipated void, or an anticipated void at an unanticipated depth, the operator shall notify the inspector within 24 hours. Modifications to the casing program may be necessary to comply with W. Va. Code § 22-6A-5a (12), which requires drilling to a minimum depth of thirty feet below the bottom of the void, and installing a minimum of twenty (20) feet of casing. Under no circumstance should the operator drill more than fifty (50) feet below the bottom of the void or install less than twenty (20) feet of casing below the bottom of the void.
- 3. When compacting fills, each lift before compaction shall not be more than 12 inches in height, and the moisture content of the fill material shall be within limits as determined by the Standard Proctor Density test of the actual soils used in specific engineered fill, ASTM D698, Standard Test Method for Laboratory Compaction Characteristics of Soil Using Standard Effort, to achieve 95 % compaction of the optimum density. Each lift shall be tested for compaction, with a minimum of two tests per lift per acre of fill. All test results shall be maintained on site and available for review.
- 4. Operator shall install signage per § 22-6A-8g (6) (B) at all source water locations included in their approved water management plan within 24 hours of water management plan activation.
- 5. Oil and gas water supply wells will be registered with the Office of Oil and Gas and all such wells will be constructed and plugged in accordance with the standards of the Bureau for Public Health set forth in its Legislative rule entitled *Water Well Regulations*, 64 C.S.R. 19. Operator is to contact the Bureau of Public Health regarding permit requirements. In lieu of plugging, the operator may transfer the well to the surface owner upon agreement of the parties. All drinking water wells within fifteen hundred feet of the water supply well shall be flow tested by the operator upon request of the drinking well owner prior to operating the water supply well.
- 6. Pursuant to the requirements pertaining to the sampling of domestic water supply wells/springs the operator shall, no later than thirty (30) days after receipt of analytical data provide a written copy to the Chief and any of the users who may have requested such analyses.
- 7. If any explosion or other accident causing loss of life or serious personal injury occurs in or about a well or well work on a well, the well operator or its contractor shall give notice, stating the particulars of the explosion or accident, to the oil and gas inspector and the Chief, within 24 hours of said accident.
- 8. During the casing and cementing process, in the event cement does not return to the surface, the oil and gas inspector shall be notified within 24 hours.
- 9. Operator shall provide the Office of Oil & Gas notification of the date that drilling commenced on this well. Such notice shall be provided by sending an email to DEPOOGNotify@wv.gov within 30 days of commencement of drilling.

09502270

WW-6B (04/15) API NO. 47-095 - 02710

OPERATOR WELL NO. Rymer Unit 2H

Well Pad Name: Existing Dale Pad

STATE OF WEST VIRGINIA DEPARTMENT OF ENVIRONMENTAL PROTECTION, OFFICE OF OIL AND GAS WELL WORK PERMIT APPLICATION

1) Well Operator: An	tero Resour	rces Corpora	at 494488557	095 - Tyler	Centervill	Shirley 7.5'
			Operator ID	County	District	Quadrangle
2) Operator's Well Nu	mber: Ryme	er Unit 2H	Well Pac	l Name: Existi	ng Dale Pa	nd 🥖
3) Farm Name/Surface	Owner: Un	derwood, Ra	ymond Public Roa	d Access: CR	7/6 & CR 4	18
4) Elevation, current gr	round: 10	17' E	Elevation, proposed	post-construction	on: 1017'	
5) Well Type (a) Gas	s X	Oil	Unde	erground Storag	ge	
Other						
(b)If G	as Shallov	w X	Deep			1 Soll
	Horizo	ntal X				Michael Doff 5-28-15
Existing Pad: Yes or	No Yes	,				6-28-1
7) Proposed Target For						>
Marcellus Shale: 670	00' TVD, Antic	cipated Thickr	iess- 55 feet, Assoc	iated Pressure-	2800#	
8) Proposed Total Vert	ical Depth:	6700' TVD				-
9) Formation at Total V	/ertical Dept	h: Marcellu	s Shale			
10) Proposed Total Me	asured Depth	h: 17,700' I	MD			
11) Proposed Horizonta	al Leg Lengt	h: 10,478'				
12) Approximate Fresh	Water Strate	a Depths:	107', 218', 389'			
13) Method to Determi	ne Fresh Wa	ter Depths:	Offset well records. Dep	oths have been adj	usted accordi	ng to surface elevations.
14) Approximate Saltw	ater Depths:	727', 2051'	, 2134'			***************************************
15) Approximate Coal	Seam Depth:	s: 107', 712	', 1734'			
16) Approximate Depth	to Possible	Void (coal m	nine, karst, other):	None anticipat	ed	
17) Does Proposed wel directly overlying or ad				No.	x	Received
(a) If Yes, provide Mi	ine Info: N	ame:				11AV 2 9 2015
	D	epth:				WIAT 23 Edia
	So	eam:				Office of Oil and Gas
	0	wner:			WV	Dept. of Environmental Protect

WW-6B (04/15) API NO. 47- 095

OPERATOR WELL NO. Rymer Unit 2H
Well Pad Name: Existing Date Pad

18)

CASING AND TUBING PROGRAM

TYPE	Size (in)	New or Used	Grade	Weight per ft. (lb/ft)	FOOTAGE: For Drilling (ft)	INTERVALS: Left in Well (ft)	CEMENT: Fill-up (Cu. Ft.)/CTS
Conductor	20"	New	H-40	94#	40'	40'	CTS, 38 Cu. Ft.
Fresh Water	13-3/8"	New	J-55/H-40	54.5#/48#	445'	445' *see #19	CTS, 618 Cu. Ft.
Coal	9-5/8"	New	J-55	36#	2550'	2550'	CTS, 1038 Cu. Ft.
Intermediate				ALCOHOL STREET			<u> </u>
Production	5-1/2"	New	P-110	20#	17,700'	17,700'	4475 Cu. Ft.
Tubing	2-3/8"	New	N-80	4.7#		7100'	
Liners					-		

MD 60-15

TYPE	Size (in)	Wellbore Diameter (in)	Wall Thickness (in)	Burst Pressure (psi)	Anticipated Max. Internal Pressure (psi)	Cement Type	Cement Yield (cu. ft./k)
Conductor	30"	24"	0.438"	1530	50	Class A	1.18
Fresh Water	13-3/8"	17-1/2"	0.38"/0.33"	2730/1730	1000	Class A	1.18
Coal	9-5/8"	12-1/4"	0.352"	3520	1500	Class A	1.18
Intermediate							
Production	5-1/2"	8-3/4" & 8-1/2"	0.361"	12,630	2500	Lead-HPOZ & Tall - H	H/POZ-1.44 & H-1.8
Tubing	2-3/8"	4.778"	0.19"	11,200			
Liners						- (e) : e	

PACKERS

Kind:	N/A	Pageiyed
Sizes:	N/A	Received
Depths Set:	N/A	MAY 2 9 2015

Office of Oil and Gas
WV Dept. of Environmental Protection

WW-6B (10/14)

API NO. 47- 095

OPERATOR WELL NO. Rymer Unit 2H

Well Pad Name: Edsting Date Pad

19) Describe proposed well work, including the drilling and plugging back of any pilot hole:

Drill, perforate, fracture a new horizontal shallow well and complete Marcellus Shale.

*Antero will be air drilling the fresh water string which makes it difficult to determine when freshwater is encountered, therefore we have built in a buffer for the casing setting depth which helps to ensure that all fresh water zones are covered.

20) Describe fracturing/stimulating methods in detail, including anticipated max pressure and max rate:

Antero plans to pump Slickwater into the Marcellus Shale formation in order to ready the well for production. The fluid will be comprised of approximately 99 percent water and sand, with less than 1 percent special-purpose additives as shown in the attached "List of Anticipated Additives Used for Fracturing or Stimulating Well."

Anticipated Max Pressure - 9300 lbs Anticipated Max Rate - 80 bpm

- 21) Total Area to be disturbed, including roads, stockpile area, pits, etc., (acres): 38.32 existing acres
- 22) Area to be disturbed for well pad only, less access road (acres): 5.68 existing acres

23) Describe centralizer placement for each casing string:

Conductor: no centralizers

Surface Casing: one centralizer 10' above the float shoe, one on the insert float collar and one every 4th joint spaced up the hole

Intermediate Casing: one centralizer above float joint, one centralizer 5' above float collar and one every 4th collar to surface.

Production Casing: one centralizer at shoe joint and one every 3 joints to top of cement in intermediate casing.

24) Describe all cement additives associated with each cement type:

Received

Conductor: no additives, Class A cement.

Surface: Class A cement with 2-3% calcium chloride

Intermediate: Class A cement with 1/4 lb of flake, 5 gallons of clay treat

Production: Lead cement- 50/50 Class H/Poz + 1.5% salt + 1% C-45 + 0.5% C-16a + 0.2% C-12 + 0.45% C-20 + 0.05% C-51

Production: Tall cement- Class H + 45 PPS Calcium Carbonate + 1.0% FL-160 + 0.2% ACGB-47 + 0.05% ACSA-51 + 0.2% ACR-20

Office of Oil and Gab

MAY 2 9 2015

WV Dept. of Environmental Protection

25) Proposed borehole conditioning procedures:

Conductor: blowhole clean with air, run casing, 10 bbls fresh water.

Surface: błowhole clean with air, trip to conductor shoe, trip to bottom, blowhole clean with air, trip out, run casing, circulate pipe capacity + 40 bbls fresh water followed by 25 bbls bentonite mud, 10 bbls fresh water spacer.

Intermediate: blowhole clean with air, trip to surface casing shoe, trip to bottom, blowhole clean with air, trip out, run casing, circulate 40 bbls brine water followed by 10 bbls fresh water and 25 bbls bentonite mud, pump 10 bbls fresh water.

Production: circulate with 14 lb/gal NaCl mud, trip to middle of lateral, circulate, pump high viscosity sweep, trip to base of curve, pump high viscosity sweep, trip to top of curve, trip to bottom, circulate, pump high viscosity sweep, trip out, run casing, circulate 10 bbls fresh water, pump 48 bbls barite pill, pump 10 bbls fresh water followed by 48 bbls mud flush and 10 bbls water.

*Note: Attach additional sheets as needed.

Page 3 of 3

WW-9 (2/15)

PI Number	47	-	095	
-----------	----	---	-----	--

Operator's Well No. Rymer Unit 2H STATE OF WEST VIRGINIA DEPARTMENT OF ENVIRONMENTAL PROTECTION OFFICE OF OIL AND GAS

FLUIDS/ CUTTINGS DISPOSA	AL & RECLAMATION PLAN
Operator Name Antero Resources Corporation	OP Code 494488557
Watershed (HUC 10) Headwaters Middle Island Creek	Quadrangle Shirley 7.5'
Do you anticipate using more than 5,000 bbls of water to complete Will a pit be used? Yes No	the proposed well work? Yes No
If so, please describe anticipated pit waste: No pit will be used at	his site (Drilling and Flowback Fluids will be stored in tanks. Cuttings will be tanked and haufed off site.
Will a synthetic liner be used in the pit? Yes N	nis site (Drilling and Flowback Fluids will be slored in tanks. Cuttings will be tanked and hauded off site. If so, what ml.? N/A MA S-08-15
Proposed Disposal Method For Treated Pit Wastes:	28-13
Will closed loop system be used? If so, describe: Yes	
Drilling medium anticipated for this well (vertical and horizontal)?	Air, freshwater, oil based, etc. Surface - Air/Freshwater, hearmediate-Dust/Stiff Foam, Production - Water Based Mand
-If oil based, what type? Synthetic, petroleum, etc. N/A	
Additives to be used in drilling medium? Please See Attachment	The state of the s
Drill cuttings disposal method? Leave in pit, landfill, removed offs	ite, etc. Stored in tanks, removed offsite and taken to landfill.
-If left in pit and plan to solidify what medium will be used	1? (cement, lime, sawdust) N/A
-Landfill or offsite name/permit number? Meadowfill Landf	ill (Permit #SWF-1032-98)
Permittee shall provide written notice to the Office of Oil and Gas of West Virginia solid waste facility. The notice shall be provided with where it was properly disposed.	
on August 1, 2005, by the Office of Oil and Gas of the West Virgin provisions of the permit are enforceable by law. Violations of any law or regulation can lead to enforcement action.	we term or condition of the general permit and/or other applicable amined and am familiar with the information submitted on this a my inquiry of those individuals immediately responsible for accurate, and complete. I am aware that there are significant
Company Official (Typed Name) Evan Foster	NATALIE KOMP
Company Official Title Environmental Representative	STATE OF COLORADO NOTARY ID # 20144028170
_	TOOMMISSION EXPIRES JULY 18, 2018
Subscribed and sworn before me this 18th day of M	avy , 20 15
rather il	Notary Public MAY 2 9 2015
My commission expires with 18th, 2016	
	Office of Oil and Gas WV Dept. of Environmental Protection

Operator's Well No. Rymer Unit 2H

Proposed Revegetation Treatme	nt: A area Dietrola 1 38 32	P	
		Prevegetation	1 рн
Lime 2 - 3	Tons/acre or to correct to pl		
Fertilizer type Hay or si	traw or Wood Fiber (will be used	where needed)	
Fertilizer amount 500		lbs/acre	
Mulch 2-3	Tons		
Road "A" (17.71) + Access Road "B" "B" (1.17) \	Water Containment Pad (1.41) + Exce	Ingraded Existing Access Road (0.93) + Stress/Top Soil Material Stockpiles (4.60) = 3 ed Mixtures	aging Area "A" (0.75) + Well Pad (5.68) + Stag 18.32 Existing Acres
Temp	orary		manent
Seed Type	lbs/acre	Seed Type	lbs/acre
Annual Ryegrass	40	Crownvetch	10-15
*See attached Table 3 for additional seed		*See attached Table 4a for additional	seed type (Dale Pad Design Page 30)
*or type of grass seed reque	sted by surface owner	*or type of grass seed rec	quested by surface owner
*	No Fescue or Timoth	hy Grass Shall Be Used	
Drawing(s) of road, location, pit provided)		pplication (unless engineered plans	including this info have been
Drawing(s) of road, location, pit provided)		pplication (unless engineered plans	s including this info have been
Drawing(s) of road, location, pit provided) Photocopied section of involved		pplication (unless engineered plans	s including this info have been
Drawing(s) of road, location, pit provided) Photocopied section of involved Plan Approved by:	7.5' topographic sheet.		
Drawing(s) of road, location, pit provided) Photocopied section of involved Plan Approved by:	7.5' topographic sheet.		
Drawing(s) of road, location, pit provided) Photocopied section of involved Plan Approved by: Mich Comments: Preseec	7.5' topographic sheet.	any disturbe	
Plan Approved by: Comments: Prese	7.5' topographic sheet.		
Drawing(s) of road, location, pit provided) Photocopied section of involved Plan Approved by: Mich Comments: Preseec	7.5' topographic sheet.		
Drawing(s) of road, location, pit provided) Photocopied section of involved Plan Approved by: Mich Comments: Preseec	7.5' topographic sheet.		
Drawing(s) of road, location, pit provided) Photocopied section of involved Plan Approved by: Mich Comments: Preseec	7.5' topographic sheet.		
Drawing(s) of road, location, pit provided) Photocopied section of involved Plan Approved by: Mich Comments: Preseec	7.5' topographic sheet.		
Drawing(s) of road, location, pit provided) Photocopied section of involved Plan Approved by: Mich Comments: Presect As necessa	7.5' topographic sheet.	any disturbe	areas rade s-n-s Received
Drawing(s) of road, location, pit provided) Photocopied section of involved Plan Approved by: Mich Comments: Presect As necessa	7.5' topographic sheet. and Doff of A Mulch Pregs. M.		areas rade s-n-s Received

Form WW-9 Additives Attachment

SURFACE INTERVAL

- 1. Fresh Water
- 2. Soap -Foamer AC
- 3. Air

INTERMEDIATE INTERVAL

STIFF FOAM RECIPE:

- 1) 1 ppb Soda Ash / Sodium Carbonate-Alkalinity Control Agent
- 2) 1 ppb Conqor 404 (11.76 ppg) / Corrosion Inhibitor
- 3) 4 ppb KLA-Gard (9.17 ppg) / Amine Acid Complex-Shale Stabilizer
- 4) 1ppb Mil Pac R / Sodium Carboxymethylcellulose-Filtration Control Agent
- 5) 12 ppb KCL / Potassium Chloride-inorganic Salt
- 6) Fresh Water 80 bbls
- 7) Air

PRODUCTION INTERVAL

1. Alpha 1655

Salt Inhibitor

2. Mil-Carb

Calcium Carbonate

3. Cottonseed Hulls

Cellulose-Cottonseed Pellets – LCM

4. Mil-Seal

Vegetable, Cotton & Cellulose-Based Fiber Blend – LCM

5. Clay-Trol

Amine Acid Complex - Shale Stabilizer

6. Xan-Plex

Viscosifier For Water Based Muds

7. Mil-Pac (All Grades)

Sodium Carboxymethylcellulose - Filtration Control Agent

8. New Drill

Anionic Polyacrylamide Copolymer Emulsion - Shale Stabilizer

9. Caustic Soda

Sodium Hydroxide - Alkalinity Control

10. Mil-Lime

Calcium Hydroxide – Lime

11. LD-9

Polyether Polyol – Drilling Fluid Defoamer

12. Mil Mica

Hydro-Biotite Mica – LCM

Received Office of Oli & Gas MAY . 2 2 2015

13. Escaid 110

Drilling Fluild Solvent - Aliphatic Hydrocarbon

14. Ligco

Highly Oxidized Leonardite - Filteration Control Agent

15. Super Sweep

Polypropylene - Hole Cleaning Agent

16. Sulfatrol K

Drilling Fluid Additive - Sulfonated Asphalt Residuum

17. Sodium Chloride, Anhydrous

Inorganic Salt

18. D-D

Drilling Detergent - Surfactant

19. Terra-Rate

Organic Surfactant Blend

20. W.O. Defoam

Alcohol-Based Defoamer

21. Perma-Lose HT

Fluid Loss Reducer For Water-Based Muds

22. Xan-Plex D

Polysaccharide Polymer - Drilling Fluid Viscosifier

23. Walnut Shells

Ground Cellulosic Material - Ground Walnut Shells - LCM

24. Mil-Graphite

Natural Graphite – LCM

25. Mil Bar

Barite - Weighting Agent

26. X-Cide 102

Biocide

27. Soda Ash

Sodium Carbonate – Alkalinity Control Agent

28. Clay Trol

Amine Acid complex - Shale Stabilizer

29. Sulfatrol

Sulfonated Asphalt - Shale Control Additive

30. Xanvis

Viscosifier For Water-Based Muds

31. Milstarch

Starch - Fluid Loss Reducer For Water Based Muds

32. Mil-Lube

Drilling Fluid Lubricant

Received
Office of Oil & Gas
MAY: 9 9 1915

09502270



911 ADDRESS 527 Conaway Run Road Alma, WV 26320

Well Site Safety Plan **Antero Resources**

Well Name: Johnson Unit 1H, Johnson Unit 2H, Johnson Unit 3H,

Sage Unit 1H, Sage Unit 2H, Jug Unit 1H, Jug Unit 2H

Method 150 (API# 47-095-02171), Rymer Unit 1H, Rymer Unit 2H,

Rymer Unit 3H

Pad Location: DALE PAD

Tyler County/ Centerville District

GPS Coordinates: Lat 39°25'55.36"/Long 80°51'44.42" (NAD83)


Driving Directions:

From Clarksburg, WV to Access Road A: Drive west on US 50 West for 25.4 miles. Turn right onto WV-18 North and go 0.6 miles. Turn left onto Davis Street/Old US 50 West. Continue to follow Davis Street for 0.4 miles. At West Union, turn right onto WV-18 North/Sistersville Pike. Continue to follow WV-18 North for 16.7 miles. Once in Centerville, turn left onto CR 48/Conaway Run Road and continue for 0.6 miles. Turn right onto Access Road and continue left when Access Road splits.

From Clarksburg, WV to Access Road B: Drive west on US 50 West for 25.4 miles. Turn right onto WV-18 North and go 0.6 miles. Turn left onto Davis Street/Old US 50 West. Continue to follow Davis Street for 0.4 miles. At West Union, turn right onto WV-18 North/Sistersville Pike. Continue to follow WV-18 North for 16.8 miles. Once in Centerville, turn left onto CR 48/Klondike Ridge and continue for 0.2 miles. Turn left onto Wheeler's Run for 1.6 miles. Access Road will be on the left.

EMERGENCY (24 HOUR) CONTACT 1-800-878-1373
Received


MAY 2 9 2015

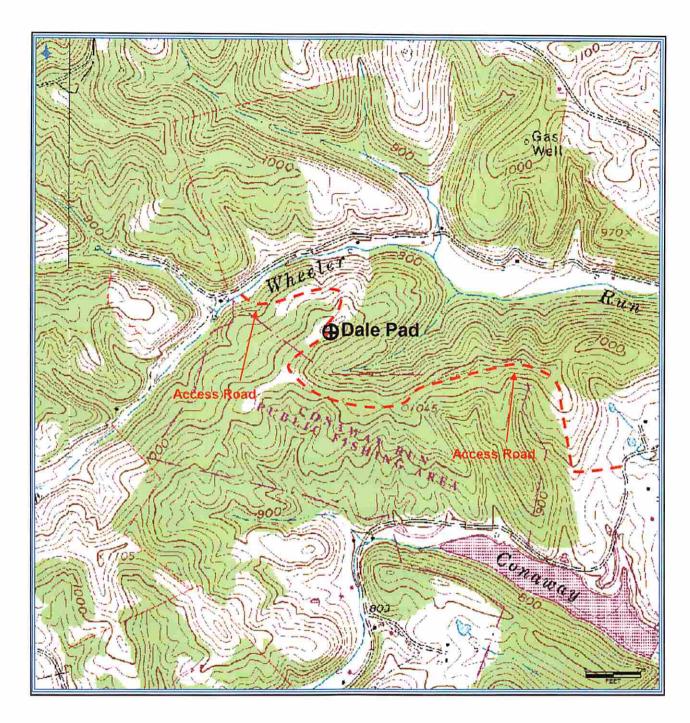

Antero Resources Corporation

Appalachian Basin
Rymer Unit 2Heceived
Tyler County of Oil 8, Gas

Watershed: Headwaters Middle Island Greek
District: Centerville
Date: 3-5-14

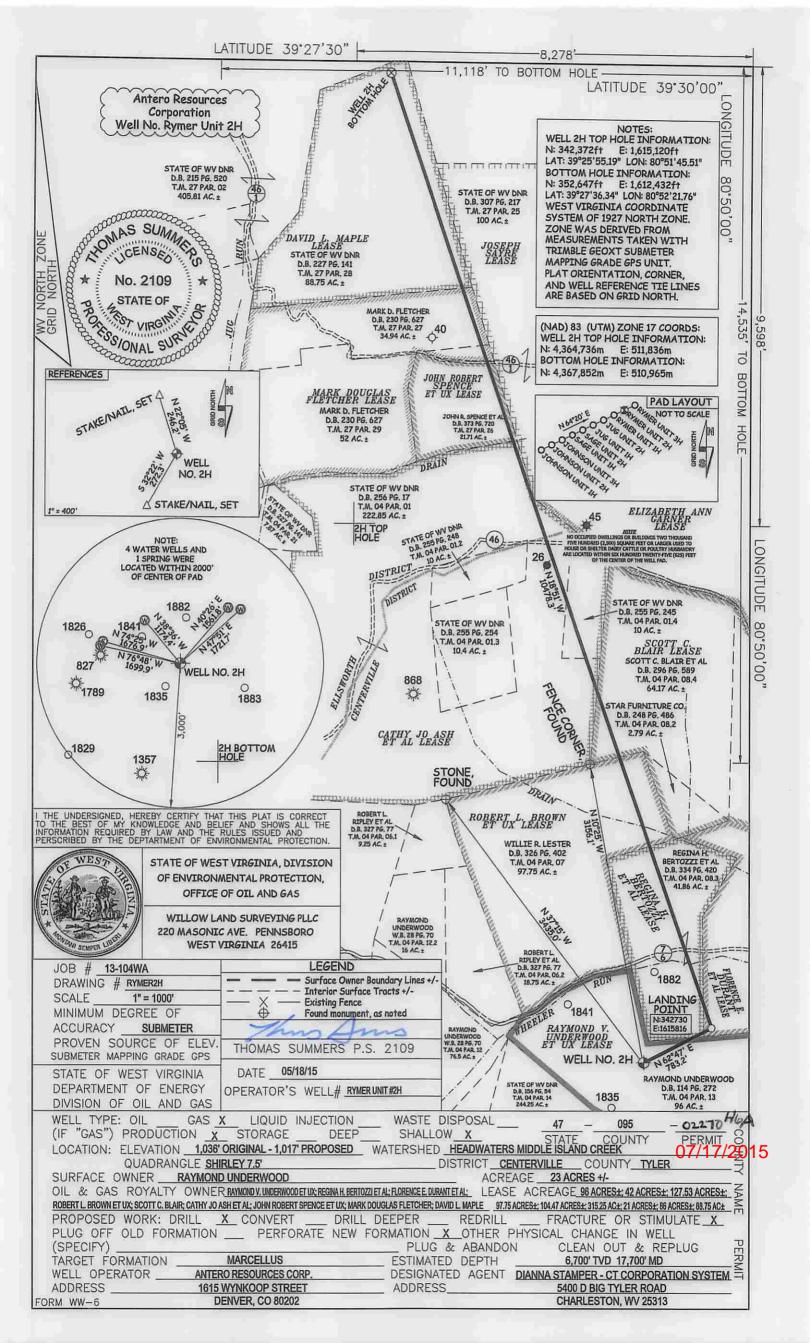

Operator's Well Number

Rymer Unit 2H

INFORMATION SUPPLIED UNDER WEST VIRGINIA CODE Chapter 22, Article 6A, Section 5(a)(5) IN LIEU OF FILING LEASE(S) AND OTHER CONTINUING CONTRACT(S)

Under the oath required to make the verification on page 1 of this Notice and Application, I depose and say that I am the person who signed the Notice and Application for the Applicant, and that –

- (1) the tract of land is the same tract described in this Application, partly or wholly depicted in the accompanying plat, and described in the Construction and Reclamation Plan;
- (2) the parties and recordation data (if recorded) for lease(s) or other continuing contract(s) by which the Applicant claims the right to extract, produce or market the oil or gas are as follows:

Grantor, lessor, etc.	Grantee, lessee, etc.	Royalty	Book/Page
Raymond V. Underwood, et ux Lease			
Raymond V. Underwood, et ux	Tyler Pipeline, Inc.	1/8	0338/0440
Tyler Pipeline, Inc.	Sancho Oil & Gas Corp.	Assignment	0375/0773
Sancho Oil & Gas Corp.	Trans Energy	Assignment	0375/0792
Trans Energy	Antero Resources Corporation	Assignment	0436/0177
Regina H. Bertozzi, et al Lease			
Regina H. Bertozzi, et al	Sancho Oil and Gas Corporation	1/8	0351/0816
Sancho Oil and Gas Corporation	Antero Resources Corporation	Assignment	0436/0177
Florence E. Durant, et al Lease			
Florence E. Durant, et al	Trans Energy, Inc. and Republic Energy Ventures LLC	1/8+	0386/0391
Trans Energy, Inc.	American Shale Development, Inc.	Assignment	0396/0331
American Shale Development, Inc. & Republic Energy Ventures, LLC	Antero Resources Corporation	Assignment	0436/0177
Robert L. Brown, et ux Lease			
Robert Brown, et ux	Antero Resources Corporation	1/8+	0437/0583
Scott C. Blair Lease			
Scott C. Blair, et ux	Chesapeake Appalachia, LLC	1/8	0400/0365
Chesapeake Appalachia, LLC	Antero Resources Corporation	Assignment	0460/0567
Cathy Jo Ash, et al Lease	Andrew Bresseres American Companyation	4 /0 .	0415/0440
Cathy Jo Ash	Antero Resources Appalachian Corporation Antero Resources Corporation	1/8+ Name Change	0415/0119 Exhibit 1
Antero Resources Appalachian Resources	Antero Resources Corporation	Name Change	EXHIDIC T
<u>Elizabeth Ann Garner Lease</u> Elizabeth Ann Garner	Chesapeake Appalachia, LLC	1/8	0371/0119
Chesapeake Appalachia, LLC	Antero Resources Corporation	Assignment	0442/0615
Joseph Sayre Lease			
Joseph Sayre	Antero Resources Appalachian Corporation	1/8	0395/0322
Antero Resources Appalachian Corporation	Antero Resources Corporation	Name Change	Exhibit 1
John Robert Spence, et ux Lease	Autora Bassinas Ausalashian Companian		0402/0676
John Robert Spence and Millicent Sue Spence Joint Living Trust dated 10-29-2009, John Robert	Antero Resources Appalachian Corporation	1/8+ Clar On 1/5	0402/0676
Spence as Trustee and Millicent Sue Spence as		6, 65, 50, c	
Trustee		Mon 1 8 h	
Antero Resources Appalachian Corporation	Antero Resources Corporation	Name Change 1/8+ Name Change 1/8+ Name Change Name Change Name Change	Exhibit 1
<u>Mark Douglas Fletcher Lease</u> Mark D. Fletcher		1/8+	0426/0834
INIGIR D. FRECCIEF	Antero Resources Corporation	4/0∓	V-120/ V037

^{*}Partial Assignments to Antero Resources Corporation include 100% rights to extract, produce and market the oil and gas from the Marcellus and any other formations completed with this well.

07/17/2015

WW-6A1 (5/13)

Operator's Well No. Rymer Unit 2H

INFORMATION SUPPLIED UNDER WEST VIRGINIA CODE Chapter 22, Article 6A, Section 5(a)(5) IN LIEU OF FILING LEASE(S) AND OTHER CONTINUING CONTRACT(S)

Under the oath required to make the verification on page 1 of this Notice and Application, I depose and say that I am the person who signed the Notice and Application for the Applicant, and that –

- (1) the tract of land is the same tract described in this Application, partly or wholly depicted in the accompanying plat, and described in the Construction and Reclamation Plan;
- (2) the parties and recordation data (if recorded) for lease(s) or other continuing contract(s) by which the Applicant claims the right to extract, produce or market the oil or gas are as follows:

Number	Grantor, Lessor, etc.	Grantee, Lessee, etc.	Royalty	Book/Page
David L. Maple Lease				
	David L. Maple, a married man dealing with his sole and separate property	Antero Resources Appalachian Corporation	1/8+	0394/0177
	Antero Resources Appalachian Corporation	Antero Resources Corporation	Name Change	Exhibit 1

Acknowledgement of Possible Permitting/Approval In Addition to the Office of Oil and Gas

The permit applicant for the proposed well work addressed in this application hereby acknowledges the possibility of the need for permits and/or approvals from local, state, or federal entities in addition to the DEP, Office of Oil and Gas, including but not limited to the following:

- WV Division of Water and Waste Management
- WV Division of Natural Resources WV Division of Highways
- U.S. Army Corps of Engineers
- U.S. Fish and Wildlife Service
- County Floodplain Coordinator

The applicant further acknowledges that any Office of Oil and Gas permit in no way overrides, replaces, or nullifies the need for other permits/approvals that may be necessary and further affirms that all needed permits/approvals should be acquired from the appropriate authority before the affected activity is initiated.

Well Operator:	Antero Resources Corporation Received Gas
By:	Kevin Kilstrom
Its:	Vice President of Production 22



JUN 1 0 2013

Natalie E. Tennant. Secretary of State 1900 Kanawha Bivd E Bldg 1, Suite 157-K Charleston, WV 25305

FILE ONE ORIGINAL (Two if you want a filed stamped copy returned to you) FEE: \$25:00



Penney Barker, Manager
IN THE OFFICE OF Corporations Division
ECRETARY OF STATE Pax: (304)558-8000
Website: www.wvsos.com
E-mall: business@wvsos.com

Office Hours: Monday - Friday 8:30 a.m. - 5:00 p.m. ET

APPLICATION FOR AMENDED CERTIFICATE OF AUTHORITY.

**** In accordance with the provisions of the West Virginia Code, the undersigned corporation hereby **** applies for an Amended Certificate of Authority and submits the following statement:

1.	Name under which the corporation was authorized to transact business in WV:	Antero Resources Appalachian Corporation	, v
2.	Date Certificate of Authority was issued in West Virginia:	6/25/2008	
3.	Corporate name has been changed to: (Attach one Certified Conv of Name Change as filed in home State of incorporation.)	Antero Resources Corporation	2
4.	Name the corporation elects to use in WV: (due to home state name not being available)	Antero Resources Corporation	
5.	Other amendments: (attach additional pages if necessary)		υX
ıż.), the second of		
	1		_ *
6.	Name and phone number of contact person. (the filing, listing a contact person and phone num document.)	(This is optional, however, if there is a problem with mber may avoid having to return or reject the	e4 7
	Alvyn A. Schopp	(303) 367-7310	* *
	Contact Name	Phone Number	
7.	Signature information (See below *Important) Print Name of Signer: Abyn A. Schopp	Title/Capacity: Authorized Person	341
	Signature: 47571 Chapp	Date: June 10, 2013	
Any	portant Leval Notice Reparative Standard: For West Virgit person who signs a document he or she knows is false in an e accretary of state for filing is guilty of a misdomesmor and, wand dollars or confined in the county or regional jall not me	Office OI O'	& Gas
Porm	CP-4 Issued by the Office	ico of the Secretary of Sixto	: CIU.



May 14, 2015

Antero Resources 1615 Wynkoop Street Denver, CO 80202 Office 303.357.7310 Fax 303.357.7315

West Virginia Department of Environmental Protection Chief, Office of Oil and Gas Attn: Mr. James Martin 601 57th Street SE Charleston, WV 25304

RE:

Rymer Unit 2H

Quadrangle: Shirley 7.5'

Tyler County/Centerville District, West Virginia

Mr. Martin:

Antero Resources Corporation (Antero) is submitting the following application for a new well work permit for the Rymer Unit 2H horizontal shallow well. As an authorized representative, I certify that Antero has the right to extract, produce or market the oil or gas for all leases through which the Rymer Unit 2H horizontal lateral will drill through including any and all roads crossed under as identified on the attached survey plat.

Sincerely,

Jared Hurst Senior Landman

Received
Office of Oil & Gas
MAY 2 2 2015

STATE OF WEST VIRGINIA DEPARTMENT OF ENVIRONMENTAL PROTECTION, OFFICE OF OIL AND GAS NOTICE CERTIFICATION

Date of Notic	e Certification: 05/21/2015		API N	0. 47 0 . 9	5.0	2270
		_		or's Well N		
				ad Name: _		
Notice has b				_		
Pursuant to th	e provisions in West Virginia Co	ode §	22-6A, the Operator has provided th	e required pa	arties w	ith the Notice Forms listed
	tract of land as follows:					
State:	West Virginia		UTM NAD 83 Easting			
County:	Tyler		Northii			
District:	Centerville		Public Road Access:	CR 7/6 8		
Quadrangle:	Shirley 7.5'		Generally used farm nam	ie: Underwo	ood, Rayı	mond
Watershed:	Headwaters Middle Island Creek					
requirements Virginia Code of this article	of subsection (b), section sixtee § 22-6A-11(b), the applicant shape been completed by the appl	en of all te licant		by the surf	face ow notice	ner; and Pursuant to West
	West Virginia Code § 22-6A, the rator has properly served the req		rator has attached proof to this Noti parties with the following:	ce Certificat	tion	
*PLEASE CHE	CK ALL THAT APPLY					OOG OFFICE USE ONLY
☐ 1. NOT	TICE OF SEISMIC ACTIVITY	or	■ NOTICE NOT REQUIRED BE SEISMIC ACTIVITY WAS COND)	RECEIVED/ NOT REQUIRED
■ 2. NO	TICE OF ENTRY FOR PLAT SU	JRV	EY or 🔲 NO PLAT SURVEY WA	S CONDUC	CTED	☐ RECEIVED
☐ 3. NOT	TICE OF INTENT TO DRILL	or	■ NOTICE NOT REQUIRED BE NOTICE OF ENTRY FOR PLAT S WAS CONDUCTED or			☐ RECEIVED/ NOT REQUIRED
			☐ WRITTEN WAIVER BY SUF (PLEASE ATTACH)	RFACE OW	NER	
■ 4. NO	TICE OF PLANNED OPERATION	NC				☐ RECEIVED
5. PUB	LIC NOTICE					□ RECEIVED
■ 6. NO	FICE OF APPLICATION					☐ RECEIVED

Required Attachments:

The Operator shall attach to this Notice Certification Form all Notice Forms and Certifications of Notice that have been provided to the required parties and/or any associated written waivers. For the Public Notice, the operator shall attach a copy of the Class II Legal Advertisement with publication date verification or the associated Affidavit of Publication. The attached Notice Forms and Certifications of Notice shall serve as proof that the required parties have been noticed as required under West Virginia Code § 22-6A. Pursuant to West Virginia Code § 22-6A-11(b), the Certification of Notice to the person may be made by affidavit of personal service, the return receipt card or other postal receipt for certified mailing.

09502270

Certification of Notice is hereby given:

THEREFORE, 1		ave read a	nd understand	the notice requirements within West Virginia Code § 22-
6A. I certify that	at as required under West Virginia	Code § 22	-6A, I have so	erved the attached copies of the Notice Forms, identified
above, to the re	equired parties through personal ser	rvice, by r	egistered mail	or by any method of delivery that requires a receipt or
				examined and am familiar with the information submitted
				nquiry of those individuals immediately responsible for
				d complete. I am aware that there are significant penalties
for submitting fa	alse information, including the possi	bility of fi	ne and impriso	onment.
W. H.O.	- 4			
Well Operator:	Antero Resources Corporation		Address:	1615 Wynkoop Street
By:	Kevin Kilstrom	ton		Denver, CO 80202
Its:	VP of Production		Facsimile:	303-357-7315
Telephone:	303-357-7310		Email:	asteele@anteroresources.com
f				215
	NOTARY SEAL	Subse	cribed and swo	om before me this 21st lay of May 2015.
	NATALIE KOMP	1	1 01 to 0.	in K >
	NOTARY PUBLIC		1 CO MICE	Notary Public
	TARY ID # 20144028170			Halas 10 AMO
	ISSION EXPIRES JULY 18, 2018	My C	Commission Ex	cpires 0 VVVV 181. DV V8

Oil and Gas Privacy Notice:

The Office of Oil and Gas processes your personal information, such as name, address and telephone number, as part of our regulatory duties. Your personal information may be disclosed to other State agencies or third parties in the normal course of business or as needed to comply with statutory or regulatory requirements, including Freedom of Information Act requests. Our office will appropriately secure your personal information. If you have any questions about our use or your personal information, please contact DEP's Chief Privacy Officer at depprivacyofficer@wv.gov.

Office of Oil & Gas

WW-6A (9-13) 0 9 5 0 2 2 7 0

OPERATOR WELL NO. Rymer Unit 2H

Well Pad Name: Existing Dale Pad

STATE OF WEST VIRGINIA DEPARTMENT OF ENVIRONMENTAL PROTECTION, OFFICE OF OIL AND GAS NOTICE OF APPLICATION

Date of Notice: 5/21/2015 Date Permit Application Filed: 5/21/2015 Notice of: □ CERTIFICATE OF APPROVATION OF AN IM	
Delivery method pursuant to West Virginia Code § 22-6A-10(b)	
	EDELIVERY THAT REQUIRES A ESIGNATURE CONFIRMATION
certificate of approval for the construction of an impoundment or pit as requesistered mail or by any method of delivery that requires a receipt or signal sediment control plan required by section seven of this article, and the well the surface of the tract on which the well is or is proposed to be located; (2 oil and gas leasehold being developed by the proposed well work, if the surface tribed in the erosion and sediment control plan submitted pursuant to support or lessee, in the event the tract of land on which the well proposed more coal seams; (4) The owners of record of the surface tract or tracts over well work, if the surface tract is to be used for the placement, construction, impoundment or pit as described in section nine of this article; (5) Any surface a water well, spring or water supply source located within one thousand provide water for consumption by humans or domestic animals; and (6) The proposed well work activity is to take place. (c)(1) If more than three tenan subsection (b) of this section hold interests in the lands, the applicant may records of the sheriff required to be maintained pursuant to section eight, as provision of this article to the contrary, notice to a lien holder is not notice. Code R. § 35-8-5.7.a requires, in part, that the operator shall also provide water purveyor or surface owner subject to notice and water testing as provide water purveyor or surface owner subject to notice and water testing as provide water purveyor or surface owner subject to notice and water testing as provide water purveyor or surface owner subject to notice and water testing as provide water purveyor or surface owner subject to notice and water testing as provide water purveyor or surface owner subject to notice and water testing as provide water purveyor or surface owner subject to notice and water testing as provide water purveyor or surface owner subject to notice and water testing as provide water purveyor or surface owner subject to notice and water testing as provide the provide water p	ture confirmation, copies of the application, the erosion and plat to each of the following persons: (1) The owners of record of the surface tract or tracts overlying the reface tract is to be used for roads or other land disturbance as absection (c), section seven of this article; (3) The coal owner, I to be drilled is located [sic] is known to be underlain by one or trlying the oil and gas leasehold being developed by the proposed enlargement, alteration, repair, removal or abandonment of any face owner or water purveyor who is known to the applicant to and five hundred feet of the center of the well pad which is used to be operator of any natural gas storage field within which the test in common or other co-owners of interests described in serve the documents required upon the person described in the reticle one, chapter eleven-a of this code. (2) Notwithstanding any to a landowner, unless the lien holder is the landowner. W. Va. the Well Site Safety Plan ("WSSP") to the surface owner and any
☐ Application Notice ☐ WSSP Notice ☐ E&S Plan Notice ☐ Work ☐ SURFACE OWNER(s) ☐ CO	AL OWNER OR LESSEE
Name: Dale Underwood c/o Raymond V. Underwood Name Address: 12965 Emerson Avenue Addre	NO DECLARATIONS ON RECORD WITH COUNTY
Parkersburg, WV 26104	
	AL OPERATOR
Address: Name	e: NO DECLARATIONS ON RECORD WITH COUNTY
Addr	ess:
DISTURBANCE SHOWN ON PAD DESIGN ARE NOT OVERLYING THE OIL & GAS LEASEHOLD BEING DEVELOPED BY THE PROPOSED WELL, THEREFORE, IS NOT REQUIRED TO BE NOTIFIED PER WV CODE 22-6A-10. ANTERO HAS SECURED A SIGNED SUA WITH ALL RELATED PARTIES	TER PURVEYOR(s)/OWNER(s) OF WATER WELL, UNG OR OTHER WATER SUPPLY SOURCE E: Willie R. Lester E: P.O. Box 195 Baisden, WV 25608 ERATOR OF ANY NATURAL GAS STORAGE FIELD E: WATER SUPPLY SOURCE map, 4 other water sources are identified but they are located greater than 1500° from the subject well pad location)
Addr *Plea	ess: Received ess: Received use attach additional forms if Control of Oil & Gas

WW-6A (8-13) 09502270

OPERATOR WELL NO. Rymer Unit 2H

Well Pad Name: Existing Date Pad

Notice is hereby given:

Pursuant to West Virginia Code § 22-6A-10(b), notice is hereby given that the undersigned well operator has applied for a permit for well work or for a certificate of approval for the construction of an impoundment or pit.

This Notice Shall Include:

Pursuant to W. Va. Code § 22-6A-10(b), this notice shall include: (1) copies of the application; (2) the erosion and sediment control plan required by section seven of this article; and (3) the well plat.

Pursuant to W. Va. Code § 22-6A-10(f), this notice shall include: (1) a statement of the time limits for filing written comments; (2) who may file written comments; (3) the name and address of the secretary for the purpose of filing the comments and obtaining additional information; and (4) a statement that the persons may request, at the time of submitting written comments, notice of the permit decision and a list of persons qualified to test water.

Pursuant to W. Va. Code R. § 35-8-5.7.a, the operator shall provide the Well Site Safety Plan to the surface owner and any water purveyor or surface owner subject to notice and water testing as provided in section 15 of this rule.

Pursuant to W. Va. Code R. § 35-8-15.2.c, this notice shall: (1) contain a statement of the surface owner's and water purveyor's right to request sampling and analysis; (2) advise the surface owner and water purveyor of the rebuttable presumption for contamination or deprivation of a fresh water source or supply; advise the surface owner and water purveyor that refusal to allow the operator to conduct a pre-drilling water well test constitutes a method to rebut the presumption of liability; (3) advise the surface owner and water purveyor of his or her independent right to sample and analyze any water supply at his or her own expense; advise the surface owner and water purveyor whether or not the operator will utilize an independent laboratory to analyze any sample; and (4) advise the surface owner and or water purveyor that he or she can obtain from the Chief a list of water testing laboratories in the subject area capable of and qualified to test water supplies in accordance with standard acceptable methods.

Additional information related to horizontal drilling may be obtained from the Secretary, at the WV Department of Environmental Protection headquarters, located at 601 57th Street, SE, Charleston, WV 25304 (304-926-0450) or by visiting www.dep.wv.gov/oil-and-gas/pages/default.aspx.

Well Location Restrictions

Pursuant to W. Va. Code § 22-6A-12, Wells may not be drilled within two hundred fifty feet measured horizontally from any existing water well or developed spring used for human or domestic animal consumption. The center of well pads may not be located within six hundred twenty-five feet of an occupied dwelling structure, or a building two thousand five hundred square feet or larger used to house or shelter dairy cattle or poultry husbandry. This limitation is applicable to those wells, developed springs, dwellings or agricultural buildings that existed on the date a notice to the surface owner of planned entry for surveying or staking as provided in section ten of this article or a notice of intent to drill a horizontal well as provided in subsection (b), section sixteen of this article was provided, whichever occurs first, and to any dwelling under construction prior to that date. This limitation may be waived by written consent of the surface owner transmitted to the department and recorded in the real property records maintained by the clerk of the county commission for the county in which such property is located. Furthermore, the well operator may be granted a variance by the secretary from these distance restrictions upon submission of a plan which identifies the sufficient measures, facilities or practices to be employed during well site construction, drilling and operations. The variance, if granted, shall include terms and conditions the department requires to ensure the safety and protection of affected persons and property. The terms and conditions may include insurance, bonding and indemnification, as well as technical requirements. (b) No well pad may be prepared or well drilled within one hundred feet measured horizontally from any perennial stream, natural or artificial lake, pond or reservoir, or a wetland, or within three hundred feet of a naturally reproducing trout stream. No well pad may be located within one thousand feet of a surface or ground water intake of a public water supply. The distance from the public water supply as identified by the department shall be measured as follows: (1) For a surface water intake on a lake or reservoir, the distance shall be measured from the boundary of the lake or reservoir. (2) For a surface water intake on a flowing stream, the distance shall be measured from a semicircular radius extending upstream of the surface water intake. (3) For a groundwater source, the distance shall be measured from the wellhead or spring. The department may, in its discretion, waive these distance restrictions upon submission of a plan identifying sufficient measures, facilities or practices to be employed during well site construction, drilling and operations to protect the waters of the state. A waiver, if granted, shall impose any permit conditions as the secretary considers necessary. (c) Notwithstanding the foregoing provisions of this section, nothing contained in this section prevents an operator from conducting the activities permitted or authorized by a Clean Water Act Section 404 permit or other approval from the United States Army Corps of Engineers within any waters of the state or within the Careas referenced in this section. (d) The well location restrictions set forth in this section shall not apply to any well on a multiple wall pad a seast one of the wells was permitted prior to the effective date of this article. (e) The secretary shall, by this aber 31, 2012, report to the Legislature on the noise, light, dust and volatile organic compounds generated by the drilling of horizontal walls at the well location restrictions regarding occupied dwelling structures pursuant to this section. Upon a finding, if any, by the secretary that the well location restrictions regarding occupied dwelling structures are inadequate or otherwise require alteration to address the items

APIN 94509 2 2 7 N
OPERATOR WELL NO. Rymer Unit 2H

Well Pad Name: Existing Dale Pad

examined in the study required by this subsection, the secretary shall have the authority to propose for promulgation legislative rules establishing guidelines and procedures regarding reasonable levels of noise, light, dust and volatile organic compounds relating to drilling horizontal wells, including reasonable means of mitigating such factors, if necessary.

Water Well Testing:

Pursuant to West Virginia Code § 22-6A-10(d), notification shall be made, with respect to surface landowners identified in subsection (b) or water purveyors identified in subdivision (5), subsection (b) of this section, of the opportunity for testing their water well. The operator shall provide an analysis to such surface landowner or water purveyor at their request.

Water Testing Laboratories:

Pursuant to West Virginia Code § 22-6A-10(i), persons entitled to notice pursuant to subsection (b) of this section may contact the department to ascertain the names and locations of water testing laboratories in the subject area capable and qualified to test water supplies in accordance with standard accepted methods. In compiling that list of names the department shall consult with the state Bureau for Public Health and local health departments. A surface owner and water purveyor has an independent right to sample and analyze any water supply at his or her own expense. The laboratory utilized by the operator shall be approved by the agency as being certified and capable of performing sample analyses in accordance with this section.

Rebuttable Presumption for Contamination or Deprivation of a Fresh Water Source or Supply:

W. Va. Code § 22-6A-18 requires that (b) unless rebutted by one of the defenses established in subsection (c) of this section, in any action for contamination or deprivation of a fresh water source or supply within one thousand five hundred feet of the center of the well pad for horizontal well, there is a rebuttable presumption that the drilling and the oil or gas well or either was the proximate cause of the contamination or deprivation of the fresh water source or supply. (c) In order to rebut the presumption of liability established in subsection (b) of this section, the operator must prove by a preponderance of the evidence one of the following defenses: (1) The pollution existed prior to the drilling or alteration activity as determined by a predrilling or prealteration water well test. (2) The landowner or water purveyor refused to allow the operator access to the property to conduct a predrilling or prealteration water well test. (3) The water supply is not within one thousand five hundred feet of the well. (4) The pollution occurred more than six months after completion of drilling or alteration activities. (5) The pollution occurred as the result of some cause other than the drilling or alteration activity. (d) Any operator electing to preserve its defenses under subdivision (1), subsection (c) of this section shall retain the services of an independent certified laboratory to conduct the predrilling or prealteration water well test. A copy of the results of the test shall be submitted to the department and the surface owner or water purveyor in a manner prescribed by the secretary. (e) Any operator shall replace the water supply of an owner of interest in real property who obtains all or part of that owner's supply of water for domestic, agricultural, industrial or other legitimate use from an underground or surface source with a comparable water supply where the secretary determines that the water supply has been affected by contamination, diminution or interruption proximately caused by the oil or gas operation, unless waived in writing by that owner. (f) The secretary may order the operator conducting the oil or gas operation to: (1) Provide an emergency drinking water supply within twenty-four hours; (2) Provide temporary water supply within seventy-two hours; (3) Within thirty days begin activities to establish a permanent water supply or submit a proposal to the secretary outlining the measures and timetables to be used in establishing a permanent supply. The total time in providing a permanent water supply may not exceed two years. If the operator demonstrates that providing a permanent replacement water supply cannot be completed within two years, the secretary may extend the time frame on case-by-case basis; and (4) Pay all reasonable costs incurred by the real property owner in securing a water supply. (g) A person as described in subsection (b) of this section aggrieved under the provisions of subsections (b), (e) or (f) of this section may seek relief in court... (i) Notwithstanding the denial of the operator of responsibility for the damage to the real property owner's water supply or the status of any appeal on determination of liability for the damage to the real property owner's water supply, the operator may not discontinue providing the required water service until authorized to do so by the secretary or a court of competent jurisdiction.

Written Comment:

Pursuant to West Virginia Code § 22-6A-11(a), all persons described in subsection (b), section ten of this article may file written comments with the secretary as to the location or construction of the applicant's proposed well work within thirther application is filed with the secretary. All persons described in West Virginia Code § 22-6A-10(b) may the proposed well work to the location or construction of the applicant's proposed well work to the Secretary at:

Chief, Office of Oil and Gas
Department of Environmental Protection
601 57th St. SE
Charleston, WV 25304
(304) 926-0450

MAY, 2 2 2015

Such persons may request, at the time of submitting written comments, notice of the permit decision and a list of persons qualified to test water. NOTE: YOU ARE NOT REQUIRED TO FILE ANY COMMENT.

09502270

WW-6A (8-13)

API NO. 47- 095

OPERATOR WELL NO. Rymer Unit 2H

Well Pad Name: Existing Dale Pad

Time Limits and Methods for Filing Comments.

The law requires these materials to be served on or before the date the operator files its Application. You have **THIRTY (30) DAYS** after the filing date to file your comments. Comments must be filed in person or received in the mail by the Chief's office by the time stated above. You may call the Chief's office to be sure of the date. Check with your postmaster to ensure adequate delivery time or to arrange special expedited handling. If you have been contacted by the well operator and you have signed a "voluntary statement of no objection" to the planned work described in these materials, then the permit may be issued at any time.

Pursuant to West Virginia Code § 22-6A-11(c)(2), Any objections of the affected coal operators and coal seam owners and lessees shall be addressed through the processes and procedures that exist under sections fifteen, seventeen and forty, article six of this chapter, as applicable and as incorporated into this article by section five of this article. The written comments filed by the parties entitled to notice under subdivisions (1), (2), (4), (5) and (6), subsection (b), section ten of this article shall be considered by the secretary in the permit issuance process, but the parties are not entitled to participate in the processes and proceedings that exist under sections fifteen, seventeen or forty, article six of this chapter, as applicable and as incorporated into this article by section five of this article.

Comment Requirements

Your comments must be in writing and include your name, address and telephone number, the well operator's name and well number and the approximate location of the proposed well site including district and county from the application. You may add other documents, such as sketches, maps or photographs to support your comments.

Disclaimer: All comments received will be placed on our web site http://www.dep.wv.gov/oil-and-gas/Horizontal-Permits/Pages/default.aspx and the applicant will automatically be forwarded an email notice that such comments have been submitted. The applicant will be expected to provide a response to comments submitted by any surface owner, water purveyor or natural gas storage operator noticed within the application.

Permit Denial or Condition

The Chief has the power to deny or condition a well work permit. Pursuant to West Virginia Code § 22-6A-8(d), the permit may not be issued or be conditioned, including conditions with respect to the location of the well and access roads prior to issuance if the director determines that:

- (1) The proposed well work will constitute a hazard to the safety of persons;
- (2) The plan for soil erosion and sediment control is not adequate or effective;
- (3) Damage would occur to publicly owned lands or resources; or
- (4) The proposed well work fails to protect fresh water sources or supplies.

A permit may also be denied under West Virginia Code § 22-6A-7(k), the secretary shall deny the issuance of a permit if the secretary determines that the applicant has committed a substantial violation of a previously issued permit for a horizontal well, including the applicable erosion and sediment control plan associated with the previously issued permit, or a substantial violation of one or more of the rules promulgated under this article, and in each instance has failed to abate or seek review of the violation within the time prescribed by the secretary pursuant to the provisions of subdivisions (1) and (2), subsection (a), section five of this article and the rules promulgated hereunder, which time may not be unreasonable.

Pursuant to West Virginia Code § 22-6A-10(g), any person entitled to submit written comments to the secretary pursuant to subsection (a), section eleven of this article, shall also be entitled to receive from the secretary a copy of the permit as issued or a copy of the order modifying or denying the permit if the person requests receipt of them as a part of the written comments submitted concerning the permit application. Such persons may request, at the time of submitting written comments, notice of the permit decision and a list of persons qualified to test water.

Received
Office of Oil & Gas

MAY 2 2 2015

WW-6A (8-13) 0.9,502270

OPERATOR WELL NO. Rymer Unit 2H
Well Pad Name: Existing Dale Pad

Notice is hereby given by:

Well Operator: Antero Resources Corporation,
Telephone: (303) 357-7310

Email: asteele@anteroresources.com

Address: 1615 Wynkoop Street
Denver, CO 80202

Facsimile: 303-357-7315

Oil and Gas Privacy Notice:


The Office of Oil and Gas processes your personal information, such as name, address and telephone number, as part of our regulatory duties. Your personal information may be disclosed to other State agencies or third parties in the normal course of business or as needed to comply with statutory or regulatory requirements, including Freedom of Information Act requests. Our office will appropriately secure your personal information. If you have any questions about our use or your personal information, please contact DEP's Chief Privacy Officer at depprivacyofficer@wv.gov.

NATALIE KOMP
NOTARY PUBLIC
STATE OF COLORADO
NOTARY ID # 20144028170
MY COMMISSION EXPIRES JULY 18, 2018

Subscribed and sworn before me this 212

Notary Public

My Commission Expires

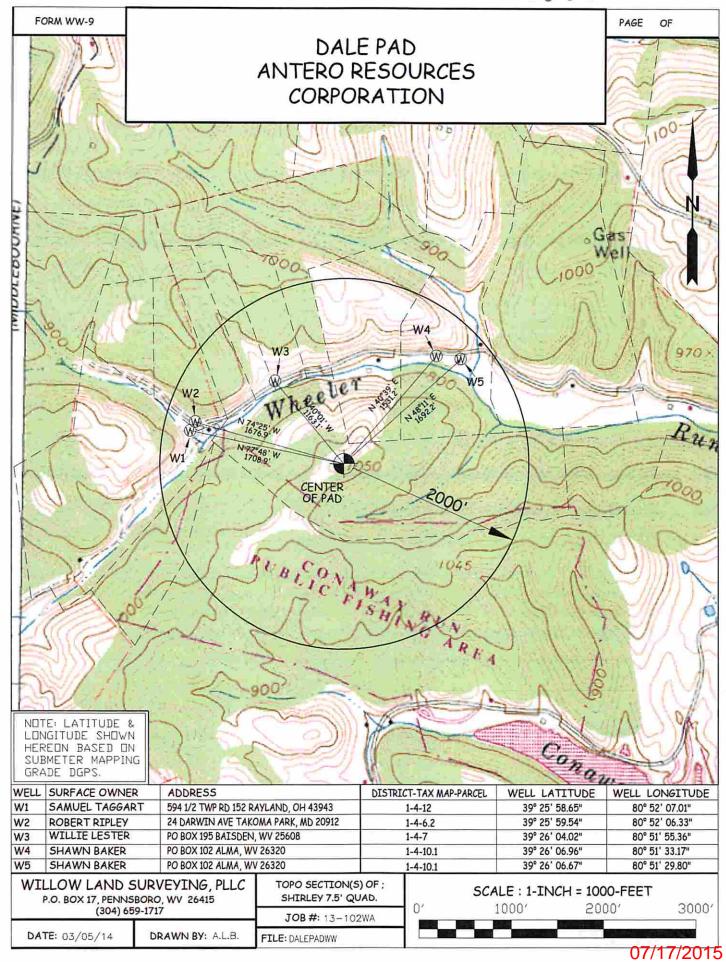

09502270

Operator Well No. Rymer Unit 2H Multiple Wells on the Dale Pad

STATE OF WEST VIRGINIA DEPARTMENT OF ENVIRONMENTAL PROTECTION, OFFICE OF OIL AND GAS NOTICE OF ENTRY FOR PLAT SURVEY

Notice Time Description at National II be said at the CEVEN (7) double to the CONTY PAGE (45) to

entry Date of Notice: 12/12/2013 Date of Planned Entry: 1	2/22/2013
Delivery method pursuant to West Virginia Code § 22-6A-1	0a
	HOD OF DELIVERY THAT REQUIRES A IPT OR SIGNATURE CONFIRMATION
on to the surface tract to conduct any plat surveys required purs but no more than forty-five days prior to such entry to: (1) The beneath such tract that has filed a declaration pursuant to sectio owner of minerals underlying such tract in the county tax recor- and Sediment Control Manual and the statutes and rules related	permit application, the operator shall provide notice of planned entry uant to this article. Such notice shall be provided at least seven days surface owner of such tract; (2) to any owner or lessee of coal seams in thirty-six, article six, chapter twenty-two of this code; and (3) any ds. The notice shall include a statement that copies of the state Erosion to oil and gas exploration and production may be obtained from the acluding the address for a web page on the Secretary's web site, to
Notice is hereby provided to:	
■ SURFACE OWNER(s)	☐ COAL OWNER OR LESSEE
Name: Dale Underwood, c/o Raymond V. Underwood	Name: NO DECLARATIONS ON RECORD WITH COUNTY
Address: 12965 Emerson Ave.	Name: NO DECLARATIONS ON RECORD WITH COUNTY Address:
North Parkersburg, WV 26104	
Name:	- America overence
Address:	■ MINERAL OWNER(s)
Nome	Name: Dale Underwood, c/o Raymond V. Underwood
Name: Address:	Address: 12965 Emerson Ave. North Parkersburg, WV 26104
Audiess,	*please attach additional forms if necessary
Notice is hereby given:	e atomor de sont accompany de la company
	given that the undersigned well operator is planning entry to conduct
a plat survey on the tract of land as follows: State: West Virginia	Approx. Latitude & Longitude: 39.432035, -80.862682 (NAD 83)
County: Tyles	Public Road Access: CR7/6 & CR 48
	Watershed: Wheeler Run
	Generally used farm name: Underwood, Dale
Copies of the state Erosion and Sediment Control Manual and t may be obtained from the Secretary, at the WV Department of	he statutes and rules related to oil and gas exploration and production Environmental Protection headquarters, located at 601 57 th Street, SE, nents or additional information related to horizontal drilling may be
Nation is housely given by:	
Notice is hereby given by:	Address: 1615 Wynkoop Street
Well Operator: Antero Resources Corporation	50 (42)
Telephone: (303) 357- 7310	Denver, CO 80202
Email: asteele@anteroresources.com	Facsimile: (303) 357-7315
Oil and Cas Britany Nation	Con al

The Office of Oil and Gas processes your personal information, such as name, address and telephone number, as part of our regulatory duties. Your personal information may be disclosed to other State agencies or third parties in the normal of business or as needed to comply with statutory or regulatory requirements, including Excelore of V. S. needed to comply with statutory or regulatory requirements, including Freedom of Information Act requests. Our office will appropriately secure your personal information. If you have any questions about our use or your personal information, please contact DEP's Chief Privacy Officer at depprivacyofficer@wv.gov.

WW-6A5 (1/12)

Operator Well No. Rymer Unit 2H

STATE OF WEST VIRGINIA DEPARTMENT OF ENVIRONMENTAL PROTECTION, OFFICE OF OIL AND GAS NOTICE OF PLANNED OPERATION

		equirement: notice shall be provided no l 05/21/2015 Date Permit App	later than the filing plication Filed: 05/2		application.
Delive	ry metho	od pursuant to West Virginia Code § 22	2-6A-16(c)		
			HAND DELIVERY		
return i the pla require drilling damage (d) The of notice	receipt re nned ope d to be p g of a ho es to the e notices ce.	quested or hand delivery, give the surface eration. The notice required by this sub- rovided by subsection (b), section ten of to rizontal well; and (3) A proposed surface surface affected by oil and gas operations	e owner whose land osection shall include this article to a surfa- te use and compens to the extent the da the surface owner a	will be used for de: (1) A copy ace owner whos ation agreemen mages are comp	cation, an operator shall, by certified mail or the drilling of a horizontal well notice of of this code section; (2) The information e land will be used in conjunction with the t containing an offer of compensation for pensable under article six-b of this chapter, ated in the records of the sheriff at the time
(at the	address 1	isted in the records of the sheriff at the time	ne of notice):		
		wood c/o Raymond V. Underwood	Name:		
Addres		merson Avenue	Address	i	
	Parkers	burg, WV 26104	-		
Pursuai	on on the $\frac{\sqrt{2}}{2}$: $\frac{1}{2}$	y given: st Virginia Code § 22-6A-16(c), notice is e surface owner's land for the purpose of Vest Virginia lyler Senterville Schridtey 7.5' leadwaters Middle Island Creek		I well on the tra- Easting: Northing: Access:	
Pursuanto be phorizor surface informatheadquess/pag	nt to We provided ntal well; affected ation rela	by W. Va. Code § 22-6A-10(b) to a su and (3) A proposed surface use and com by oil and gas operations to the extent atted to horizontal drilling may be obtain ocated at 601 57 th Street, SE, Charles lt.aspx.	orface owner whose inpensation agreement the damages are contend from the Secret	land will be unterested to the containing and compensable und ary, at the WV (304-926-0450)	code section; (2) The information required used in conjunction with the drilling of a offer of compensation for damages to the er article six-b of this chapter. Additional Department of Environmental Protection or by visiting

The Office of Oil and Gas processes your personal information, such as name, address and telephone number, as part of our regulatory duties. Your personal information may be disclosed to other State agencies or third parties in the normal course of business or as needed to comply with statutory or regulatory requirements, including Freedom of Information Act requests. Our office will appropriately secure your personal information. If you have any questions about our use or your personal information, please contact DEP's Chief Privacy Officer at depprivacyofficer@wv.gov. Received

Office of Oil & Gas

MAY. 2 2 2015



WEST VIRGINIA DEPARTMENT OF TRANSPORTATION

Division of Highways 1900 Kanawha Boulevard East • Building Five • Room 110

1900 Kanawha Boulevard East • Building Five • Room 110 Charleston, West Virginia 25305-0430 • (304) 558-3505

Paul A. Mattox, Jr., P. E. Secretary of Transportation/ Commissioner of Highways

March 4, 2014

James A. Martin, Chief Office of Oil and Gas Department of Environmental Protection 601 57th Street, SE Charleston, WV 25304

Subject: DOH Permit for the Dale Pad, Tyler County Rymer Unit 2H Well site

Dear Mr. Martin,

Earl Ray Tomblin

Governor

This well site will be accessed from a DOH permit #06-2014-0098 which has been applied for by Antero Resources Corporation for access to the State Road for a well site located off of Tyler County Route 7/6 SLS.

This operator is currently in compliance with the DOH OIL AND GAS POLICY dated January 3, 2012.

Very Truly Yours,

Gary K. Clayton, P.E.

Day L. Clayton

Regional Maintenance Engineer Central Office O&G Coordinator

Cc: Ashlie Mihalcin

Antero Resources Corporation

CH, OM, D-6

File

Received
Office of Oil & Gas

MAY 2 2 2015

List of Anticipated Additives Used for Fracturing or Stimulating Well

Additives	Chemical Abstract Service Number (CAS #)
Fresh Water	7732-18-5
2 Phosphobutane 1,2,4 tricarboxylic acid	37971-36-1
Ammonium Persulfate	7727-54-0
Anionic copolymer	proprietary
Anionic polymer	proprietary
BTEX Free Hydrotreated Heavy Naphtha	64742-48-9
Cellulase enzyme	(Proprietary)
Demulsifier Base	(Proprietary)
Ethoxylated alcohol blend	Mixture
Ethoxylated Nonylphenol	68412-54-4
Ethoxylated cleylamine	26635-93-8
Ethylene Glycol	107-21-1
Glycol Ethers	111-76-2
guar gum	9000-30-0
Hydrogen Chloride	7647-01-0
Hydrotreated light distillates, non-aromatic, BTEX free	64742-47-8
Isopropyl alcohol	67-63-0
liquid, 2,2-dibromo-3-nitrilopropionamide	10222-01-2
Microparticle	proprietary
Petroleum Distillates (BTEX Below Detect)	64742-47-8
Polyacrylamide	57-55-6
Propargyl Alcohol	107-19-7
Propylene Glycol	57-55-6
Quartz	14808-60-7
Sillica, crystalline quartz	7631-86-9
Sodium Chloride	7647-14-5
Sodium Hydroxide	1310-73-2
Sugar	57-50-1
Surfactant	68439-51-0
Suspending agent (solid)	14808-60-7
Tar bases, quinoline derivs, benzyl chloride-quaternized	72480-70-7



CONTAINMENT PAD N & SEDIMENT EMENT PLAN

JNTY, WEST VIRGINIA CREEK WATERSHED

JRNE QUAD MAPS



WVDOH COUNTY ROAD MAP

THE JUG WILDLIFE MANAGEMENT

WEST VIRGINIA STATE PLANE COORDINATE
NORTH ZONE, NADBS
ELEVATON BASED ON NAVDBB
ESTABLISHED BY SURVEY GRADE GPS & OI
POST-PROCESSING

SHEET INDEX:

1 - COVER SHEET

3 - OVERALL PLAN SHEET INDEX

ACCESS ROAD & WATER CONTAINMENT PAD AS-BUILT PLAN

ACCESS ROAD & WELL PAD AS-BUILT PLAN

- ACCESS ROAD AS-BUILT PLAN

- ACCESS ROAD AS-BUILT PROFILES

11 - WELL PAD & WATER CONTAINMENT PAD AS-BUILT SECTIONS

DALE LIMITS OF DIST	URBANCE A	REA (AC)	- 5
Tota	Site		
	Permitted	Additional	Total
Access Road "A" (3,705')	17.71	0.00	17.71
Access Road "B" (1,488')	5.34	0.22	5.56
Access Road "C" (206')	0.51	0,00	0.51
Upgraded Ex. Access Road (2,150')	0.93	0.00	0.93
Staging Area "A"	0.75	0.00	0.75
Well Pad	5.68	0.00	5.68
Staging Area "B"	1.17	0.00	1.17
Water Containment Pad	1.41	0.00	1.41
Excess/Topsoil Material Stockpiles	4.60	0.00	4.60
Total Affected Area	38.10	0.22	38.32
Total Wooded Acres Disturbed	29.03	0.22	29.25
Impacts to John H. II & I	Frances J. Gr	off TM 8-23	
Upgraded Ex. Access Road (644')	0.69	0.00	0.69
Staging Area "A"	0.75	0.00	0.75
Total Affected Area	1.44	0.00	1.44
Total Wooded Acres Disturbed	0.00	0.00	0.00
Impacts to John H. It & F	rances J. Gra	ff TM 4-15	
Access Road "A" (49')	1.73	0.00	1.73
Upgraded Ex. Access Road (1,506')	0.24	0.00	0.24
Total Affected Area	1.97	0.00	1.97
Total Wooded Acres Disturbed	0.10	0.00	0.10
Impacts to Roger L. & Bar			
Access Road "A" (537')	2.35	0.00	2.35
Total Affected Area	2.35	0.00	2.35
Total Wooded Acres Disturbed	2.35	0.00	2.35
Impacts to Dale Un			2.00
Access Road "A" (3,119")	13.63	0.00	13.63
Access Road "B" (1,488')	5.34	0.22	5,56
Access Road "C" (206')	0.51	0.00	0.51
Well Pad	5.68	0.00	5.68
Staging Area "B"	1.17	0.00	1.17
Water Containment Pad	1.41	0.00	1.41
Excess/Topsoil Material Stockpiles	4.60	0.00	4.60
Total Affected Area	32.34	0.22	32.56
Total Wooded Acres Disturbed	26.58	0.22	26.80

	Proposed Well Name	WV North NAD 27	WV North NAD 83	UTM (METERS) Zone 17	NAD 83 Lat & Long
	Rymer	N 342337.16	N 342371.99	N 4364724.63	LAT 39-25-55 1276
	Unit 4HD	E 1615047.61	E 1583606.48	E 511814.51	LONG -80-51-45.7999
1	Johnson	N 342341.49	N 342376.32	N 4364725.99	LAT 39-25-55, 1718
· 1	Unit 1H	E 1615058.62	E 1583615.50	E 511817.23	LONG -80-51-45.6859
	Johnson	N 342345.83	N 342380 66	N 4364727 36	LAT 39-25-55 2160
	1 Unit 2H	E 1615065.63	E 1583624.51	E 511819.96	LONG -80-51-45.5719
X	Johnson	N 342350 16	N 342384.99	N 4364728 73	LAT 39-25-55 2602
Receive	Unit 3H	E 1615074.64	E 1583633.52	E 511822.68	LONG -80-51-45,4579
HOUGHY	Sage	N 342354 50	N 342389.33	N 4384730.09	LAT 39-25-55 3044
	Unit 1H	E 1815083.65	E 1583642.53	E 511825 40	LONG -80-51-45.3439
4	Jug	N 342358.53	N 342393.66	N 4364731.46	LAT 39-25-55.3486
- 04	e Half 4M	E 1615092.67	E 1583851.54	E 511628 13	LONG -80-51-45.2298
2 9 201	Jug Unit 2H	N 342363 16	N 342398.00	N 4364732.83	LAT 39-25-55.3927
MAY 29 201	API# 47-095-02171	E 1615101.68	E 1583660,55	E 511830.85	LONG -80-51-45 1158
# MAY 23	Rymer	N 342357 50	N 342402.33	N 4354734,19	LAT 39-25-55 4369
	Unit 1H	E 1615110.69	E 1583669,57	E 511833 57	LONG -80-51-45.0018
		N 342371 83	N 342405.66	N 4364735.56	LAT 39-25-55 4811
Office of Oil and	- Unitation	E 1615119.70	E 1583678.58	E 511835.30	LONG -80-51-44.8878
Office of camen	Rymer	N 342376.17	N 342411.00	N 4364736.92	LAT 39-25-55 5253
of Environment	Unit 3H	E 1615128.71	E 1583687 59	E 511839 02	LONG -80-51-44.7738
Office of Oil and	Sage	N 342380 50	N 342415 33	N 4364738 29	LAT 39-25-55,5695
	Unit 2H	E 1615137.72	E 1583696.60	E 511841.74	LONG -50-51-44.5598
	Well Pad Elevation	1,017.0			

DALE PERENNIAL	STREAM IMP	ACT (LINEAR FEE	T)
Stream and Impact Cause	Culvert (LF)	Inlets/Outlets Structures (LF)	Total Impact (LF)
Wheeler Run (Access Road "B")	50	44	94

SCALE: 1" = 5000"

AWAY

WMA

AS-BUILT CERTIFICATION:
THE DRAWINGS, CONSTRUCTION NOTES, AND
REFERENCE DIAGRAMS ATTACHED HERETO HAVE
BEEN PREPARED IN ACCORDANCE WITH THE
WEST VIRGINIA CODE OF STATE RULES, DIVISION
OF ENVIRONMENTAL PROTECTION, OFFICE OF OIL
AND GAS CRS 35-8.

REPRODUCTION NOTE

THESE PLANS WERE CREATED TO BE PLOTTED ON 22°X34° (ANSI D) PAPER. HALF SCALE DRAWINGS ARE ON 11°X17° (ANSI B) PAPER.

THESE PLANS WERE CREATED FOR COLOR PLOTTING AND ANY REPRODUCTIONS IN GRAY SCALE OR COLOR MAY RESULT IN A LOSS OF INFORMATION AND SHOULD NOT BE USED FOR CONSTRUCTION PURPOSES

NAV TU

Telephone: (888) 662-4185 | www.NavitusEng.con

DATE	REVISION
05/04/2015	UPDATED PUNCH LIST ITEMS
05/19/2015	REVISED WELL CONFIGURATION



THIS DOCUMENT WAS PREPARED FOR: ANTERO RESOURCES CORPORATION

WELL PAD & WATER CONTAINMENT PAD E DISTRICT
WEST VIRGINIA CENTERVILLE



DATE: 03/24/2015 SCALE: AS SHOWN

SHEET

DALE WELL PAD & WATER CONTAINMENT PAD

WVDEP 00G ACCEPTED AS-BUILT CENTROLD OF WELL PAD LATTUDE. 38 432046 LONGITUDE. —60.882340 (NAD 63) N 4364731.05 E 511647.36 (UTM 20NE 17 METERS) EX. ACCESS ROAD ENTRANCE
LATTUDE: 38-487650 LONGITUDE: -80.546765 (NAD 83)
N 4364183.87 E 513016.63 (UTM ZONE 17 METERS)

LOCATION COORDINATES:
ATTURE - DA 453459 LENGTUDE - GOEGGT4 (NAD 89)
A 4544697 80 E BIL4GI 40 (UTM ZONE 17 METERS)

7/14/2015 188% CENTER OF WATER CONTAINMENT TANK
ANTIUDE: SULCEDOD LONGITUDE: -BO 864187 (MAD 83)
N 4364624.33 E 511668.30 (UTN ZONE 17 METERE)

GENERAL DESCRIPTION: THE ACCESS BOARD WILL PAL AND WATER CONTINUED TO PARTY HERY CONSTRUCTED TO THE TIME OFFICE WATCH TO PROPRIED AMERICAL SIMIL GAS WELL.

FLOODPLAIN NOTES: THE STEE TEAM FLOOD MAP (\$4005C0175C)

ENVIRONMENTAL NOTES:

THAND DIRECTIONS AND PROBABIL SHAPES OCCUSES SOLS IN LANGER SOLS BY KLENNINGS

THAND DIRECTIONS AND PROBABIL SHAPES OF STATEMENT SHAPES TO SECURITY

OF DIVINIOUS OF THE U.S. AND CODES OF DIRECTION AND OF THE WEST CONTINUED OF DIVINIOUS OF THE WEST CONTINUED AND THE ADMINISTRY TAYARDS AND THE WEST CONTINUED AND THE WEST CONTINUED AND THE WEST CONTINUED BY THE RESULTS OF THE PROBABIL OF THE WEST CONTINUED BY THE USAGE OF THE PROPERTY OF THE WEST CONTINUED BY THE USAGE OF THE PROPERTY OF THE WEST CONTINUED BY THE USAGE OF THE PROPERTY OF THE WEST CONTINUED BY THE USAGE OF THE PROPERTY OF THE WEST CONTINUED BY THE USAGE OF THE PROPERTY OF THE WEST CONTINUED BY THE USAGE OF THE PROPERTY OF THE WEST CONTINUED BY THE USAGE OF THE PROPERTY OF THE WEST CONTINUED BY THE USAGE OF THE PROPERTY OF THE WEST CONTINUED BY THE USAGE OF THE PROPERTY OF THE WEST CONTINUED BY THE USAGE OF THE PROPERTY OF THE WEST CONTINUED BY THE USAGE OF THE PROPERTY OF THE WEST CONTINUED BY THE USAGE OF THE PROPERTY OF THE WEST CONTINUED BY THE USAGE OF THE PROPERTY OF THE WEST CONTINUED BY THE USAGE OF THE PROPERTY OF THE WEST CONTINUED BY THE USAGE OF THE PROPERTY OF THE WEST CONTINUED BY THE USAGE OF THE WEST CONTINUED BY THE USAGE OF THE PROPERTY OF THE WEST CONTINUED BY THE USAGE OF THE WEST CONTINUED BY THE USAGE OF THE WEST CONTINUED BY THE USAGE OF THE WEST CONTINUED.

GEOTECHNICAL NOTES:

REGISTRALIA INSTITUTE OF THIS STEP AND FERDRAND OF PROMOTIVE OF A RECK. RC. REGISTRALIA INSTITUTE OF PROMISE OF

PROJECT CONTACTS

MARK JOHNSON - SURVEYING COORDINATOR (304) 842-4182 CELL (304) 719-6449

DAVE CAVA - LAND AGENT (304) 641-5614

ОРЕБАТОВ:
АТТЕЮ РЕЗОИТСЯ СИРОВАТИОМ
ВЕПДЕРОВ, ТУ 28330
РЕОУК. (304) 842-4100
FAX. (304) 842-4100

OFFICE: (304) 542-4068 CELL: (304) 476-

ENGINEER/SURVEYOR:
CHRUS S. KUMP, FS - PROJECT
MAAAGEN/FSGINES
OFFICE (866) 662-4185 CELL (540) 686-6747

8-

JOHN KAPCAK - OPERATIONS SUPERINTENDENT CELL. (R17) 368-1553 AARION KUNZLER - CONSTRUCTION SUPERVISOR CELL: (405) 227-8344

ENVIRONMENTAL

ANTHONY SMITH - FIELD ENGINEER OFFICE: (304) 642-4208 CELL: (304) 673-6198

AMERICANA - PROJECT MANAGER (610) 594-1444 CELL (610) 656-4419

GEOTECHNICAL:
PENSTLYANA 2011. & ROCK, INC.
CHRISTOPHER W. SAMIOS-PROLECT ENGINERS
(412). 372-4000 CELL. (412). 509-0662

(14.2) 372-4600 CELE (14.2) 606-0662

FRENTRICTIONS MOTES: SERESTORIS THEM 10 DETT OF THE TELL PLA AD LOS.
ADVINGES HERE AS THE WEST BONG THAT HAS THE STATE OF THE VIEW THE PLANTED BY THE ADVINGES.
ADVINGES HERE ARE TWO WELLANDS THEM 100 FEET OF THE LOD THAT HAVE DEMANDED.

WEST VIRGINIA COUNTY MAP

- STE

4-1-6-1

THERE ARE NO NATURALLY PRODUCING TROUT STREAMS WITHIN 200 FEET OF THE WELL PAD AND LOD.

THERE ARE NO GROUNDWATER INTAKE OR PUBLIC WATER SUPPLY PACILITIES WITHIN 1000 PEET OF THE WELL PAD AND LOD.

6

THEIRE AND EXCEPTING WATER WELLS OR DEVELOPED SPHENCE WITHEN 250 FEET OF THE WELLES BEING DRILLED.

THERE ARE NO OCCUPIED DWELLING STRUCTURES WITHIN 625 PRET OF THE CENTER OF THE WELL PAD.

THERE ARE NO AGRICULTURAL BUILDINGS LARGER THAN 2,500 SQUARE FEET WITHIN 525 FEET THE CENTER OF THE WELL PAD.

NOTES:

1. ALE BIY'S MUST STAKEN IN FLACE AND PUNCTIONAL UNTIL ALL ARKEN WITHOUT THE LIST OF PROPERTIES. MANTHEMACK MUST INCLUDE INSPIRATOR OF ALL BROWN OF ALL BROWN AND SETSHENT CONTROLS AFTER LACE KINGEY RYDEY IN EXCESS OF OAK ON OW A REPEATED BLUES.

THE CONSTRUCTOR WITH SQUALD BE STREAMEN AS SON AS PROBREL AT THE CONSTRUCTOR STREAMEN AS THE CONSTRUCTOR AS STREAMEN AND AS STREAMEN WERE BE STREAMEN AS SON AS STREAMEN AS ST

ALL PERMANENT SEDIMENT CONTROL MEASURES CAN BE REMOVED AFTER THE SITE IS PERMANENTLY STABILIZED AND APPROVAL IS RECEIVED FROM THE WYDEP.

ANY AREAS DISTURBED BY HEMOVAL OF CONTROLS SHALL BE REPAIRED, STABILIZED, AND PERMANENTLY SEEDED.

THE AS-BRILL INTORMATION SHOWN HEREDN RETAINED THEID DATA COLLECTED RELATIVE TO THE CALLENG OF THE EDUCINEED REAL AS OF WARRED. IS, 300 THE TOTAL CRUENCE OF SHOWN HERED THE CALLENG OF THE TOTAL CRUENCE OF THE TOTAL CRUE

MISS Utility of West Virginia
1-800-24-64848
West Virginia State Law
Section XIV. Chapter 24-C)
Requires that you call two
business days before you dig in
the state of West Virginia.
IT'S THE LAW!

THE POTETRIC CONTAINENT BEAM ABOUND THE WELL PAD SHALL BE REFAINED AS NECESSARY TO ANAMERE OF ALL PRUISS PRICE TO DRILLING OFFIATIONS THE EXCRIME BORESES TO THE WELL PAD SHALL HAVE THE MOUNTHALE BEING REPAIRED AS VICESBARY TO ENGURE 100% CONTAINENT OF ALL FLIDS PHORE TO DRILLING OPERATIONS.



1

ENERGY ENGINEERING

II - WELL PAD & WATER CONTAINMENT PAD AS-BUILT SECTIONS

DALE LIMITS OF DIS

MACCESSING.
THEOLOGY AND A STREET ON WALDES

NUMBER OF WANDES

NUMBER OF WANDES


AMERICAN STATE DO NOT SELECT ON THE SELECT ON T

4 - ACCESS HOAD & WATER CONTAINMENT PAD AS-BUILT PLAN

S - OVERALL PLAN SHEET INDEX

SHEET INDEX C LEGEND 5 - ACCESS ROAD & WELL PAD AS-BUILT PLAN 6-8 - ACCESS ROAD AS-BUILT PLAN 9-10 - ACCESS ROAD AS-BUILT PROFILES

VAN

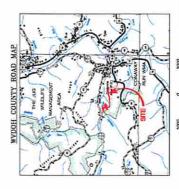





MELL PAD & WATER CONTAINMENT PAD CENTERVILLE DISTRICT TYLER COUNTY, WEST VIRGINIA

DYFE COVER SHEET

Antero

THES DOCUMENT WAS PREPARED FOR ANTERO RESIDENCES CORPORATION

Total Affected Area 32.34
Total Wooded Acres Distribed 28.58

Ashrbed John H. H. & Fran

8

Digraded Ex Access Road (1506)

THESE FLANS WERE CHEATED TO DR PLOTTED ON SENSA" (ANSI D) PAPER. HALF SCALE DRAWINGS ARE ON 11"TOT" (ANSI S) PAPER. API# 9502270 API# 9502273 API# 9502275 API# 9502265 API# 9502269 API# 9502171

THESE PLANS WERE CREATED FOR COLOR PLOTTED AND ANY REPRODUCTION IN GIVE A COLOR WAY RESULT IN A LOSS OF PRODUCTION AND SHOULD NOT HE USED FOR CONSTRUCTION PURPOURS.

REPRODUCTION NOTE

DATE: 03/24/2015 SCALE AS SHOWN SHEET 1 OF 11

′2015

