

NOTES ON SURVEY

1. NO WATER WELLS WERE FOUND WITHIN 250' OF PROPOSED GAS WELL. NO AGRICULTURAL BUILDINGS ≥ 2500 SQ. FT. OR DWELLINGS WERE FOUND WITHIN 625' OF THE CENTER OF PROPOSED WELL PAD.
2. AS DRILLED INFORMATION PROVIDED BY EQT.


**EQT PRODUCTION COMPANY
W.H. ASH ET AL LEASE
152 ACRES±
WELL NO. WV 512892
(WEU4 H3)**

(S.P.C. NORTH ZONE) (UTM(M) ZONE 17 NORTH)

NAD'27 S.P.C.(FT)	N. 318,336.31	E. 1,626,585.65
NAD'27 GEO.	LAT-(N) 39.366485	LONG-(W) 80.820801
NAD'83 UTM (M)	N. 4,357,471.45	E. 515,451.82
LANDING POINT		
NAD'27 S.P.C.(FT)	N. 318,046.31	E. 1,626,140.19
NAD'27 GEO.	LAT-(N) 39.366671	LONG-(W) 80.822361
NAD'83 UTM (M)	N. 4,357,380.83	E. 515,317.39
BOTTOM HOLE		
NAD'27 S.P.C.(FT)	N. 321,480.77	E. 1,624,538.66
NAD'27 GEO.	LAT-(N) 39.375034	LONG-(W) 80.828205
NAD'83 UTM (M)	N. 4,358,419.00	E. 514,812.03

LEGEND

LEASE LINE	---
SURFACE LINE	----
PROPOSED PATH	----
AS DRILLED PATH	----
OFFSET LINE	----
THE LINE	----
CREEK	----
ROAD	----
FENCE LINE	----
COUNTY ROUTE	----
PROPOSED WELL	⊙
EXISTING WELL	⊙
PERMITTED WELL	⊙
ABANDONED WELL	⊙
PLUGGED WELL	⊙
STORAGE WELL	⊙
CENTERVILLE DISTRICT TAX MAP-PARCEL	C-00-00
McELROY DISTRICT TAX MAP-PARCEL	M-00-00

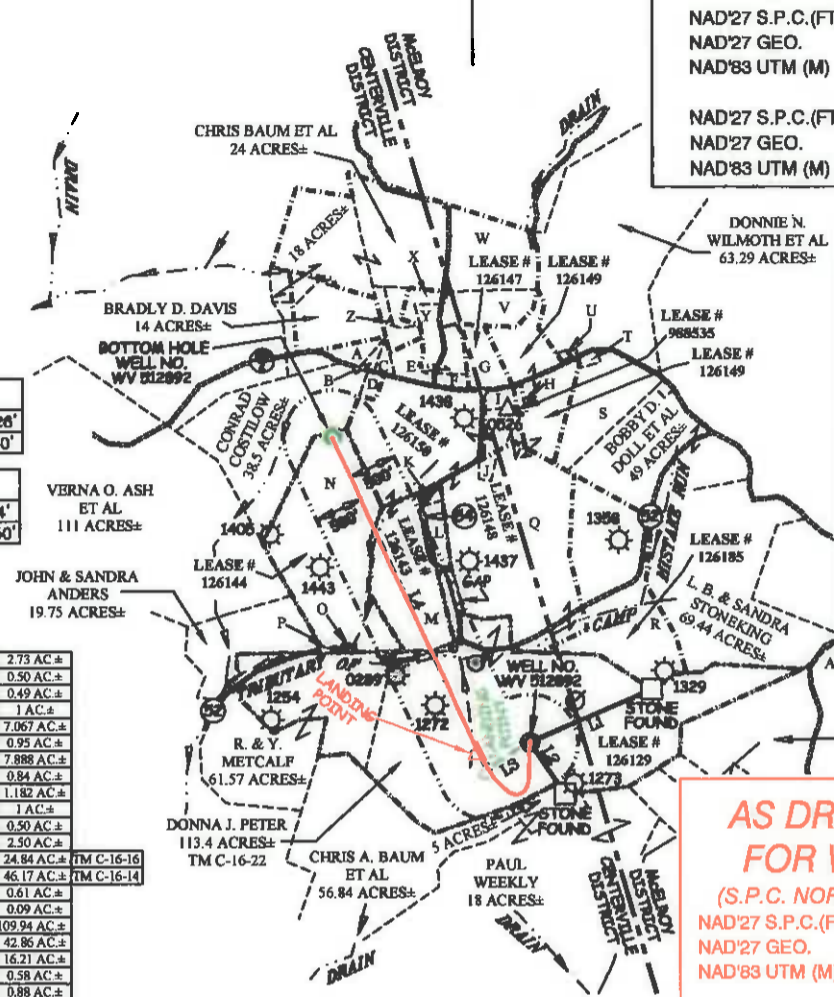

CORNER TIES

BEARING & DISTANCE	
L1 N 66°30' E	1378.26'
L2 S 34°20' E	846.40'

LATERAL PATH

BEARING & DISTANCE	
L3 S 56°56' W	531.54'
L4 N 26°00' W	3789.50'

A	BRADLEY D. DAVIS	2.73 AC±
B	WILLIAM DOLL ET AL	0.50 AC±
C	WILLIAM DOLL ET AL	0.49 AC±
D	WILLIAM DOLL	1 AC±
E	FRIEDERIKE DOHRMANN	7.067 AC±
F	WILBUR COMMUNITY CLUB	0.95 AC±
G	JOHN STARKEY	7.888 AC±
H	CHRIS A. BAUM ET AL	0.84 AC±
I	TERRY G. WEEKLEY	1.182 AC±
J	RUTH O. & OLIN L. DOLL	1 AC±
K	GARY PROSSER	0.50 AC±
L	GARY & BARBARA PROSSER	2.50 AC±
M	HOWARD SHRIVER ET AL	24.84 AC± TM C-16-16
N	CONRAD COSTLOW	46.17 AC± TM C-16-14
O	RICHARD & YVONNE METCALF	0.61 AC±
P	JOHN & SANDRA ANDERS	0.09 AC±
Q	ELIZABETH ABRUZZINO	109.94 AC±
R	L.B. & SANDRA STONEKING	42.86 AC±
S	PERRY J. HAUGHT	16.21 AC±
T	BILLY J. DOLL	0.58 AC±
U	KATHLEEN WINKELMANN	0.88 AC±
V	CHRIS A. BAUM	13 AC±
W	CHRIS A. BAUM	14 AC±
X	WILBUR CEMETERY	2 AC±
Y	WILBUR CHAPEL	0.84 AC±
Z	WILBUR CEMETERY COMMUNITY INC	0.197 AC±

ROYALTY OWNERS


FANCY M. MERCER ET AL	26 AC±	LEASE NO. 128143
ROBA B. CRESS ET AL	47 AC±	LEASE NO. 128144

AS DRILLED COORDINATES FOR WELL NO. WV 512892
(S.P.C. NORTH ZONE) (UTM(M) ZONE 17 NORTH)

NAD'27 S.P.C.(FT)	N. 318,336.31	E. 1,626,585.65
NAD'27 GEO.	LAT-(N) 39.366485	LONG-(W) 80.820801
NAD'83 UTM (M)	N. 4,357,471.45	E. 515,451.82
LANDING POINT		
NAD'27 S.P.C.(FT)	N. 318,260.08	E. 1,626,040.52
NAD'27 GEO.	LAT-(N) 39.366254	LONG-(W) 80.822725
NAD'83 UTM (M)	N. 4,357,445.45	E. 515,285.94
BOTTOM HOLE		
NAD'27 S.P.C.(FT)	N. 321,480.49	E. 1,624,539.29
NAD'27 GEO.	LAT-(N) 39.375034	LONG-(W) 80.828203
NAD'83 UTM (M)	N. 4,358,418.91	E. 514,812.22

Professional Energy Consultants
A DIVISION OF ENTH LAND SURV. INC.
SLS
SURVEYS
ENGINEERS
ENVIRONMENTAL
PROJECT MGMT.
(904) 462-0884
WWW.SLSURVEYS.COM

I THE UNDERSIGNED, HEREBY CERTIFY THAT THIS PLAT IS CORRECT TO THE BEST OF MY KNOWLEDGE AND BELIEF AND SHOWS ALL THE INFORMATION REQUIRED BY LAW AND THE REGULATIONS ISSUED AND PRESCRIBED BY THE DIVISION OF ENVIRONMENTAL PROTECTION.

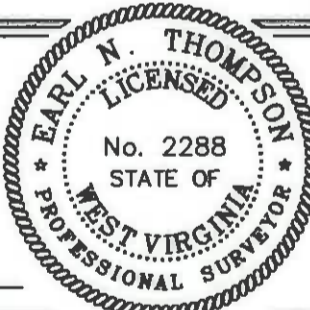

P.S. 2288 *Earl N. Thompson*

(+) DENOTES LOCATION OF WELL ON UNITED STATES TOPOGRAPHIC MAPS.
DATE SEPTEMBER 03, 20 14
REVISED 06/04/15, 06/18/15, 04/06/16 & 06/13/16
OPERATORS WELL NO. WV 512892
API WELL NO. 47 - 095 - 02280H
STATE COUNTY PERMIT

MINIMUM DEGREE OF ACCURACY 1 / 2500 FILE NO. 7701AD512892R
HORIZONTAL & VERTICAL CONTROL DETERMINED BY DGPS (SURVEY GRADE TIE TO CORS NETWORK) SCALE 1" = 2000'

STATE OF WEST VIRGINIA
DIVISION OF ENVIRONMENTAL PROTECTION
OFFICE OF OIL AND GAS

WELL TYPE: OIL GAS LIQUID INJECTION WASTE DISPOSAL IF "GAS" PRODUCTION STORAGE DEEP SHALLOW

LOCATION: ELEVATION 1,008'(GROUND) 1,079'(PROPOSED) WATERSHED TRIBUTARY OF CAMP MISTAKE RUN
DISTRICT CENTERVILLE COUNTY TYLER QUADRANGLE WEST UNION 7.5'
SURFACE OWNER DONNA J. PETER ACREAGE 113.40±
ROYALTY OWNER WACO OIL & GAS CO. INC. ET AL ACREAGE 152±
PROPOSED WORK: DRILL CONVERT DRILL DEEPER REDRILL FRACTURE OR STIMULATE PLUG OFF OLD FORMATION PERFORATE NEW FORMATION PLUG AND ABANDON CLEAN OUT AND REPLUG OTHER
PHYSICAL CHANGE IN WELL (SPECIFY) _____ TARGET FORMATION MARCELLUS
ESTIMATED DEPTH TVD 6.698'

WELL OPERATOR EQT PRODUCTION COMPANY DESIGNATED AGENT REX C. RAY
ADDRESS 115 PROFESSIONAL PLACE P.O. BOX 280 BRIDGEPORT, WV 26330 ADDRESS 115 PROFESSIONAL PLACE P.O. BOX 280 BRIDGEPORT, WV 26330