

LATITUDE 39°30'00"

5,518'

9,190' TO BOTTOM HOLE

LATITUDE 39°30'00"





Antero Resources Corporation
Well No. Goodfellow Unit 1H
API # 47-095-02324

LONGITUDE 80°50'00"

4,009' TO BOTTOM HOLE

12,268'

LONGITUDE 80°50'00"

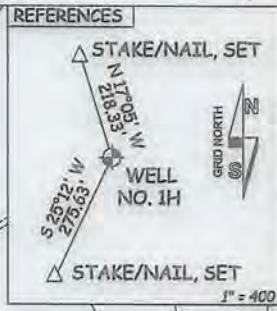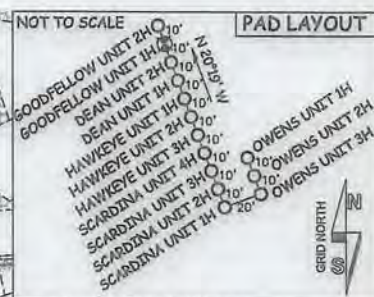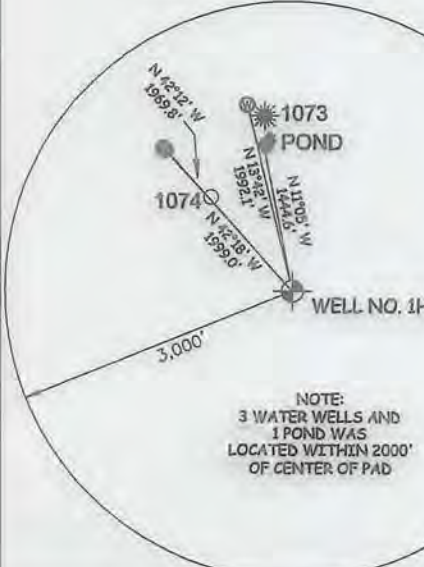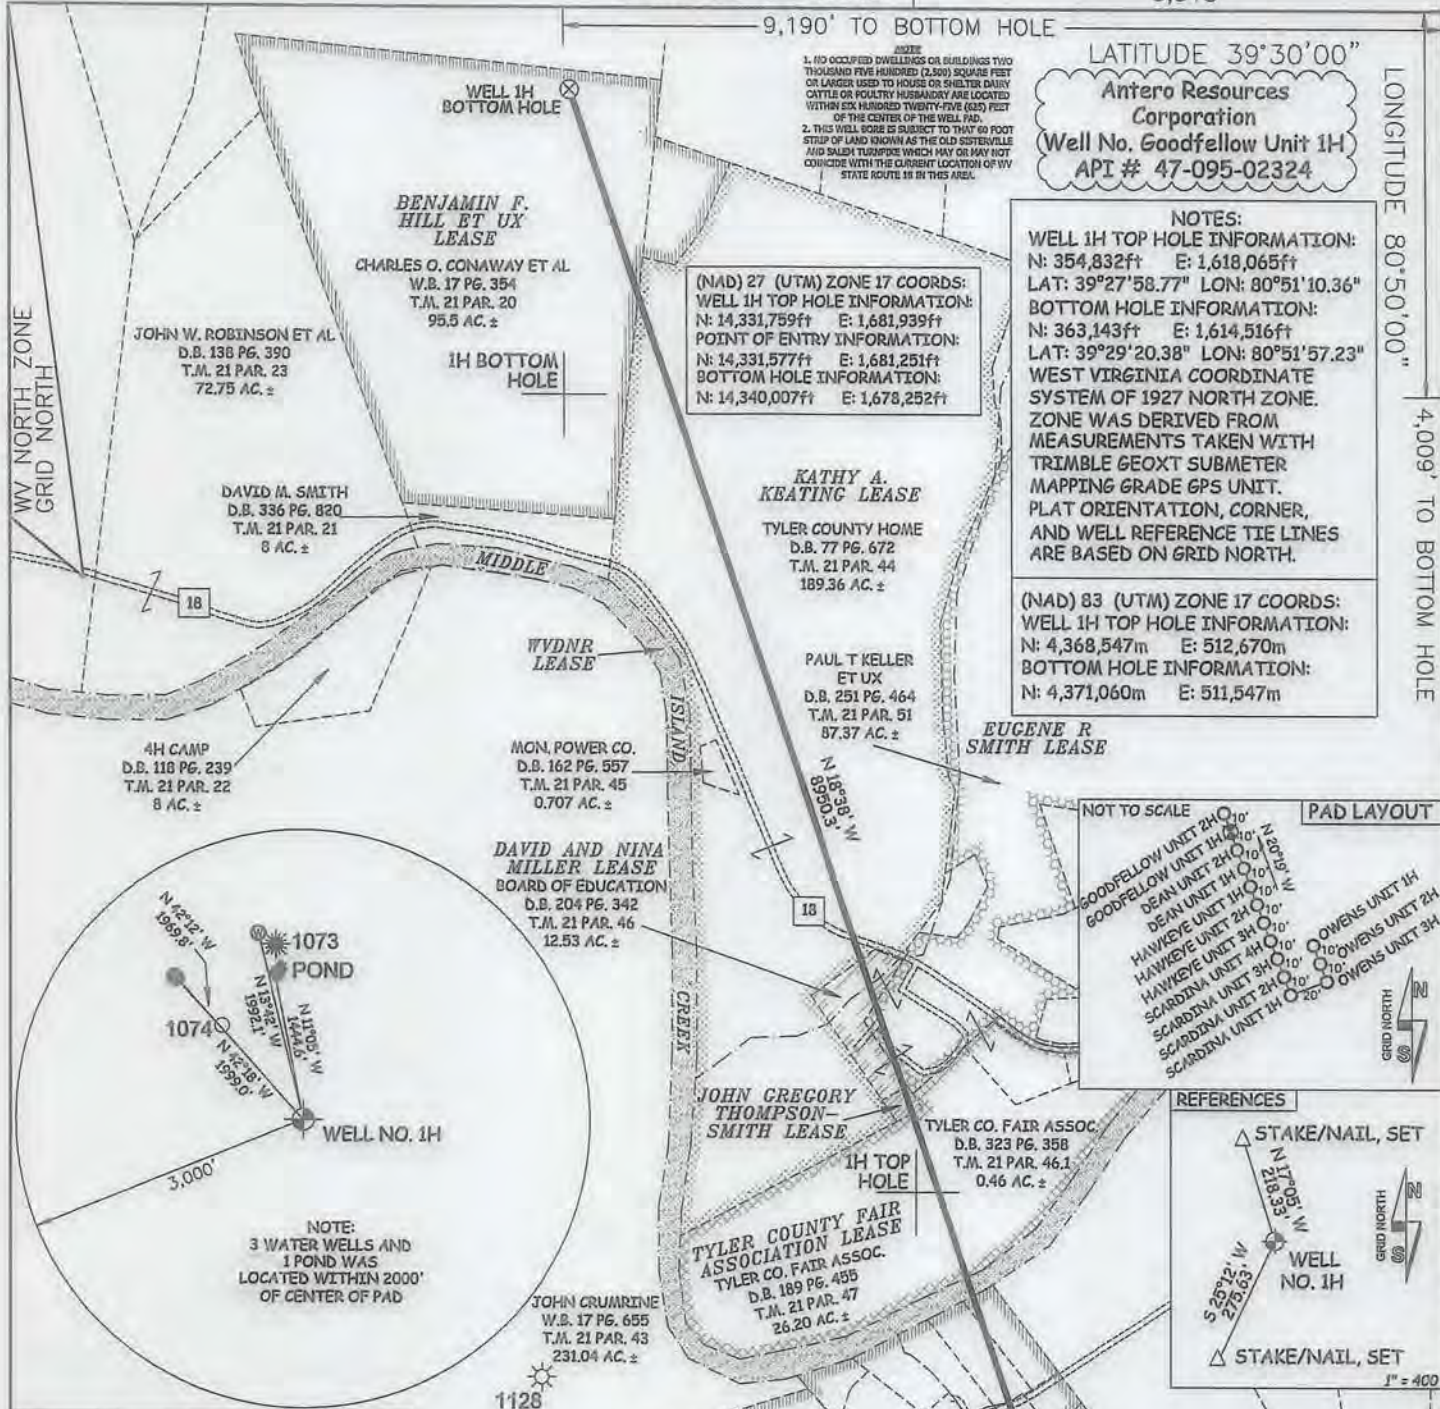

47 - 095 - 02324
STATE COUNTY PERMIT

I, THE UNDERSIGNED, HEREBY CERTIFY THAT THIS PLAT IS CORRECT TO THE BEST OF MY KNOWLEDGE AND BELIEF AND SHOWS ALL THE INFORMATION REQUIRED BY LAW AND THE RULES ISSUED AND PERSCRIBED BY THE DEPARTMENT OF ENVIRONMENTAL PROTECTION.




STATE OF WEST VIRGINIA, DIVISION OF ENVIRONMENTAL PROTECTION, OFFICE OF OIL AND GAS
WILLOW LAND SURVEYING PLLC
220 MASONIC AVE. PENNSBORO WEST VIRGINIA 26415

JOB # 13-041WA
DRAWING # GOODFELLOW1HR
SCALE 1" = 1000'
MINIMUM DEGREE OF ACCURACY SUBMETER
PROVEN SOURCE OF ELEV. SUBMETER MAPPING GRADE GPS
STATE OF WEST VIRGINIA DEPARTMENT OF ENERGY DIVISION OF OIL AND GAS

LEGEND
 --- Surface Owner Boundary Lines +/-
 --- Interior Surface Tracts +/-
 X Existing Fence
 Found monument, as noted
 THOMAS SUMMERS P.S. 2109
 DATE 05/03/16
 OPERATOR'S WELL# GOODFELLOW UNIT #1H

WELL TYPE: OIL ___ GAS X LIQUID INJECTION ___ WASTE DISPOSAL ___
 (IF "GAS") PRODUCTION X STORAGE ___ DEEP ___ SHALLOW X
 LOCATION: ELEVATION 811' ORIGINAL - 812' AS-BUILT WATERSHED OUTLET MIDDLE ISLAND CREEK
 QUADRANGLE SHIRLEY 7.5' DISTRICT ELLSWORTH COUNTY TYLER
 SURFACE OWNER EDWIN C. WEIGLE ACREAGE 60.19 ACRES +/-

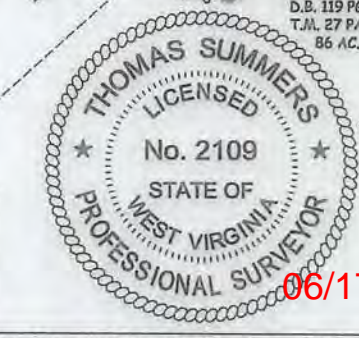

OIL & GAS ROYALTY OWNER KATHY ANN SEAGO; RICHARD L. SEAGO ET UX; ROBERT L. DEAN; JAMES E GREGG ET UX; LEASE ACREAGE 129.2 AC +/-; 74.2 AC +/-; 35 AC +/-; 141 AC +/-
 WCDARE TYLER COUNTY FAIR ASSOCIATION; JOHN GREGORY THOMPSON-SMITH; DAVID AND NINA MILLER; EUGENE R SMITH; KATHY A KEATING; BENJAMIN F HILL ET UX 34 AC +/-; 26.665 AC +/-; 0.468 AC +/-; 4.973 AC +/-; 87.37 AC +/-; 190.07 AC +/-; 95.5 AC +/-
 PROPOSED WORK: DRILL ___ CONVERT ___ DRILL DEEPER X REDRILL ___ FRACTURE OR STIMULATE X
 PLUG OFF OLD FORMATION ___ PERFORATE NEW FORMATION X OTHER PHYSICAL CHANGE IN WELL
 (SPECIFY) MOD - BHL PLUG & ABANDON CLEAN OUT & REPLUG
 TARGET FORMATION MARCELLUS ESTIMATED DEPTH 6,500' TVD 15,900' MD
 WELL OPERATOR ANTERO RESOURCES CORP. DESIGNATED AGENT DIANNA STAMPER - CT CORPORATION SYSTEM
 ADDRESS 1615 WYNKOOP STREET ADDRESS 5400 D BIG TYLER ROAD
 DENVER, CO 80202 CHARLESTON, WV 25313

06/17/2016