

References



**Notes:**  
 1. All wells within 500' of the horizontal leg are shown on this plat based upon information taken from DEP mapping, well plats & aerial photos.  
 2. No water wells were found within 250' of the location. No dwelling or agricultural buildings were found within 625' of the center of the well pad.

NUMBER	DIRECTION	DISTANCE
L1	S37°44' E	1,954'
L2	S68°26' E	2,038'
L3	N04°01' E	1,529'



05/03/2019

- A-Hair et al T.M. 2-2 53.31 Ac. T1-13
- B-Sherwood T.M. 2-3 14.5 Ac. T3107
- C-Parr T.M. 23-6.1 8.01 Ac. T3107A
- D-Parr T.M. 23-6 18.62 Ac. T3106
- E-Hair et al T.M. 23-5 3 Ac. T3106
- F-Hair et al T.M. 23-4 9 Ac. T3106
- G-Weekley Est. T.M. 23-27 7 Ac. T3109A2
- H-Adams T.M. 23-1 20 Ac. T3901A1
- I-Bedora T.M. 23-3 9 Ac. RPT11
- J-Parr T.M. 17-54 17.43 Ac.
- K-Parr T.M. 17-55 34 Ac. T3246
- L-Williams T.M. 17-57 12.51 Ac. T3246A
- M-Weekley et al T.M. 16-34 15 Ac. T3248A
- N-Williams T.M. 17-57.3 31.22 Ac. T3246A
- O-Williams T.M. 17-57.2 29.6 Ac. T3246A
- P-Williams T.M. 17-57.1 20.47 Ac. T3246A
- Q-Hammitt et al T.M. 17-34 18.49 Ac.
- R-Nichols et al T.M. 2-19 12.5 Ac.
- S-Weekley T.M. 16-33 16.5 Ac. T3248B
- T-Wilkinson T.M. 17-33 1 Ac.
- U-Peck T.M. 17-28 5 Ac.
- V-Parr T.M. 23-7 46.5 Ac. T4002B

**Surface Hole Location**  
 Geo. NAD 83-39.483102 N, 80.785990 W  
 UTM NAD 83(Meters)-4370411.03 N, 518404.84 E  
 UTM NAD 83(Feet)-14338590.18 N, 1700799.87

**Landing Point Location**  
 Geo. NAD 83-39.487293 N, 80.785688 W  
 UTM NAD 83(Meters)-4370876.16 N, 518429.68 E  
 UTM NAD 83(Feet)-14340116.22 N, 1700881.36 E

**Bottom Hole Location**  
 Geo. NAD 83-39.502838 N, 80.792134 W  
 UTM NAD 83(Meters)-4372600.13 N, 517871.40 E  
 UTM NAD 83(Feet)-14345772.25 N, 1699049.74 E

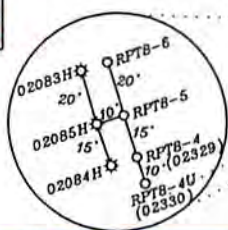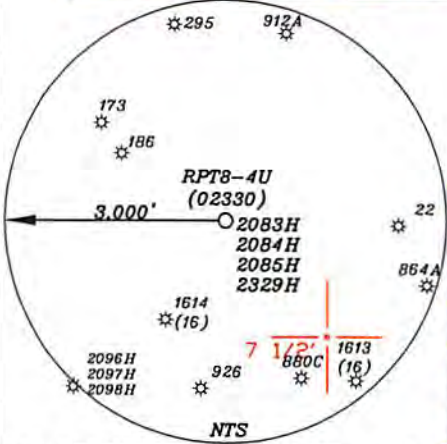

**Surface Hole Location**  
 Geo. NAD 83-39.483102 N, 80.785987 W  
 UTM NAD 83(Meters)-4370411.03 N, 518405.13 E  
 UTM NAD 83(Feet)-14338590.18 N, 1700800.82 E

**Landing Point Location**  
 Geo. NAD 83-39.487836 N, 80.785657 W  
 UTM NAD 83(Meters)-4370936.46 N, 518432.26 E  
 UTM NAD 83(Feet)-14340314.03 N, 1700889.82 E

**Bottom Hole Location**  
 Geo. NAD 83-39.502793 N, 80.792061 W  
 UTM NAD 83(Meters)-4372595.10 N, 517877.69 E  
 UTM NAD 83(Feet)-14345755.76 N, 1699070.40 E

(+) DENOTES LOCATION OF WELL ON UNITED STATES TOPOGRAPHIC MAPS

FILE NO. \_\_\_\_\_  
 DRAWING NO. 1  
 SCALE 1" = 2000'  
 MINIMUM DEGREE OF ACCURACY 1 in 200  
 PROVEN SOURCE OF ELEVATION GPS  
submeter unit

I THE UNDERSIGNED, HEREBY CERTIFY THAT THIS PLAT IS CORRECT TO THE BEST OF MY KNOWLEDGE AND BELIEF AND SHOWS ALL THE INFORMATION REQUIRED BY LAW AND THE RULES ISSUED AND PRESCRIBED BY THE DEPARTMENT OF ENVIRONMENTAL PROTECTION.

(SIGNED) \_\_\_\_\_  
 R.P.E. \_\_\_\_\_ P.S. 708

STATE OF WEST VIRGINIA  
 Division of Environmental Protection  
 OFFICE OF OIL AND GAS

DATE July 18, 2017  
 OPERATOR'S WELL NO. RPT8 4U  
 API WELL NO. As Drilled

WELL TYPE: OIL GAS LIQUID INJECTION X WASTE DISPOSAL \_\_\_\_\_  
 (IF 'GAS') PRODUCTION X STORAGE \_\_\_\_\_ DEEP X SHALLOW \_\_\_\_\_

LOCATION: ELEVATION 1,245.9' WATER SHED Big Run  
 DISTRICT McElroy COUNTY Tyler  
 QUADRANGLE Shirley 7 1/2'

SURFACE OWNER Jack Hair et al ACREAGE 85 ac  
 OIL & GAS ROYALTY OWNER Jack Hair - 85 Ac.

LEASE NO. RPT 8  
 PROPOSED WORK: DRILL \_\_\_\_\_ CONVERT \_\_\_\_\_ DRILL DEEPER \_\_\_\_\_ REDRILL \_\_\_\_\_ FRACTURE OR STIMULATE \_\_\_\_\_ PLUG OFF OLD FORMATION \_\_\_\_\_ PERFORATE NEW FORMATION \_\_\_\_\_ OTHER PHYSICAL CHANGE IN WELL (SPECIFY) As Drilled  
 PLUG AND ABANDON \_\_\_\_\_ CLEAN OUT AND REPLUG \_\_\_\_\_  
 TARGET FORMATION Utica ESTIMATED DEPTH TVD=12,019' TMD=18,720'  
 WELL OPERATOR Jay Bee Oil & Gas, Inc. DESIGNATED AGENT Randy Broda  
 ADDRESS 1720 Rt. 22 East Union, NJ 07083 ADDRESS Rt. 1 Box 5 Cairo, WV 26337

LONGITUDE 80-45-00 W Bottom Hole 14,110' Top Hole 6,155'