

WW-7
8-30-06



West Virginia Department of Environmental Protection
Office of Oil and Gas
WELL LOCATION FORM: GPS

API: 47-095-_____ WELL NO.: #30- 91762_____

FARM NAME: F. R. Wells_____

RESPONSIBLE PARTY NAME: Operator Unknown/ WVDEP PAID CONTRACTOR

COUNTY: Tyler_____ DISTRICT: Lincoln_____

QUADRANGLE: New Matamoras_____

SURFACE OWNER: Dan Carney_____

ROYALTY OWNER: N/A_____

UTM GPS NORTHING: 4377401.0_____

UTM GPS EASTING: 498232.0_____ Elevation 610'_____

The Responsible Party named above has chosen to submit GPS coordinates in lieu of preparing a new well location plat for a plugging permit or assigned API number on the above well. The Office of Oil and Gas will not accept GPS coordinates that do not meet the following requirements:

1. Datum: NAD 1983, Zone: 17 North, Coordinate Units: meters, Altitude: height above mean sea level (MSL) – meters.
2. Accuracy to Datum – 3.05 meters
3. Data Collection Method:
Survey grade GPS _____: Post Processed Differential _____
Real-Time Differential _____
Mapping Grade GPS _____: Post Processed Differential _____
Real-Time Differential _____
4. **Letter size copy of the topography map showing the well location.**



I the undersigned, hereby certify this data is correct to the best of my knowledge and belief and shows all the information required by law and the regulations issued and prescribed by the Office of Oil and Gas.

Dave Gilbert_____
Signature

Inspector Specialist_____
Title

Date 12/20/2016_____

02/17/2017

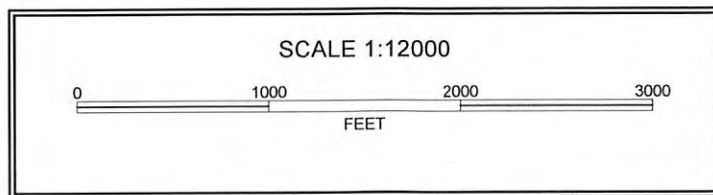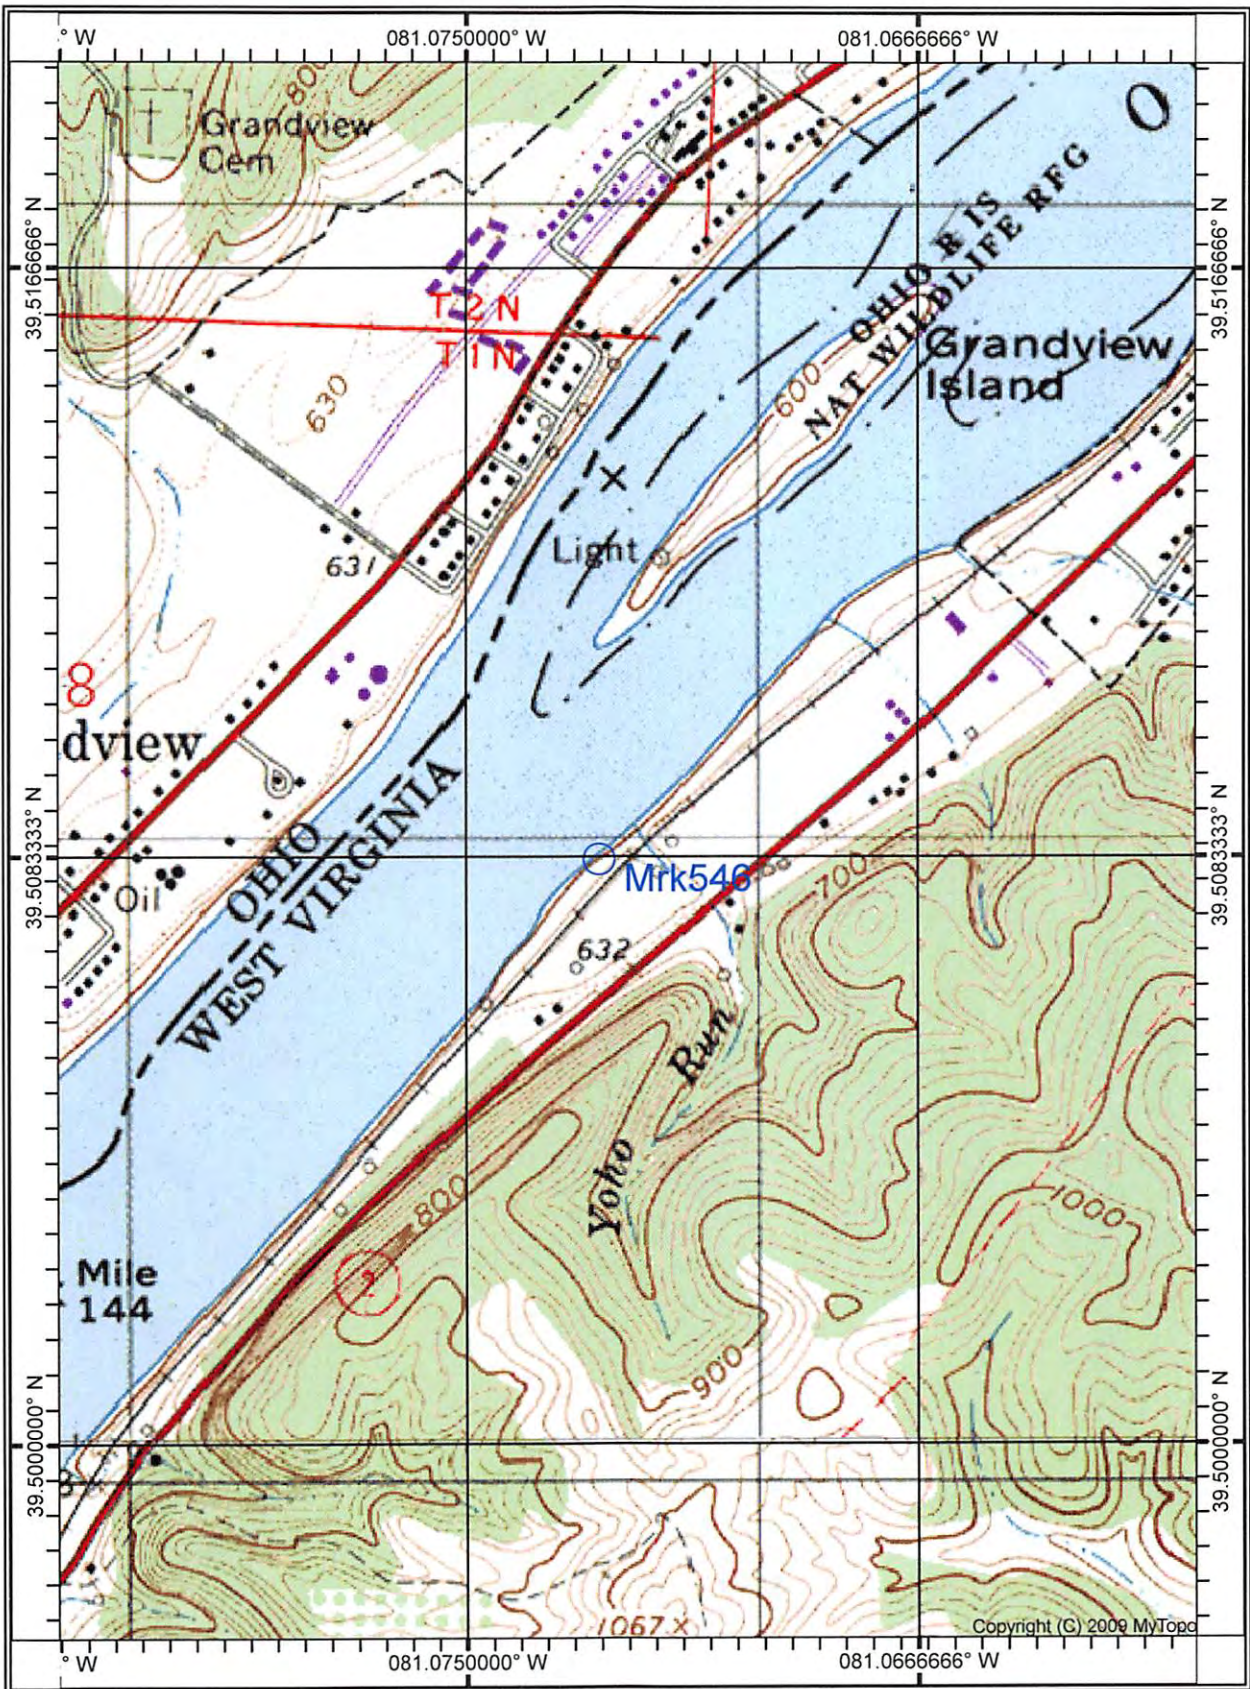

02/17/2017