


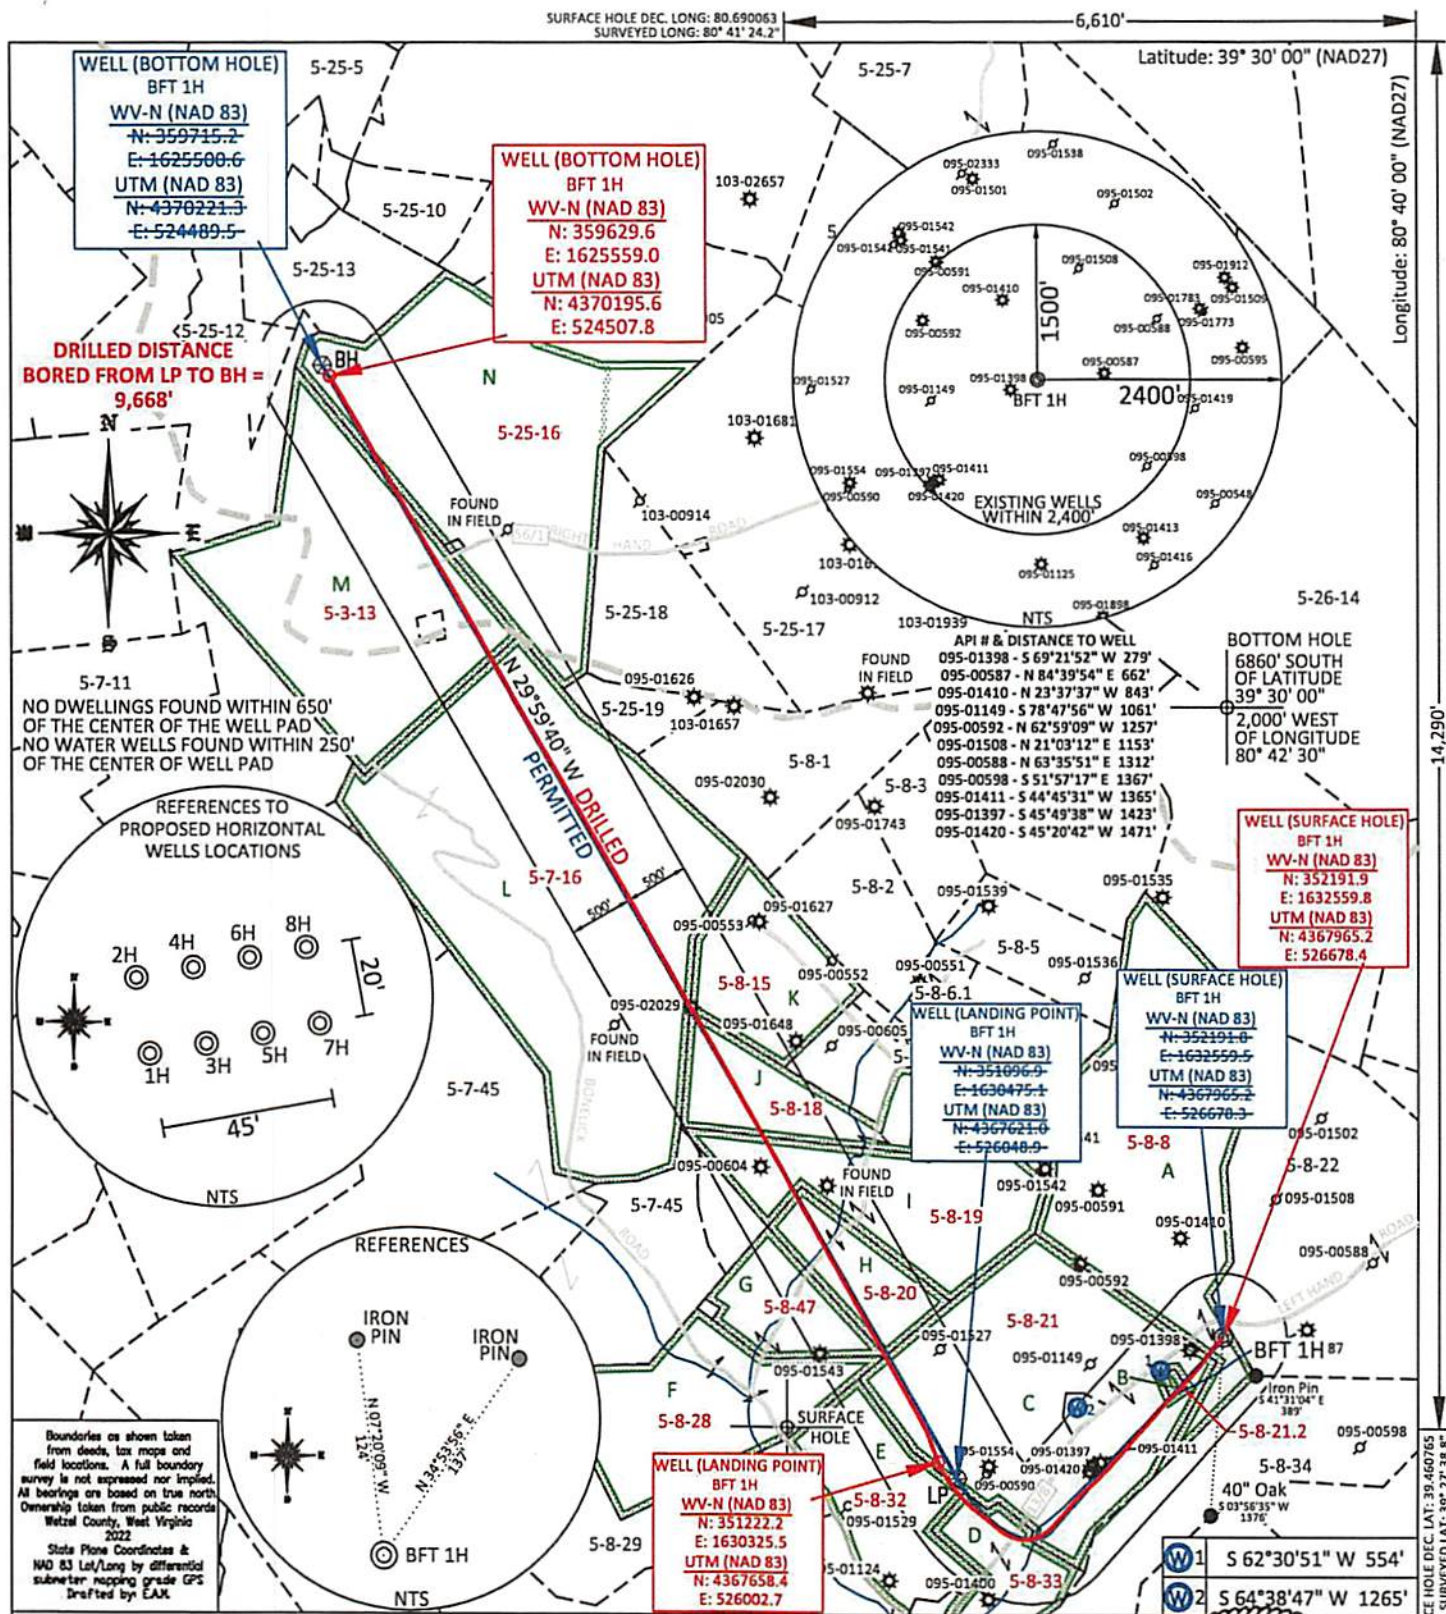

(+) DENOTES LOCATION OF WELL ON
UNITED STATES TOPOGRAPHIC MAPS
WVDEP
OFFICE OF OIL & GAS
601 57TH STREET
CHARLESTON, WV 25304

Well Type: ☐ Oil ☐ Waste Diposal ☐ Production ☐ Deep
☒ Gas ☐ Liquid Injection ☐ Storage ☒ Shallow

WATERSHED: OUTLET MIDDLE ISLAND CREEK

COUNTY/DISTRICT: TYLER / McELROY

SURFACE OWNER: WEST VIRGINIA DEPT. OF NATURAL RESOURCES

OIL & GAS ROYALTY OWNER: Tribune Resources, LLC, Et Al

LEASE NUMBERS:

DATE: NOVEMBER 6, 2025

OPERATOR'S WELL #: BFT 1H AS-DRILLED

API WELL #: 47 95 02831

STATE COUNTY PERMIT

AS-BUILT
ELEVATION: 880'

QUADRANGLE: CENTER POINT

ACREAGE: 110.00 +/-

ACREAGE: 801.8 +/-

12/12/2025

DRILL ☒ CONVERT ☐ DRILL DEEPER ☐ REDRILL ☐ FRACTURE OR STIMULATE ☒
PLUG OFF FORMATION ☐ PERFORATE NEW FORMATION ☐ PLUG & ABANDON ☐
CLEAN OUT & REPLUG ☐ OTHER CHANGE ☐ (SPECIFY):

TARGET FORMATION: MARCELLUS

WELL OPERATOR: TRIBUNE RESOURCES, LLC

ADDRESS: 3861 AMBASSADOR CAFFERY PARKWAY SUITE 600

CITY: LAFAYETTE STATE: LA ZIP CODE: 70503

DRILLED DEPTH: TVD: 6,911.26' TMD: 17,917.00'

DESIGNATED AGENT: HARMAN BROWN

ADDRESS: 18396 MOUNTAINEER HIGHWAY


CITY: WILEYVILLE STATE: WV ZIP CODE: 26581

	PROPERTY OWNER INDEX
5-8-8	WV DEPT. OF NATURAL RESOURCES COMMERCE
5-8-21	JERRY L. WALTERS
5-8-21.2	ETI ASSET TRANSFERS INC
5-8-32	CARL E. WALTERS
5-8-33	JERRY L. WALTERS
5-8-28	HUGH & DARLENE A. CARLSTON
5-8-20	FRANK A. & MARTHA J. PERRY
5-8-47	DALLISON LUMBER INC.
5-8-18	FRANK A. & MARTHA J. PERRY
5-8-19	FRANK A. MARTHA J. PERRY
5-8-15	FRANK A. & MARTHA J. PERRY
5-7-16	STEVEN GLEN WADSWORTH
5-3-13	WILLIAM E. BLANKENSHIP JR.
5-25-16	COASTAL FOREST RESOURCES CO.

	LEASE INDEX		
A	MARC00713-000	H	MARC00733-001
B	MARC00713-000	I	MARC00718-001
C	MARC00713-000	J	MARC03491-000
D	MARC00925-001	K	MARC00726-000
E	MARC00923-001	L	MARC01108-001
F	MARC00724-001	M	MARC01135-001
G	MARC03039-005	N	MARC03689-001


12/12/2025

FILE #: <u>TRB2</u> DRAWING #: <u>3077</u> SCALE: <u>N/A</u>	DATE: <u>NOVEMBER 6, 2025</u> OPERATOR'S WELL #: <u>BFT 1H AS-DRILLED</u> API WELL #: <u>47</u> <u>095</u> <u>02831</u> STATECOUNTYPERMIT
--	---

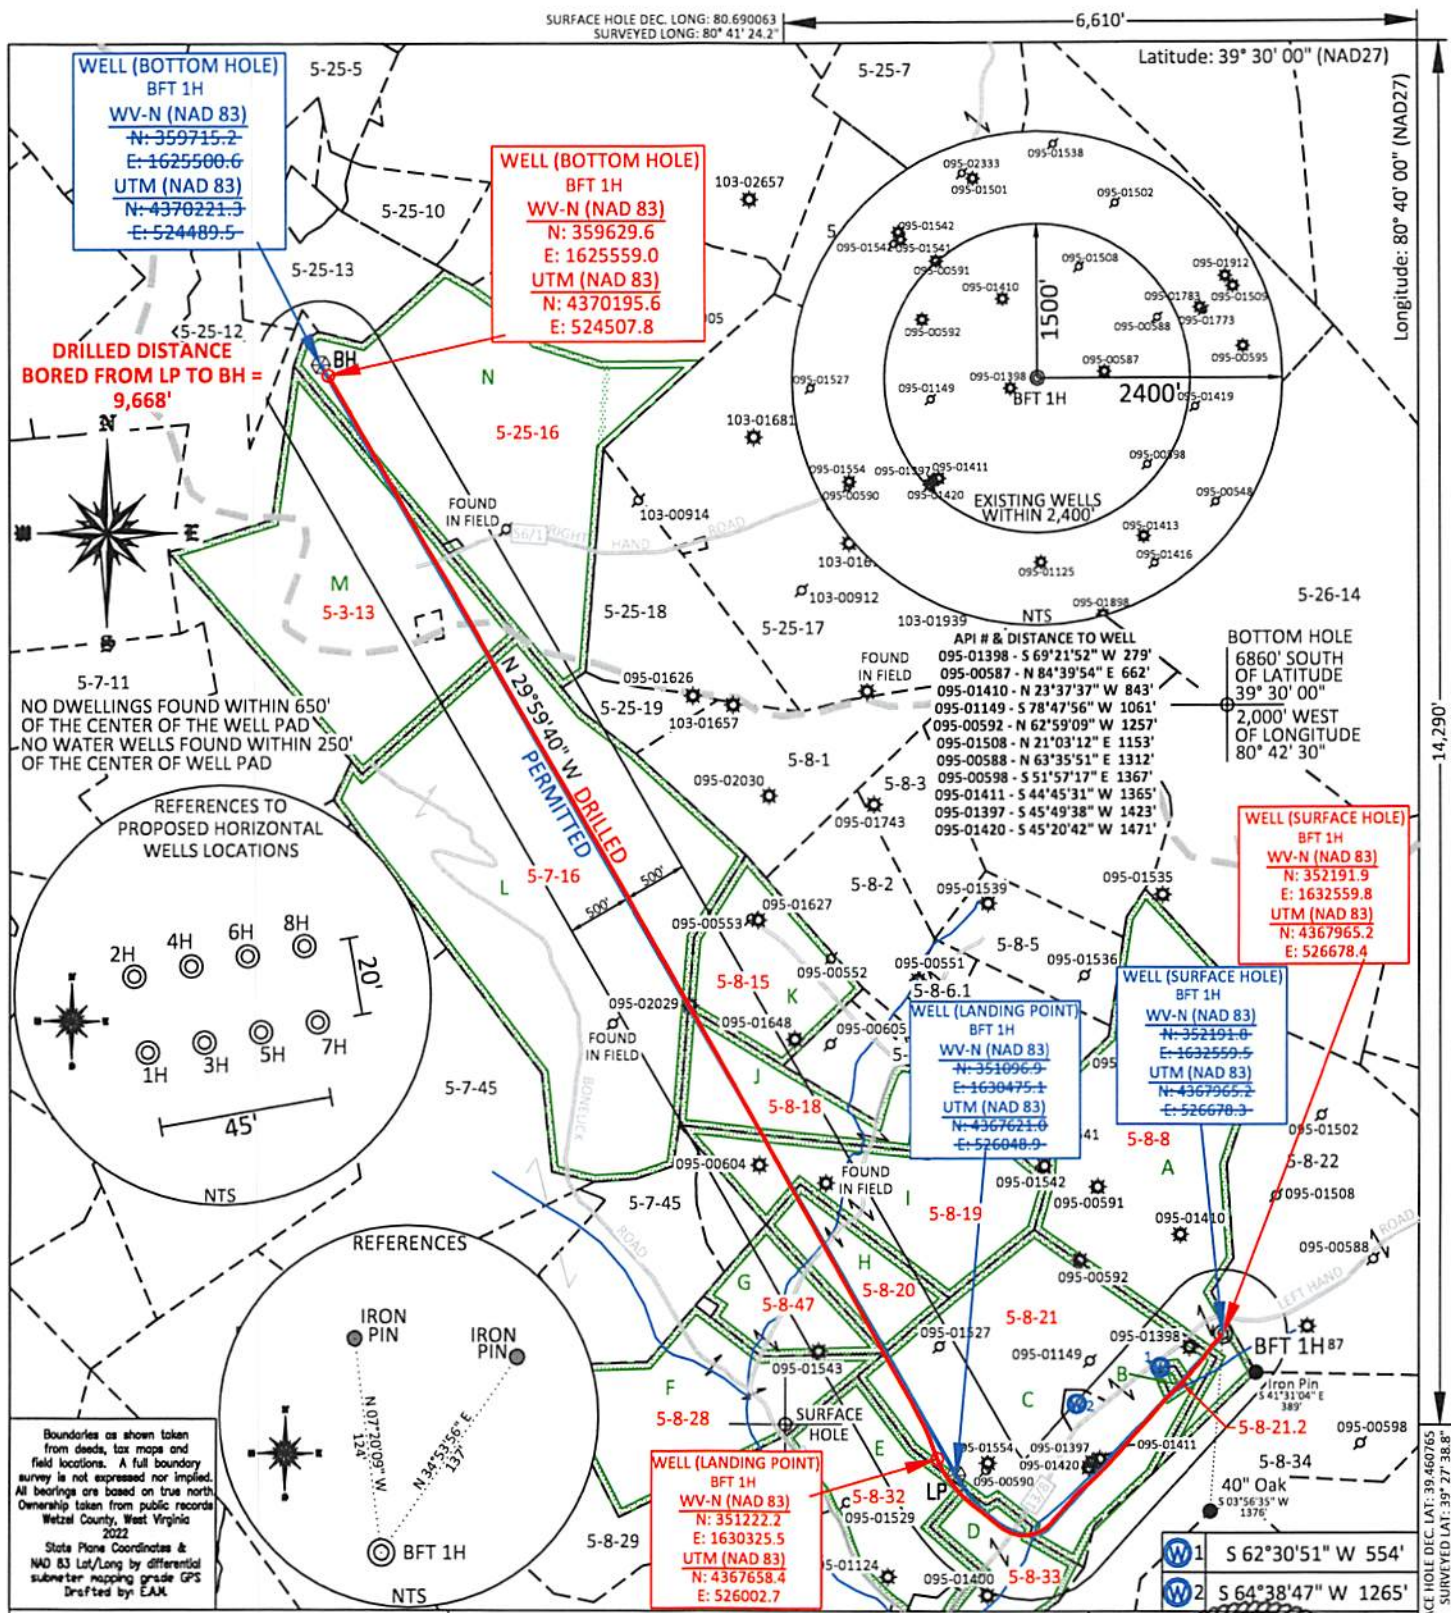

FILE #: TRB2
DRAWING #: 3077
SCALE: PLAT: 1" = 1500'
TICK: 1" = 2000'
MINIMUM DEGREE OF ACCURACY: 1/200
PROVEN SOURCE: SUBMETER MAPPING
OF ELEVATION: GRADE GPS

I, THE UNDERSIGNED, HEREBY CERTIFY THAT THIS PLAT IS CORRECT TO THE BEST OF MY KNOWLEDGE AND BELIEF AND SHOWS ALL THE INFORMATION REQUIRED BY LAW AND THE REGULATIONS ISSUED AND PRESCRIBED BY THE DEPARTMENT OF ENVIRONMENTAL PROTECTION.
Signed: *[Signature]*
L.L.S. #2124 : Ernest J. Benchek III

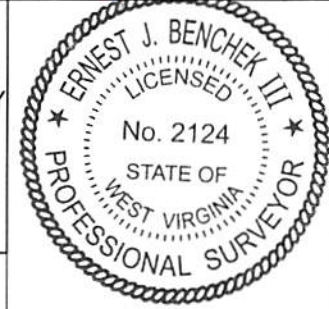

(+) DENOTES LOCATION OF WELL ON UNITED STATES TOPOGRAPHIC MAPS WYDEP
OFFICE OF OIL & GAS
601 57TH STREET
CHARLESTON, WV 25304
Well Type: ☐ Oil ☐ Waste Diposal ☐ Production ☐ Deep
☒ Gas ☐ Liquid Injection ☐ Storage ☒ Shallow
WATERSHED: OUTLET MIDDLE ISLAND CREEK
COUNTY/DISTRICT: TYLER / McELROY
SURFACE OWNER: WEST VIRGINIA DEPT. OF NATURAL RESOURCES
OIL & GAS ROYALTY OWNER: Tribune Resources, LLC, Et Al
LEASE NUMBERS:

DATE: NOVEMBER 6, 2025
OPERATOR'S WELL #: BFT 1H AS-DRILLED
API WELL #: 47 95 02831
STATE COUNTY PERMIT
AS-BUILT ELEVATION: 880'
QUADRANGLE: CENTER POINT
ACREAGE: 110.00 +/-
ACREAGE: 801.8 +/-
12/12/2025

DRILL ☒ CONVERT ☐ DRILL DEEPER ☐ REDRILL ☐ FRACTURE OR STIMULATE ☒
PLUG OFF FORMATION ☐ PERFORATE NEW FORMATION ☐ PLUG & ABANDON ☐
CLEAN OUT & REPLUG ☐ OTHER CHANGE ☐ (SPECIFY):
TARGET FORMATION: MARCELLUS
WELL OPERATOR: TRIBUNE RESOURCES, LLC
ADDRESS: 3861 AMBASSADOR CAFFERY PARKWAY SUITE 600
CITY: LAFAYETTE STATE: LA ZIP CODE: 70503
DRILLED DEPTH: TVD: 6,911.26' TMD: 17,917.00'
DESIGNATED AGENT: HARMAN BROWN
ADDRESS: 18396 MOUNTAINEER HIGHWAY
CITY: WILEYVILLE STATE: WV ZIP CODE: 26581

PROPERTY OWNER INDEX	
5-8-8	WV DEPT. OF NATURAL RESOURCES COMMERCE
5-8-21	JERRY L. WALTERS
5-8-21.2	ETI ASSET TRANSFERS INC
5-8-32	CARL E. WALTERS
5-8-33	JERRY L. WALTERS
5-8-28	HUGH & DARLENE A. CARLSTON
5-8-20	FRANK A. & MARTHA J. PERRY
5-8-47	DALLISON LUMBER INC.
5-8-18	FRANK A. & MARTHA J. PERRY
5-8-19	FRANK A. MARTHA J. PERRY
5-8-15	FRANK A. & MARTHA J. PERRY
5-7-16	STEVEN GLEN WADSWORTH
5-3-13	WILLIAM E. BLANKENSHIP JR.
5-25-16	COASTAL FOREST RESOURCES CO.

LEASE INDEX			
A	MARC00713-000	H	MARC00733-001
B	MARC00713-000	I	MARC00718-001
C	MARC00713-000	J	MARC03491-000
D	MARC00925-001	K	MARC00726-000
E	MARC00923-001	L	MARC01108-001
F	MARC00724-001	M	MARC01135-001
G	MARC03039-005	N	MARC03689-001

12/12/2025

FILE #: TRB2


DRAWING #: 3077

SCALE: N/A

DATE: NOVEMBER 6, 2025

OPERATOR'S WELL #: BFT 1H AS-DRILLED

API WELL #: 47 095 02831
STATE COUNTY PERMIT

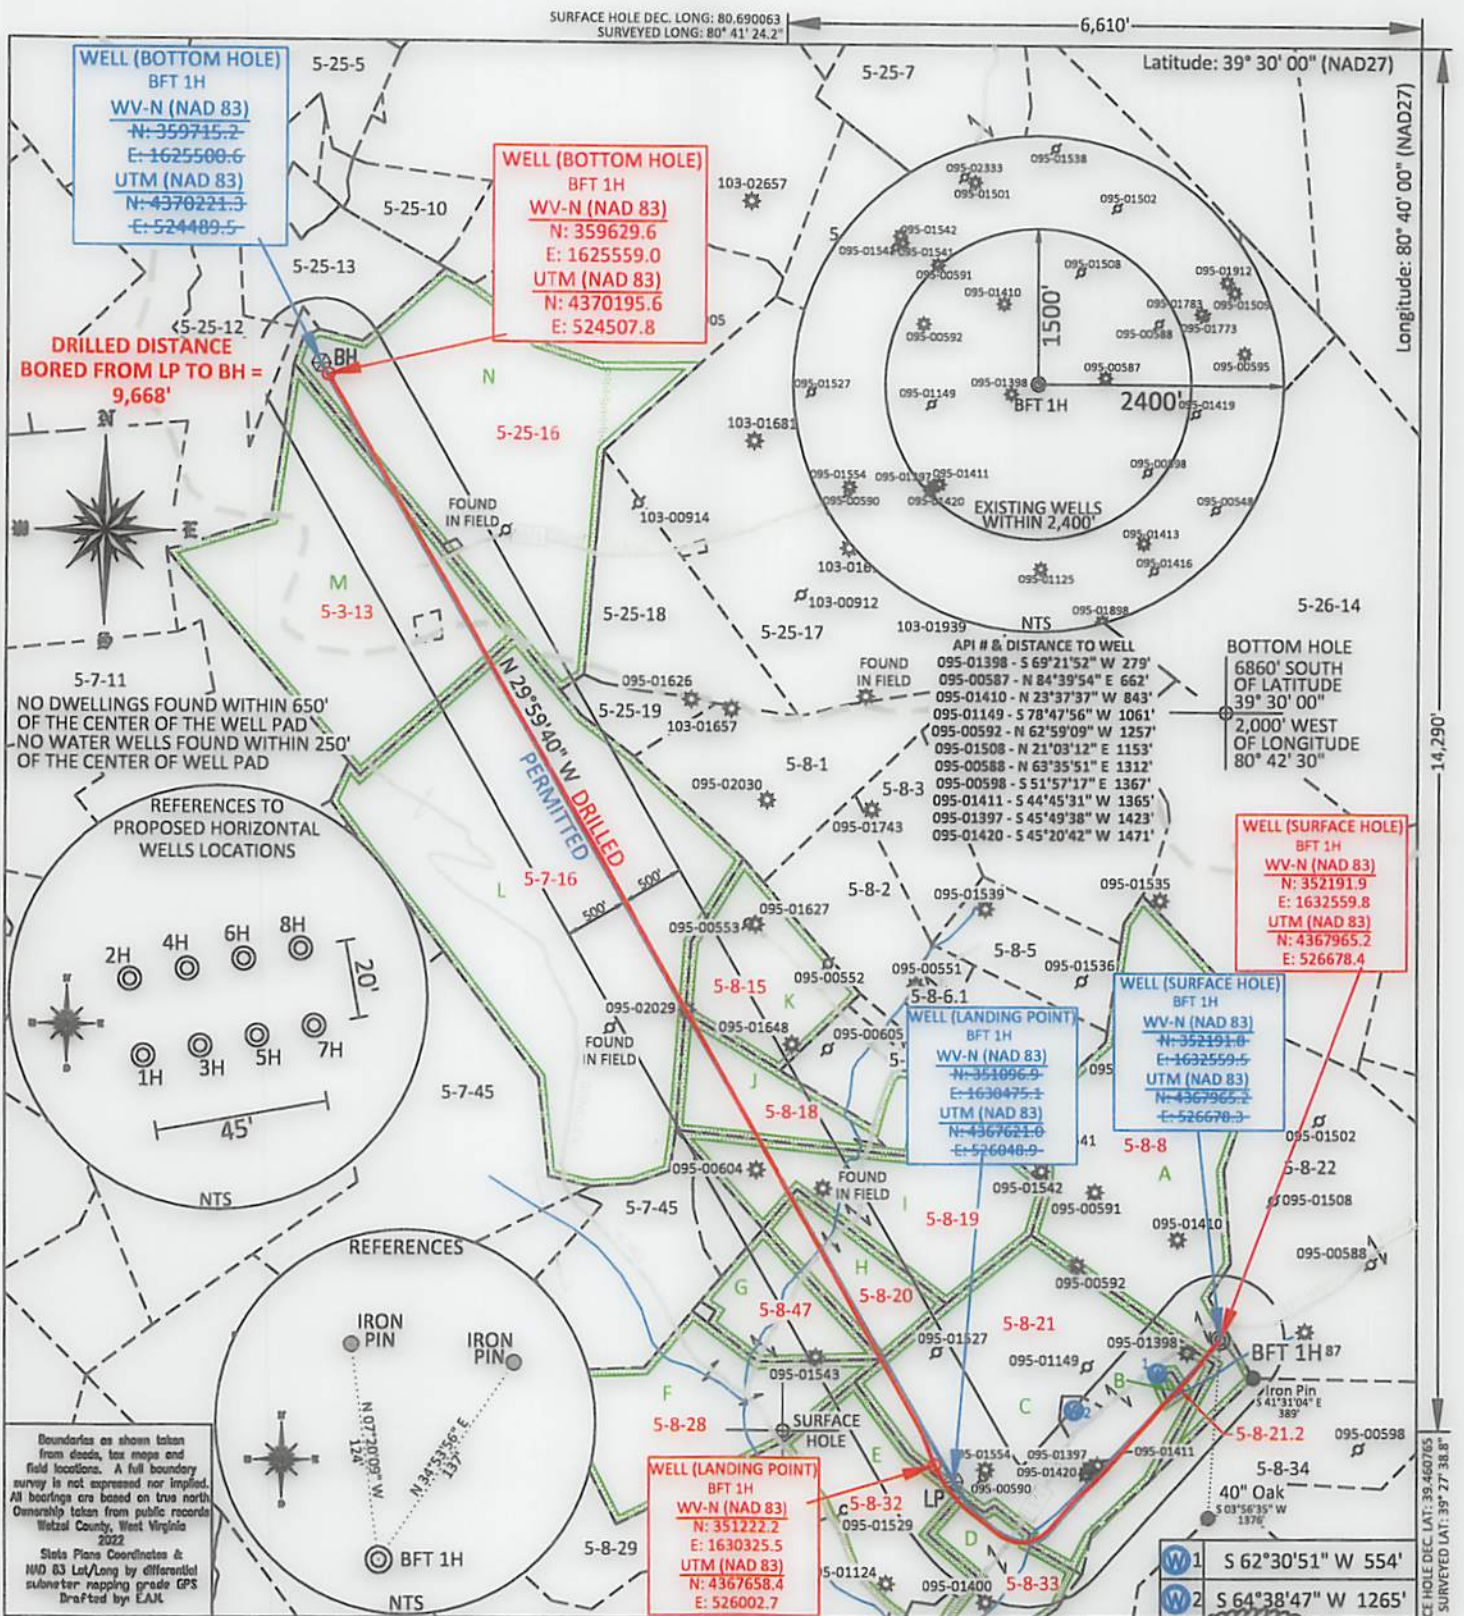

FILE #: TRB2
DRAWING #: 3077
SCALE: PLAT: 1" = 1500'
TICK: 1" = 2000'
MINIMUM DEGREE
OF ACCURACY: 1/200
PROVEN SOURCE SUBMETER MAPPING
OF ELEVATION: GRADE GPS

I, THE UNDERSIGNED, HEREBY CERTIFY THAT THIS
PLAT IS CORRECT TO THE BEST OF MY KNOWLEDGE AND
BELIEF AND SHOWS ALL THE INFORMATION REQUIRED BY
LAW AND THE REGULATIONS ISSUED AND PRESCRIBED BY
THE DEPARTMENT OF ENVIRONMENTAL PROTECTION.

Signed: 
L.L.S. #2124: Ernest J. Benchek III

ERNEST J. BENCHEK III
LICENSED
No. 2124
STATE OF
WEST VIRGINIA
PROFESSIONAL SURVEYOR

DATE: NOVEMBER 6, 2025
OPERATOR'S WELL #: BFT 1H AS-DRILLED
API WELL #: 47 95 02831
STATE COUNTY PERMIT
AS-BUILT
ELEVATION: 880'

WATERSHED: OUTLET MIDDLE ISLAND CREEK
COUNTY/DISTRICT: TYLER / McELROY
SURFACE OWNER: WEST VIRGINIA DEPT. OF NATURAL RESOURCES
OIL & GAS ROYALTY OWNER: Tribune Resources, LLC, Et Al
LEASE NUMBERS:

QUADRANGLE: CENTER POINT
ACREAGE: 110.00 +/-
ACREAGE: 801.8 +/-

12/12/2025

DRILL ☒ CONVERT ☐ DRILL DEEPER ☐ REDRILL ☐ FRACTURE OR STIMULATE ☒
PLUG OFF FORMATION ☐ PERFORATE NEW FORMATION ☐ PLUG & ABANDON ☐
CLEAN OUT & REPLUG ☐ OTHER CHANGE ☐ (SPECIFY):

TARGET FORMATION: MARCELLUS
WELL OPERATOR: TRIBUNE RESOURCES, LLC
ADDRESS: 3861 AMBASSADOR CAFFERY PARKWAY SUITE 600
CITY: LAFAYETTE STATE: LA ZIP CODE: 70503

DRILLED DEPTH: TVD: 6,911.26' TMD: 17,917.00'
DESIGNATED AGENT: HARMAN BROWN
ADDRESS: 18396 MOUNTAINEER HIGHWAY
CITY: WILEYVILLE STATE: WV ZIP CODE: 26581

