


FILE #: TRB1
DRAWING #: 3084
SCALE: PLAT: 1" = 1500'
TICK: 1" = 2000'
MINIMUM DEGREE OF ACCURACY: 1/200
PROVEN SOURCE: SUBMETER MAPPING
OF ELEVATION: GRADE GPS

I, THE UNDERSIGNED, HEREBY CERTIFY THAT THIS PLAT IS CORRECT TO THE BEST OF MY KNOWLEDGE AND BELIEF AND SHOWS ALL THE INFORMATION REQUIRED BY LAW AND THE REGULATIONS ISSUED AND PRESCRIBED BY THE DEPARTMENT OF ENVIRONMENTAL PROTECTION.

Signed: Ernest J. Benchek III
L.L.S. #2124 : Ernest J. Benchek III

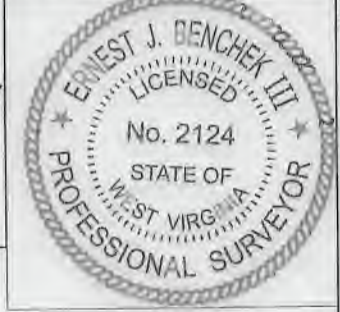

(+) DENOTES LOCATION OF WELL ON UNITED STATES TOPOGRAPHIC MAPS WYDEP

OFFICE OF OIL & GAS
601 57TH STREET
CHARLESTON, WV 25304

Well Type: Oil Waste Diposal Production Deep
 Gas Liquid Injection Storage Shallow

WATERSHED: OUTLET MIDDLE ISLAND CREEK

COUNTY/DISTRICT: TYLER / McELROY

SURFACE OWNER: WEST VIRGINIA DEPT. OF NATURAL RESOURCES

OIL & GAS ROYALTY OWNER: Tribune Resources, LLC, Et Al

LEASE NUMBERS:

DATE: SEPTEMBER 1, 2022

OPERATOR'S WELL #: BFT 4H

API WELL #: 47 95 02834

STATE COUNTY PERMIT

AS-BUILT ELEVATION: 880'

QUADRANGLE: CENTER POINT

ACREAGE: 110.00 +/-

ACREAGE: 869.4 +/- 12/02/2022

DRILL CONVERT DRILL DEEPER REDRILL FRACTURE OR STIMULATE
PLUG OFF FORMATION PERFORATE NEW FORMATION PLUG & ABANDON
CLEAN OUT & REPLUG OTHER CHANGE (SPECIFY):

TARGET FORMATION: MARCELLUS

ESTIMATED DEPTH: TVD: 6930' TMD: 17290.85'

WELL OPERATOR: TRIBUNE RESOURCES, LLC

DESIGNATED AGENT: HARMAN BROWN

ADDRESS: 3861 AMBASSADOR CAFFERY PARKWAY SUITE 600

ADDRESS: 18396 MOUNTAINEER HIGHWAY

CITY: LAFAYETTE STATE: LA ZIP CODE: 70503

CITY: WILEYVILLE STATE: WV ZIP CODE: 26581

PROPERTY OWNER INDEX	
5-8-8	WV DEPT. OF NATURAL RESOURCES COMMERCE
5-8-21	JERRY L. WALTERS
5-8-34	ROBERT MARK HUFFMAN
5-8-35	GORDON L SWARTZ IV
5-13-4	ASCENT RESOURCES MARCELLUS MINERALS
5-13-6	JASON GLOVER
5-13-7	ROGER D. & JANET M. FLUHARTY
5-13-65	MELBA JEAN TEMPLETON LIFE ESTATE
5-13-30	MELBA JEAN TEMPLETON LIFE ESTATE
5-13-29	KENNETH DALE NICE JR.
5-13-25	ROYCE J. & ROYAL J. WATTS
5-13-24	DONNA WOLF

LEASE INDEX			
A	MARC00713-000	G	MARC01575-000
B	MARC00713-000	H	MARC03489-000
C	MARC00765-000	I	MARC01363-001
D	Fee 2172-00	J	MARC01228-001
E	MARC00712-000	K	MARC01574-00
F	MARC00722-000		

12/02/2022

FILE #: TRB2

DRAWING #: 3084


SCALE: N/A

DATE: SEPTEMBER 1, 2022

OPERATOR'S WELL #: BFT 4H

API WELL #: 47 095
STATE COUNTY PERMIT

WELL NAME: BFT 4H
CENTER POINT, WV

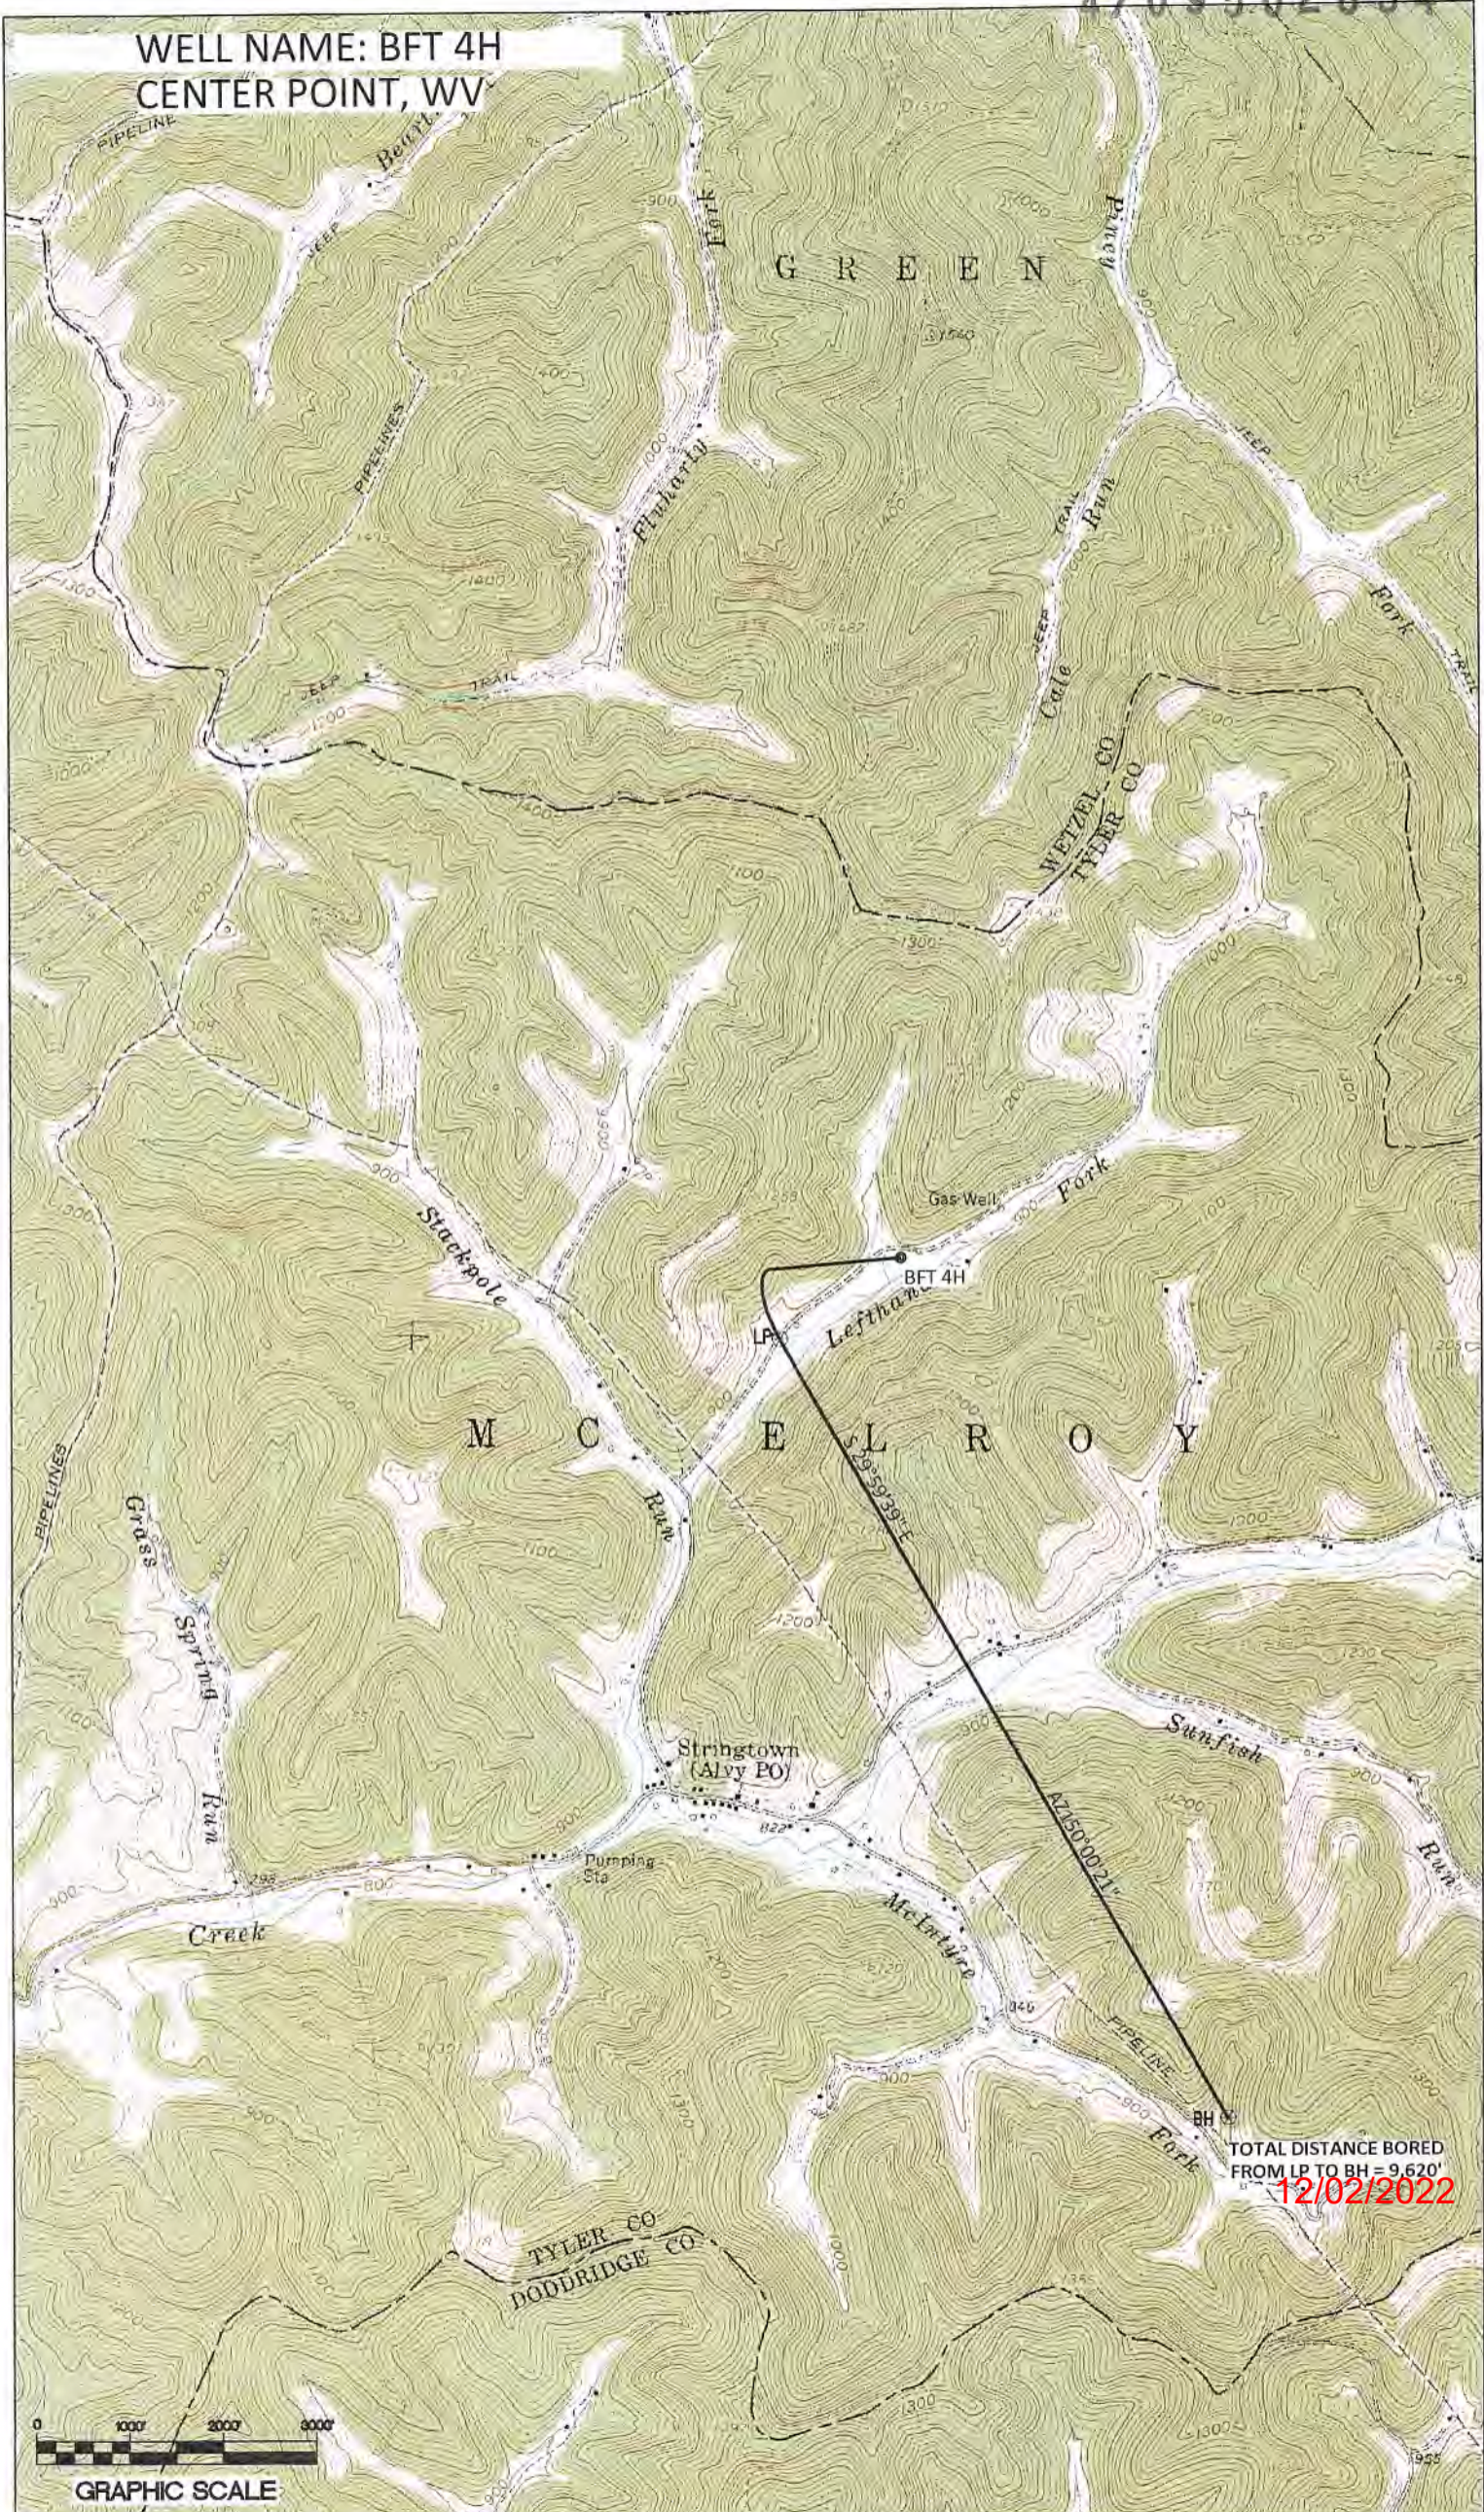

TOTAL DISTANCE BORED
FROM LP TO BH = 9,620'
12/02/2022

