
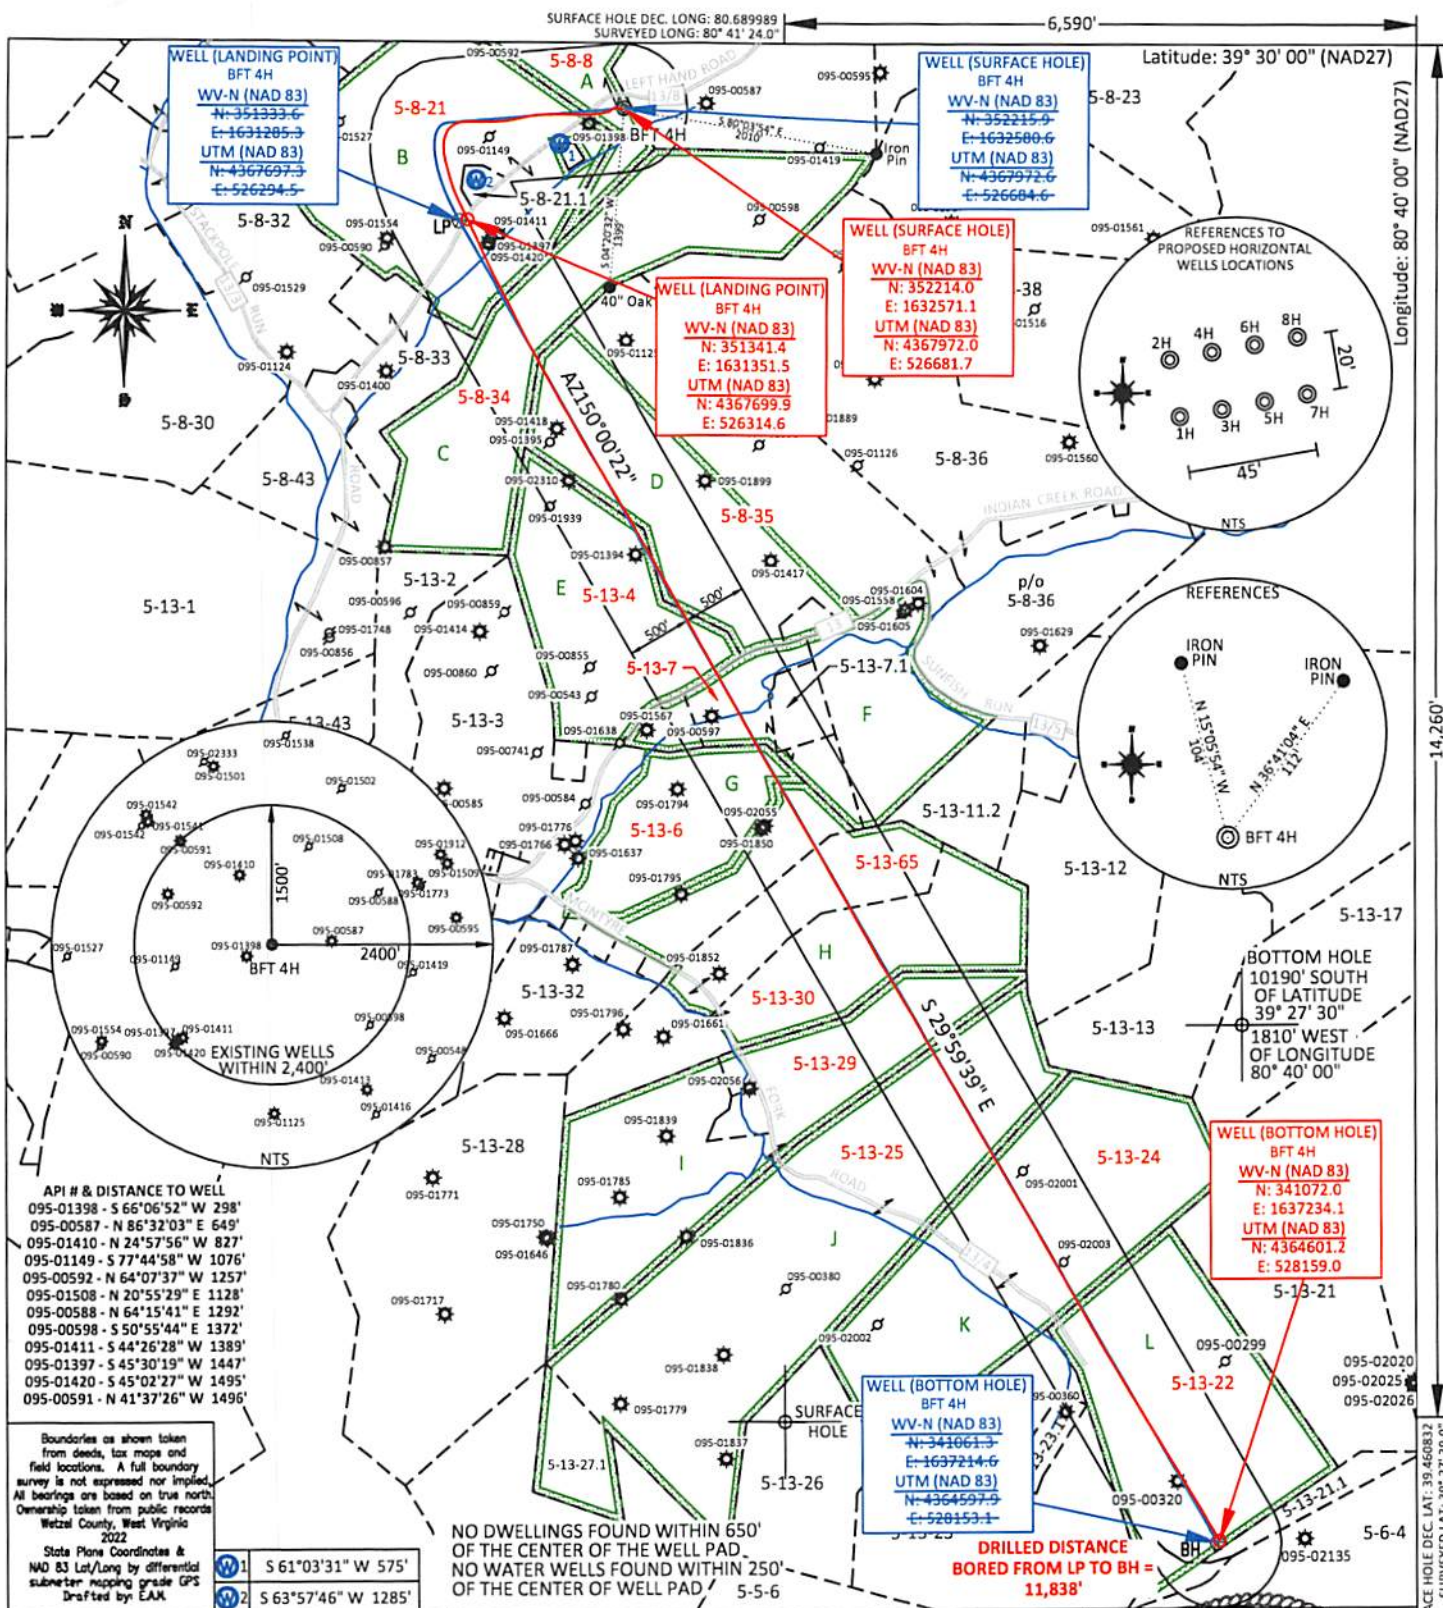


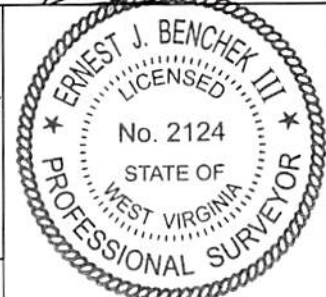


FILE #:	TRB1	I, THE UNDERSIGNED, HEREBY CERTIFY THAT THIS PLAT IS CORRECT TO THE BEST OF MY KNOWLEDGE AND BELIEF AND SHOWS ALL THE INFORMATION REQUIRED BY LAW AND THE REGULATIONS ISSUED AND PRESCRIBED BY THE DEPARTMENT OF ENVIRONMENTAL PROTECTION. Signed:  L.L.S. #2124 : Ernest J. Benchek III			
DRAWING #:	3084				
SCALE:	PLAT: 1" = 1500' TICK: 1" = 2000'				
MINIMUM DEGREE OF ACCURACY:	1/200				
PROVEN SOURCE OF ELEVATION:	SUBMETER MAPPING GRADE GPS	DATE:	NOVEMBER 6, 2025		
WELL TYPE: ☐ Oil ☐ Waste Disposal ☐ Production ☐ Deep ☒ Gas ☐ Liquid Injection ☐ Storage ☒ Shallow		OPERATOR'S WELL #:	BFT 4H AS-DRILLED		
WATERSHED:		OUTLET MIDDLE ISLAND CREEK	API WELL #:	47 95 02834	
COUNTY/DISTRICT:		TYLER / McELROY	STATE	COUNTY	PERMIT
SURFACE OWNER:		WEST VIRGINIA DEPT. OF NATURAL RESOURCES	AS-BUILT ELEVATION:	880'	
OIL & GAS ROYALTY OWNER:		Tribune Resources, LLC, Et Al	QUADRANGLE:	CENTER POINT	
LEASE NUMBERS:			ACREAGE:	110.00 +/-	
			ACREAGE:	938.34	12/19/2025
TARGET FORMATION:		MARCELLUS	DRILL ☒ CONVERT ☐ DRILL DEEPER ☐ REDRILL ☐ FRACTURE OR STIMULATE ☒	DRILLED DEPTH:	TVD: 6,925.43' TMD: 19,459'
WELL OPERATOR:		TRIBUNE RESOURCES, LLC	PLUG OFF FORMATION ☐ PERFORATE NEW FORMATION ☐ PLUG & ABANDON ☐	DESIGNATED AGENT:	HARMAN BROWN
ADDRESS:		3861 AMBASSADOR CAFFERY PARKWAY SUITE 600	CLEAN OUT & REPLUG ☐ OTHER CHANGE ☐ (SPECIFY):	ADDRESS:	18396 MOUNTAINEER HIGHWAY
CITY:		LAFAYETTE		CITY:	WILEYVILLE
STATE:		LA		STATE:	WV
ZIP CODE:		70503		ZIP CODE:	26581

PROPERTY OWNER INDEX	
5-8-8	WV DEPT. OF NATURAL RESOURCES COMMERCE
5-8-21	JERRY L. WALTERS
5-8-34	ASCENT RESOURCES MARCELLUS MINERALS LLC
5-8-35	GORDON L SWARTZ IV
5-13-4	ASCENT RESOURCES MARCELLUS MINERALS
5-13-6	JASON GLOVER
5-13-7	ROGER D. & JANET M. FLUHARTY
5-13-65	MELBA JEAN TEMPLETON LIFE ESTATE
5-13-30	MELBA JEAN TEMPLETON LIFE ESTATE
5-13-29	KENNETH DALE NICE JR.
5-13-25	ROYCE J. & ROYAL J. WATTS
5-13-24	DONNA WOLF
5-13-22	JOSEPH & BARBARA S CUCHTA

LEASE INDEX			
A	MARC00713-000	G	MARC01575-000
B	MARC00713-000	H	MARC03489-000
C	MARC00765-000	I	MARC01363-001
D	Fee 2172-00	J	MARC01228-001
E	MARC00712-000	K	MARC01574-000
F	MARC00722-000	L	MARC05181-000

12/19/2025


FILE #: <u>TRB2</u> DRAWING #: <u>3084</u> SCALE: <u>N/A</u>	DATE: <u>NOVEMBER 6, 2025</u> OPERATOR'S WELL #: <u>BFT 4H AS-DRILLED</u> API WELL #: <u>47</u> <u>095</u> <u>02834</u> STATECOUNTYPERMIT
--	---

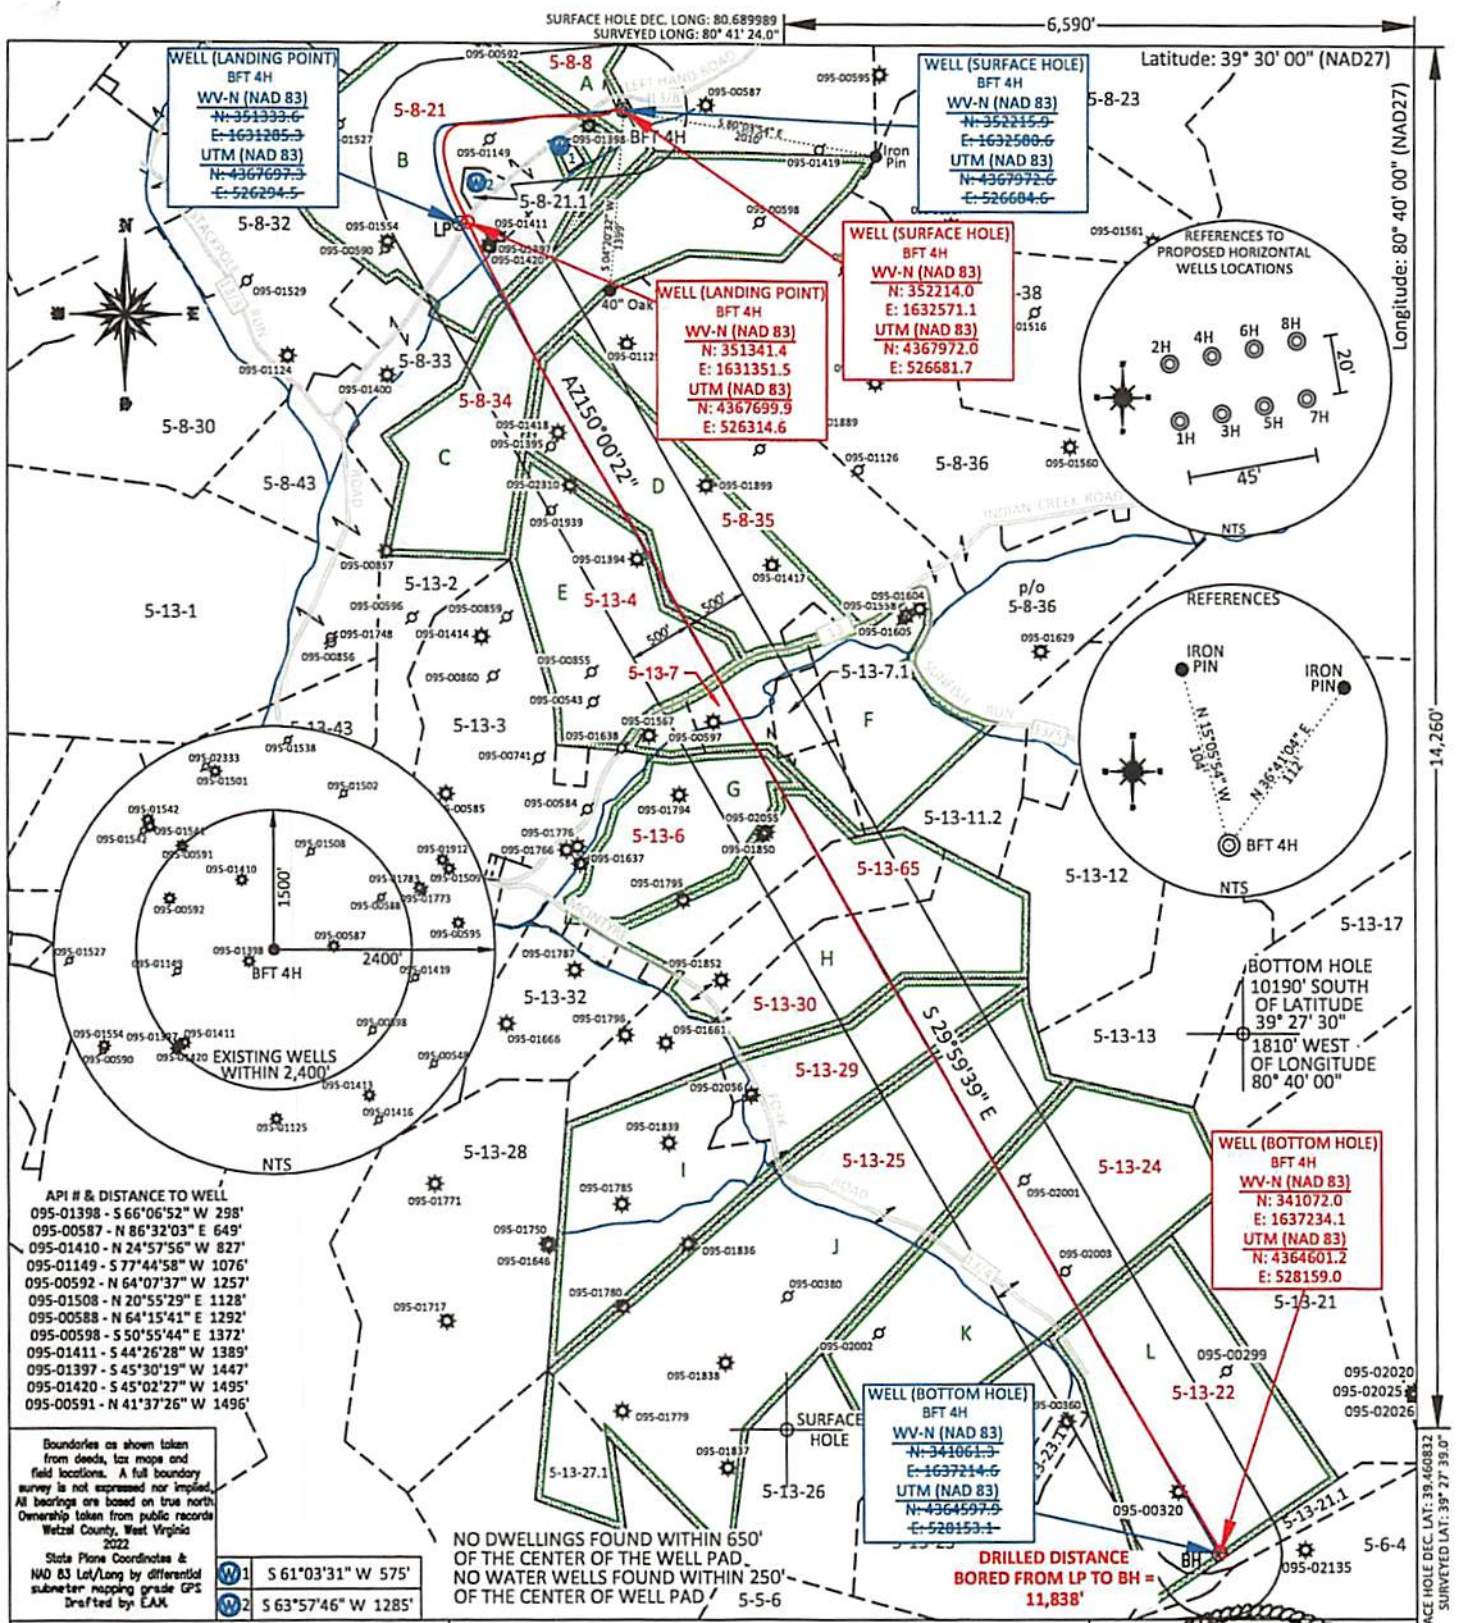

FILE #: TRB1
DRAWING #: 3084
SCALE: PLAT: 1" = 1500'
TICK: 1" = 2000'
MINIMUM DEGREE OF ACCURACY: 1/200
PROVEN SOURCE: SUBMETER MAPPING
OF ELEVATION: GRADE GPS

I, THE UNDERSIGNED, HEREBY CERTIFY THAT THIS PLAT IS CORRECT TO THE BEST OF MY KNOWLEDGE AND BELIEF AND SHOWS ALL THE INFORMATION REQUIRED BY LAW AND THE REGULATIONS ISSUED AND PRESCRIBED BY THE DEPARTMENT OF ENVIRONMENTAL PROTECTION.

Signed: 
L.L.S. #2124 : Ernest J. Benchek III

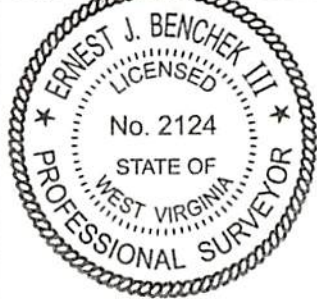

(+) DENOTES LOCATION OF WELL ON UNITED STATES TOPOGRAPHIC MAPS WVDEP

OFFICE OF OIL & GAS
601 57TH STREET
CHARLESTON, WV 25304

Well Type: ☐ Oil ☐ Waste Diposal ☐ Production ☐ Deep ☒ Gas ☐ Liquid Injection ☐ Storage ☒ Shallow

WATERSHED: OUTLET MIDDLE ISLAND CREEK

COUNTY/DISTRICT: TYLER / McELROY

SURFACE OWNER: WEST VIRGINIA DEPT. OF NATURAL RESOURCES

OIL & GAS ROYALTY OWNER: Tribune Resources, LLC, Et Al

LEASE NUMBERS:

DATE: NOVEMBER 6, 2025

OPERATOR'S WELL #: BFT 4H AS-DRILLED

API WELL #: 47 95 02834

STATE COUNTY PERMIT

AS-BUILT ELEVATION: 880'

QUADRANGLE: CENTER POINT

ACREAGE: 110.00 +/-

ACREAGE: 938.34 +/-

12/19/2025

DRILL ☒ CONVERT ☐ DRILL DEEPER ☐ REDRILL ☐ FRACTURE OR STIMULATE ☒
PLUG OFF FORMATION ☐ PERFORATE NEW FORMATION ☐ PLUG & ABANDON ☐
CLEAN OUT & REPLUG ☐ OTHER CHANGE ☐ (SPECIFY):

TARGET FORMATION: MARCELLUS

WELL OPERATOR: TRIBUNE RESOURCES, LLC

ADDRESS: 3861 AMBASSADOR CAFFERY PARKWAY SUITE 600

CITY: LAFAYETTE STATE: LA ZIP CODE: 70503

DRILLED DEPTH: TVD: 6,925.43' TMD: 19,459'

DESIGNATED AGENT: HARMAN BROWN

ADDRESS: 18396 MOUNTAINEER HIGHWAY

CITY: WILEYVILLE STATE: WV ZIP CODE: 26581

PROPERTY OWNER INDEX	
5-8-8	WV DEPT. OF NATURAL RESOURCES COMMERCE
5-8-21	JERRY L. WALTERS
5-8-34	ASCENT RESOURCES MARCELLUS MINERALS LLC
5-8-35	GORDON L SWARTZ IV
5-13-4	ASCENT RESOURCES MARCELLUS MINERALS
5-13-6	JASON GLOVER
5-13-7	ROGER D. & JANET M. FLUHARTY
5-13-65	MELBA JEAN TEMPLETON LIFE ESTATE
5-13-30	MELBA JEAN TEMPLETON LIFE ESTATE
5-13-29	KENNETH DALE NICE JR.
5-13-25	ROYCE J. & ROYAL J. WATTS
5-13-24	DONNA WOLF
5-13-22	JOSEPH & BARBARA S CUCHTA

LEASE INDEX			
A	MARC00713-000	G	MARC01575-000
B	MARC00713-000	H	MARC03489-000
C	MARC00765-000	I	MARC01363-001
D	Fee 2172-00	J	MARC01228-001
E	MARC00712-000	K	MARC01574-000
F	MARC00722-000	L	MARC05181-000

12/19/2025

FILE #: <u>TRB2</u> DRAWING #: <u>3084</u> SCALE: <u>N/A</u>	DATE: <u>NOVEMBER 6, 2025</u> OPERATOR'S WELL #: <u>BFT 4H AS-DRILLED</u> API WELL #: <u>47</u> <u>095</u> <u>02834</u> STATECOUNTYPERMIT
--	---

