


PROPERTY OWNER INDEX	
5-8-8	WV DEPT. OF NATURAL RESOURCES COMMERCE
5-8-21	JERRY L. WALTERS
5-8-19	FRANK A. & MARTHA J. PERRY
5-8-18	FRANK A. & MARTHA J. PERRY
5-8-7	RUSSELL PAUL & CAROL STACKPOLE
5-8-17	RUSSELL PAUL STACKPOLE
5-8-2	ALLEN STACKPOLE ET AL
5-8-6.1	ALLEN D. STACKPOLE
5-8-1	EDWARD G. THOMPSON
5-25-18	WV DIVISION OF NATURAL RESOURCES
5-25-16	COASTAL FOREST RESOURCES CO.
5-25-6	STATE OF WV PUBLIC LAND CORP.
5-8-34	ASCENT RESOURCES MARCELLUS MINERALS LLC

LEASE INDEX			
A	MARC00717-001	H	MARC00726-000
B	MARC00765-000	I	MARC00727-001
C	MARC00713-000	J	MARC02996-000
D	MARC00713-000	K	MARC00744-000
E	MARC00718-001	L	MARC03689-001
F	MARC03491-000	M	MARC03689-001
G	MARC03487-000	N	MARC01099-001

12/19/2025

FILE #: TRB2
DRAWING #: 3079
SCALE: N/A

DATE: NOVEMBER 6, 2025
OPERATOR'S WELL #: BFT 5H AS-DRILLED
API WELL #: 47 095 02835
STATE COUNTY PERMIT

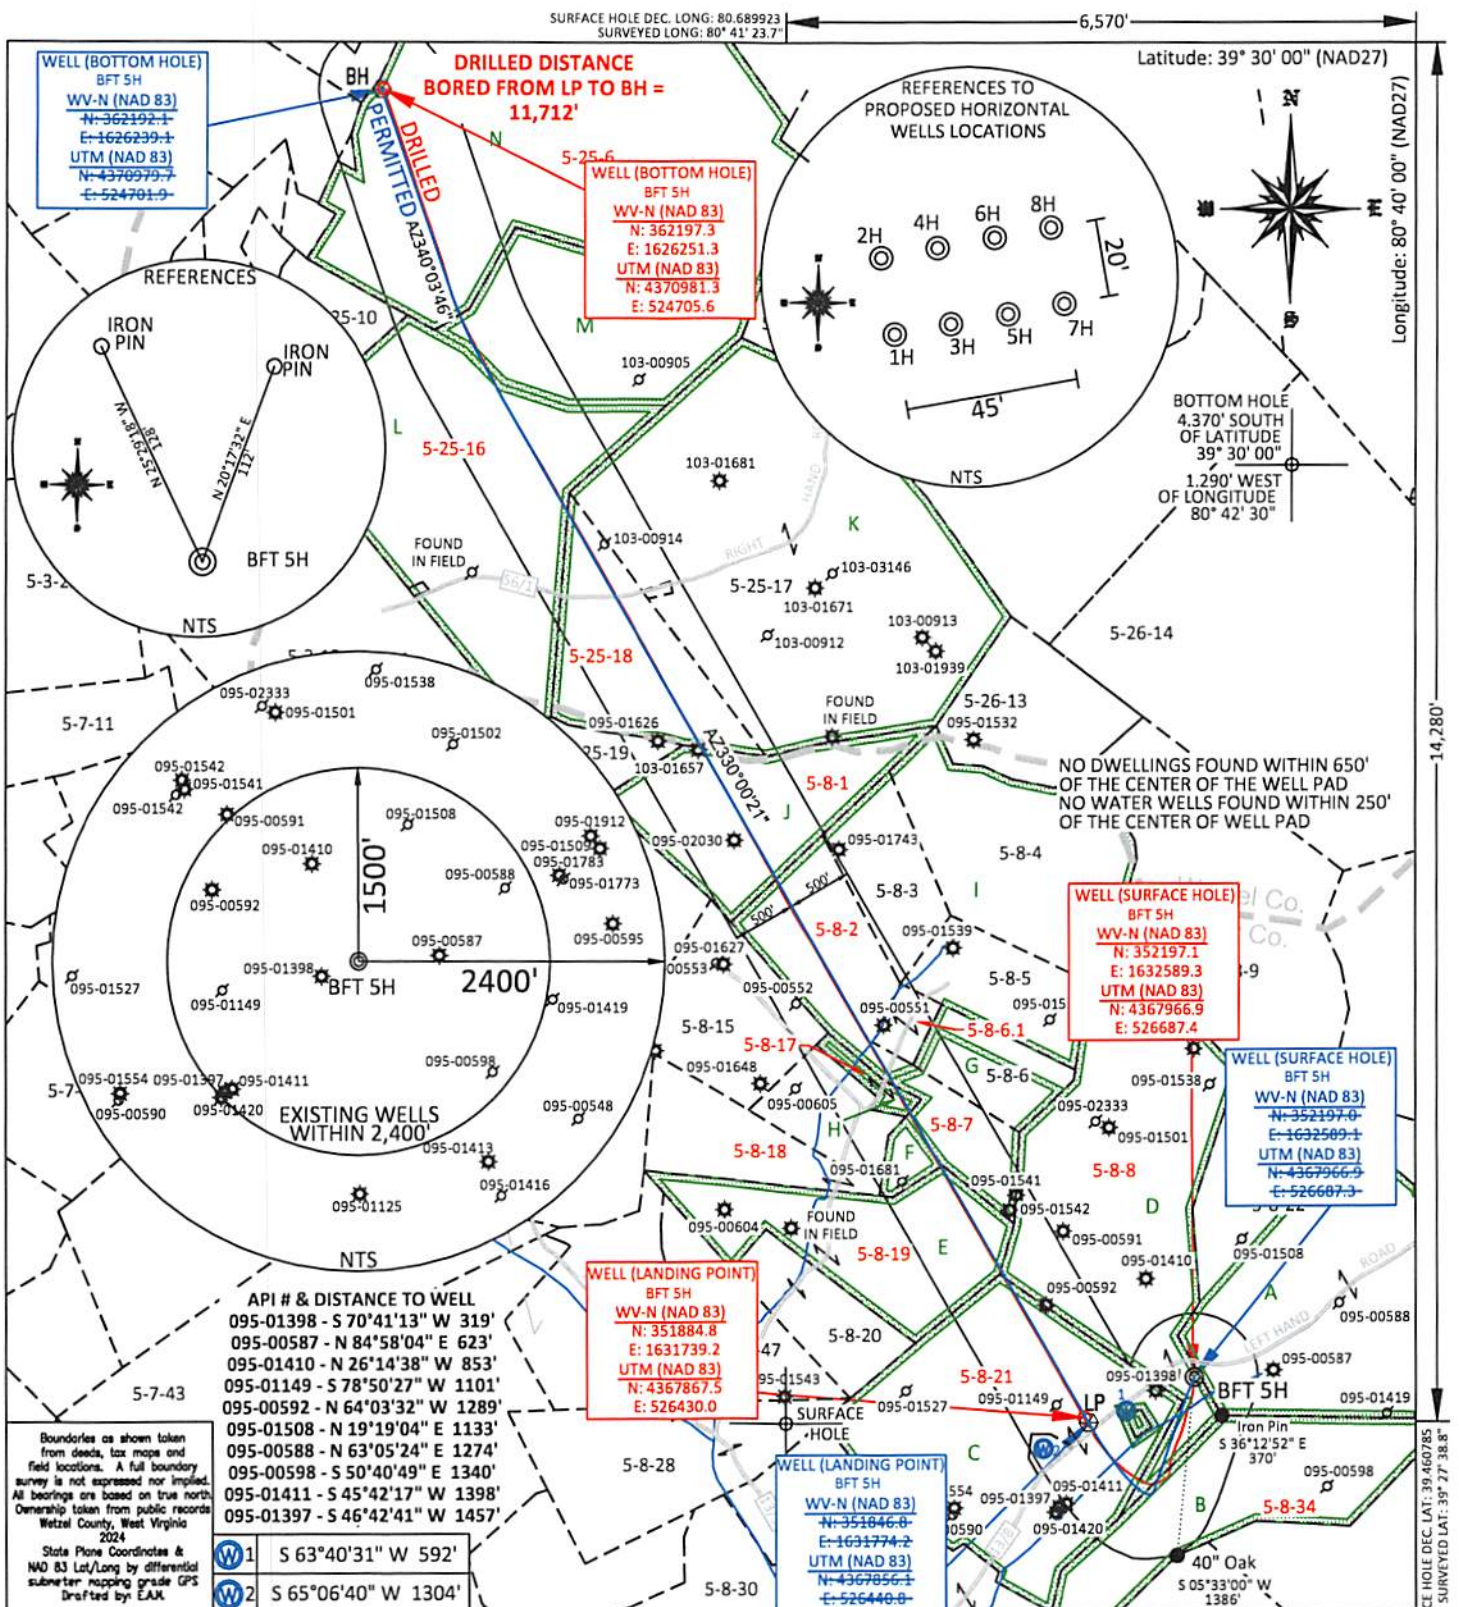

FILE #:	TRB2	I, THE UNDERSIGNED, HEREBY CERTIFY THAT THIS PLAT IS CORRECT TO THE BEST OF MY KNOWLEDGE AND BELIEF AND SHOWS ALL THE INFORMATION REQUIRED BY LAW AND THE REGULATIONS ISSUED AND PRESCRIBED BY THE DEPARTMENT OF ENVIRONMENTAL PROTECTION. Signed:  L.L.S. #2124 : Ernest J. Benchek III	
DRAWING #:	3079		
SCALE:	PLAT: 1" = 1500' TICK: 1" = 2000'		
MINIMUM DEGREE OF ACCURACY:	1/200		
PROVEN SOURCE OF ELEVATION:	SUBMETER MAPPING GRADE GPS		
(+) DENOTES LOCATION OF WELL ON UNITED STATES TOPOGRAPHIC MAPS WVDEP			
OFFICE OF OIL & GAS 601 57TH STREET CHARLESTON, WV 25304		DATE: NOVEMBER 6, 2025	
Well Type: ☐ Oil ☐ Waste Diposal ☐ Production ☐ Deep ☒ Gas ☐ Liquid Injection ☐ Storage ☒ Shallow		OPERATOR'S WELL #: BFT 5H AS-DRILLED	
WATERSHED: OUTLET MIDDLE ISLAND CREEK		API WELL #: 47 95 02835 STATE COUNTY PERMIT	
COUNTY/DISTRICT: TYLER / McELROY		AS-BUILT ELEVATION: 880'	
SURFACE OWNER: WEST VIRGINIA DEPT. OF NATURAL RESOURCES		QUADRANGLE: CENTER POINT	
OIL & GAS ROYALTY OWNER: Tribune Resources, LLC, Et Al		ACREAGE: 110.00 +/-	
LEASE NUMBERS:		ACREAGE: 849.1 + 12/19/2025	
TARGET FORMATION: MARCELLUS		DRILL DEEPER ☐ REDRILL ☐ FRACTURE OR STIMULATE ☒	
WELL OPERATOR: TRIBUNE RESOURCES, LLC		PLUG OFF FORMATION ☐ PERFORATE NEW FORMATION ☐ PLUG & ABANDON ☐	
ADDRESS: 3861 AMBASSADOR CAFFERY PARKWAY SUITE 600		CLEAN OUT & REPLUG ☐ OTHER CHANGE ☐ (SPECIFY):	
CITY: LAFAYETTE STATE: LA ZIP CODE: 70503		DESIGNED AGENT: HARMAN BROWN	
		ADDRESS: 18396 MOUNTAINEER HIGHWAY	
		CITY: WILEYVILLE STATE: WV ZIP CODE: 26581	

PROPERTY OWNER INDEX	
5-8-8	WV DEPT. OF NATURAL RESOURCES COMMERCE
5-8-21	JERRY L. WALTERS
5-8-19	FRANK A. & MARTHA J. PERRY
5-8-18	FRANK A. & MARTHA J. PERRY
5-8-7	RUSSELL PAUL & CAROL STACKPOLE
5-8-17	RUSSELL PAUL STACKPOLE
5-8-2	ALLEN STACKPOLE ET AL
5-8-6.1	ALLEN D. STACKPOLE
5-8-1	EDWARD G. THOMPSON
5-25-18	WV DIVISION OF NATURAL RESOURCES
5-25-16	COASTAL FOREST RESOURCES CO.
5-25-6	STATE OF WV PUBLIC LAND CORP.
5-8-34	ASCENT RESOURCES MARCELLUS MINERALS LLC

LEASE INDEX			
A	MARC00717-001	H	MARC00726-000
B	MARC00765-000	I	MARC00727-001
C	MARC00713-000	J	MARC02996-000
D	MARC00713-000	K	MARC00744-000
E	MARC00718-001	L	MARC03689-001
F	MARC03491-000	M	MARC03689-001
G	MARC03487-000	N	MARC01099-001

12/19/2025

FILE #: TRB2


DRAWING #: 3079

SCALE: N/A

DATE: NOVEMBER 6, 2025

OPERATOR'S WELL #: BFT 5H AS-DRILLED

API WELL #: 47 095 02835
STATE COUNTY PERMIT

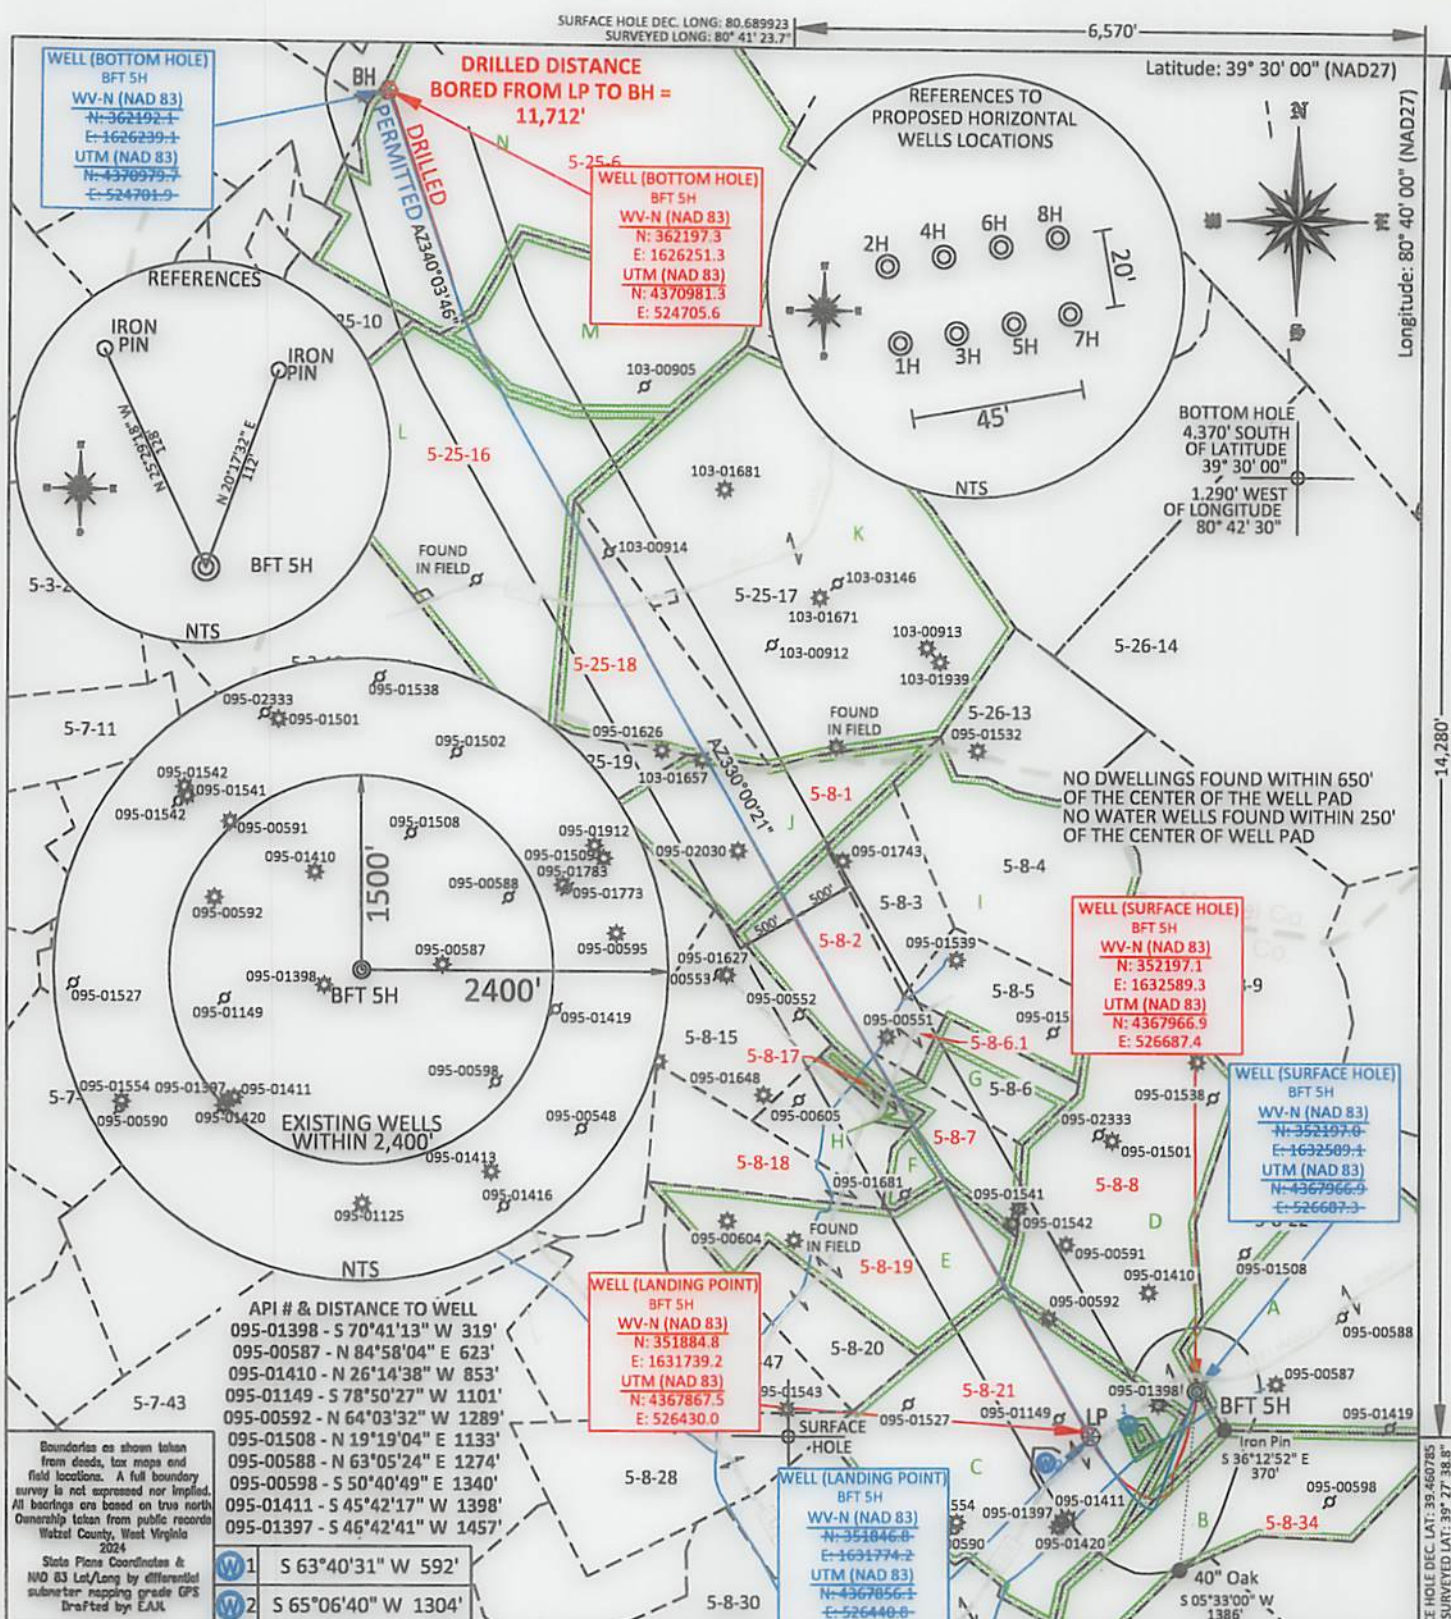

FILE #:	TRB2	I, THE UNDERSIGNED, HEREBY CERTIFY THAT THIS PLAT IS CORRECT TO THE BEST OF MY KNOWLEDGE AND BELIEF AND SHOWS ALL THE INFORMATION REQUIRED BY LAW AND THE REGULATIONS ISSUED AND PRESCRIBED BY THE DEPARTMENT OF ENVIRONMENTAL PROTECTION. Signed:  L.L.S. #2124 : Ernest J. Benchek III			
DRAWING #:	3079				
SCALE:	PLAT: 1" = 1500' TICK: 1" = 2000'				
MINIMUM DEGREE OF ACCURACY:	1/200				
PROVEN SOURCE OF ELEVATION:	SUBMETER MAPPING GRADE GPS	DATE:	NOVEMBER 6, 2025		
WELL Type: ☐ Oil ☐ Waste Diposal ☐ Production ☐ Deep ☒ Gas ☐ Liquid Injection ☐ Storage ☒ Shallow		OPERATOR'S WELL #:	BFT 5H AS-DRILLED		
WATERSHED:		OUTLET MIDDLE ISLAND CREEK	AS-BUILT ELEVATION:	880'	
COUNTY/DISTRICT:		TYLER / McELROY	QUADRANGLE:	CENTER POINT	
SURFACE OWNER:		WEST VIRGINIA DEPT. OF NATURAL RESOURCES	ACREAGE:	110.00 +/-	
OIL & GAS ROYALTY OWNER:		Tribune Resources, LLC, Et Al	ACREAGE:	849.1 +/-	
LEASE NUMBERS:					
TARGET FORMATION:		MARCELLUS	DRILLED DEPTH:	TVD: 6,925.51' TMD: 19,242'	
WELL OPERATOR:		TRIBUNE RESOURCES, LLC	DESIGNATED AGENT:	HARMAN BROWN	
ADDRESS:		3861 AMBASSADOR CAFFERY PARKWAY SUITE 600	ADDRESS:	18396 MOUNTAINEER HIGHWAY	
CITY:		LAFAYETTE	STATE:	LA	
ZIP CODE:		70503	CITY:	WILEYVILLE	
		STATE:	WV	ZIP CODE:	26581