


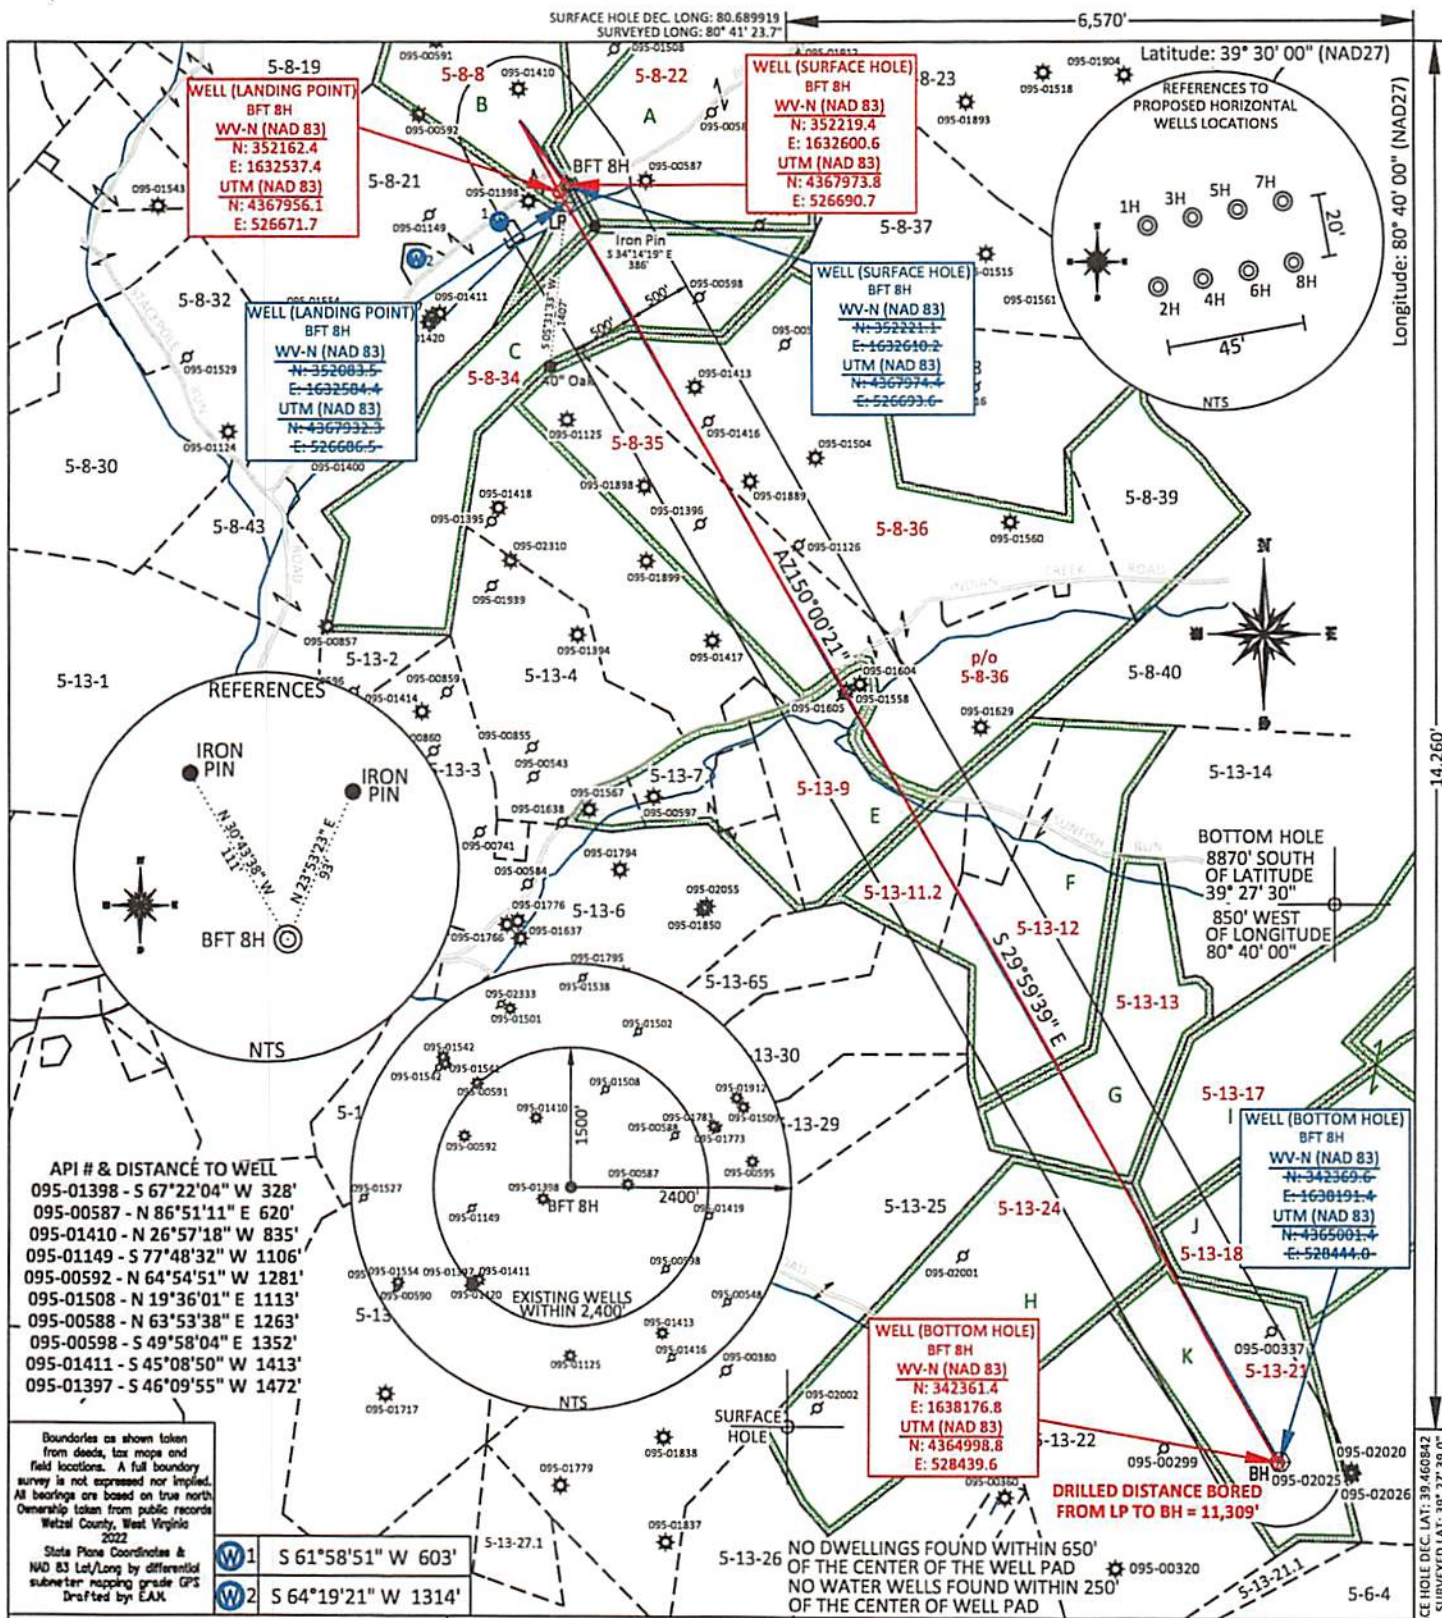

FILE #: TRB1

DRAWING #: 3086

SCALE: PLAT: 1" = 1500' TICK: 1" = 2000'


MINIMUM DEGREE OF ACCURACY: 1/200

PROVEN SOURCE OF ELEVATION: SUBMETER MAPPING GRADE GPS

I, THE UNDERSIGNED, HEREBY CERTIFY THAT THIS PLAT IS CORRECT TO THE BEST OF MY KNOWLEDGE AND BELIEF AND SHOWS ALL THE INFORMATION REQUIRED BY LAW AND THE REGULATIONS ISSUED AND PRESCRIBED BY THE DEPARTMENT OF ENVIRONMENTAL PROTECTION.

Signed: 

L.L.S. #2124 : Ernest J. Benchek III

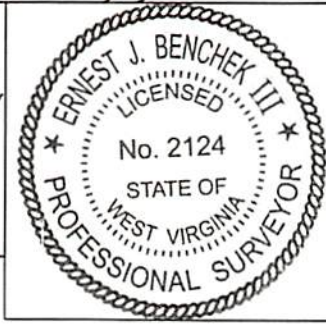

(+) DENOTES LOCATION OF WELL ON UNITED STATES TOPOGRAPHIC MAPS WVDEP

OFFICE OF OIL & GAS
601 57TH STREET
CHARLESTON, WV 25304

Well Type: ☐ Oil ☐ Waste Diposal ☐ Production ☐ Deep ☒ Gas ☐ Liquid Injection ☐ Storage ☒ Shallow

WATERSHED: OUTLET MIDDLE ISLAND CREEK

COUNTY/DISTRICT: TYLER / McELROY

SURFACE OWNER: WEST VIRGINIA DEPT. OF NATURAL RESOURCES

OIL & GAS ROYALTY OWNER: Tribune Resources, LLC, Et Al

LEASE NUMBERS:

DATE: NOVEMBER 6, 2025

OPERATOR'S WELL #: BFT 8H AS-DRILLED

API WELL #: 47 95 02838

STATE COUNTY PERMIT

AS-BUILT ELEVATION: 880'

QUADRANGLE: CENTER POINT

ACREAGE: 110.00 +/-

ACREAGE: 979.01 +/-

12/19/2025

DRILL ☒ CONVERT ☐ DRILL DEEPER ☐ REDRILL ☐ FRACTURE OR STIMULATE ☒

PLUG OFF FORMATION ☐ PERFORATE NEW FORMATION ☐ PLUG & ABANDON ☐

CLEAN OUT & REPLUG ☐ OTHER CHANGE ☐ (SPECIFY):

TARGET FORMATION: MARCELLUS

WELL OPERATOR: TRIBUNE RESOURCES, LLC

ADDRESS: 3861 AMBASSADOR CAFFERY PARKWAY SUITE 600

CITY: LAFAYETTE STATE: LA ZIP CODE: 70503

DRILLED DEPTH: TVD: 6,941.82' TMD: 18,628'

DESIGNATED AGENT: HARMAN BROWN

ADDRESS: 18396 MOUNTAINEER HIGHWAY

CITY: WILEYVILLE STATE: WV ZIP CODE: 26581

PROPERTY OWNER INDEX	
5-8-8	WV DEPT. OF NATURAL RESOURCES COMMERCE
5-8-34	ASCENT RESOURCES MARCELLUS MINERALS LLC
5-8-35	GORDON L SWARTZ IV
5-8-36	GORDON L SWARTZ IV & CHERYL SWARTZ
5-13-9	KENNETH L. & GENIEVA T. GLOVER
5-13-11.2	LEONARD LEE & LINDA LOUGH
5-13-12	RALPH D. THACKER & MAURICE J. CARLISLE
5-13-13	RALPH D THACKER & CARLISLE J MAURICE JR
5-13-24	DONNA WOLF
5-8-22	WV DEPT OF NATURAL RESOURCES COMMERCE DIVISION
5-13-17	RICHARD ALLEN SAFFLE
5-13-18	RICHARD A SAFFLE
5-13-21	JOSEPH & BARBARA S CUCHTA

LEASE INDEX			
A	MARC00717-001	G	MARC05083-000
B	MARC00713-000	H	MARC01574-000
C	MARC00765-000	I	MARC-T1210-000
D	MARC00738-001	J	MARC-T1209-000
E	MARC00722-000	K	MARC-T1206-000
F	MARC03520-000		

12/19/2025

FILE #: TRB2


DRAWING #: 3086

SCALE: N/A

DATE: NOVEMBER 6, 2025

OPERATOR’S WELL #: BFT 8H AS-DRILLED

API WELL #: 47 095 02838
STATE COUNTY PERMIT

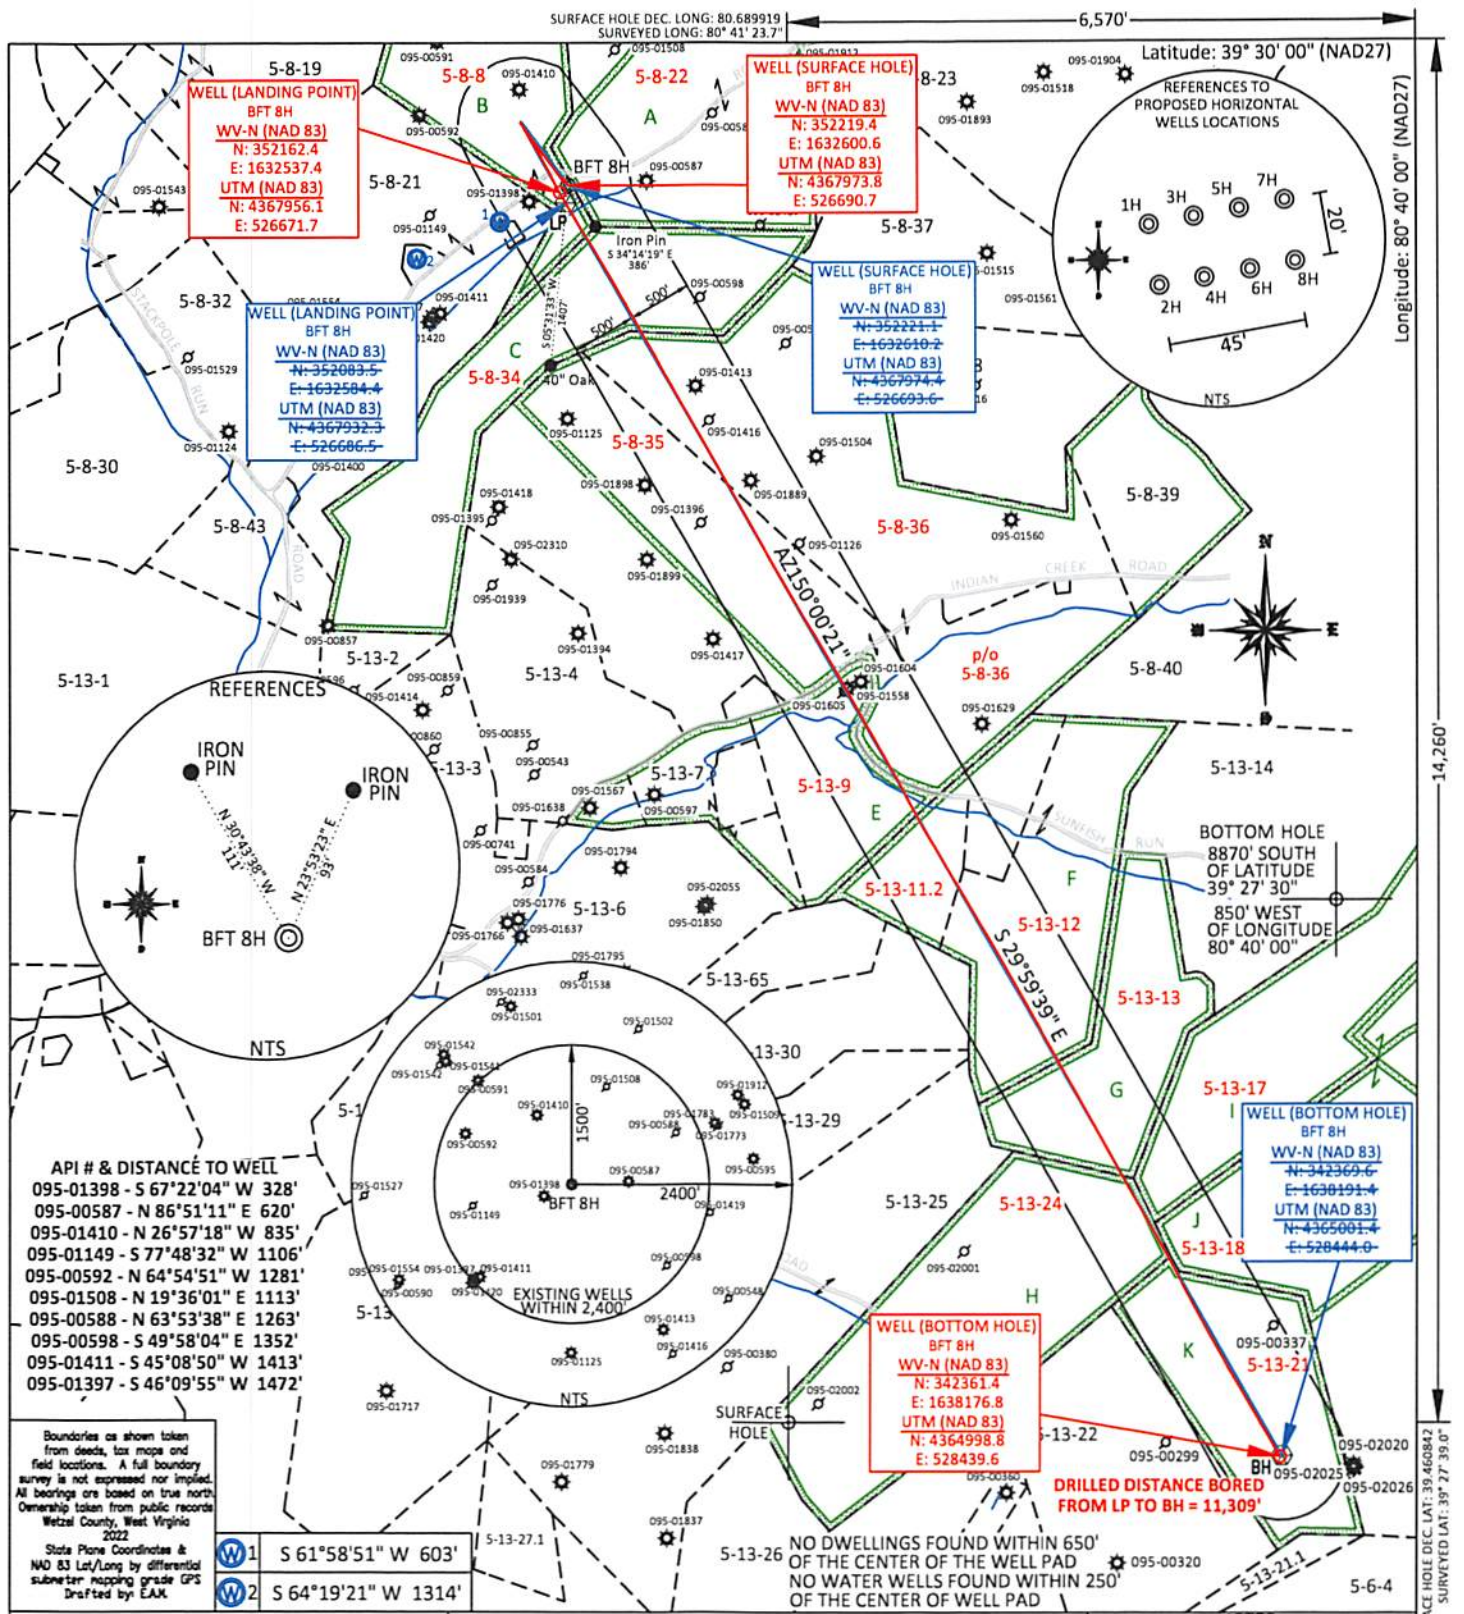

FILE #: TRB1
DRAWING #: 3086
SCALE: PLAT: 1" = 1500'
TICK: 1" = 2000'
MINIMUM DEGREE OF ACCURACY: 1/200
PROVEN SOURCE: SUBMETER MAPPING
OF ELEVATION: GRADE GPS

I, THE UNDERSIGNED, HEREBY CERTIFY THAT THIS PLAT IS CORRECT TO THE BEST OF MY KNOWLEDGE AND BELIEF AND SHOWS ALL THE INFORMATION REQUIRED BY LAW AND THE REGULATIONS ISSUED AND PRESCRIBED BY THE DEPARTMENT OF ENVIRONMENTAL PROTECTION.

Signed: *[Signature]*
L.L.S. #2124: Ernest J. Benchek III



(+) DENOTES LOCATION OF WELL ON UNITED STATES TOPOGRAPHIC MAPS WYDEP
OFFICE OF OIL & GAS
601 57TH STREET
CHARLESTON, WV 25304
Well Type: ☐ Oil ☐ Waste Diposal ☐ Production ☐ Deep
☒ Gas ☐ Liquid Injection ☐ Storage ☒ Shallow
WATERSHED: OUTLET MIDDLE ISLAND CREEK
COUNTY/DISTRICT: TYLER / McELROY
SURFACE OWNER: WEST VIRGINIA DEPT. OF NATURAL RESOURCES
OIL & GAS ROYALTY OWNER: Tribune Resources, LLC, Et Al
LEASE NUMBERS:


DRILL ☒ CONVERT ☐ DRILL DEEPER ☐ REDRILL ☐ FRACTURE OR STIMULATE ☒
PLUG OFF FORMATION ☐ PERFORATE NEW FORMATION ☐ PLUG & ABANDON ☐
CLEAN OUT & REPLUG ☐ OTHER CHANGE ☐ (SPECIFY):
TARGET FORMATION: MARCELLUS
WELL OPERATOR: TRIBUNE RESOURCES, LLC
ADDRESS: 3861 AMBASSADOR CAFFERY PARKWAY SUITE 600
CITY: LAFAYETTE STATE: LA ZIP CODE: 70503
DRILLED DEPTH: TVD: 6,941.82' TMD: 18,628'
DESIGNATED AGENT: HARMAN BROWN
ADDRESS: 18396 MOUNTAINEER HIGHWAY
CITY: WILEYVILLE STATE: WV ZIP CODE: 26581

PROPERTY OWNER INDEX	
5-8-8	WV DEPT. OF NATURAL RESOURCES COMMERCE
5-8-34	ASCENT RESOURCES MARCELLUS MINERALS LLC
5-8-35	GORDON L SWARTZ IV
5-8-36	GORDON L SWARTZ IV & CHERYL SWARTZ
5-13-9	KENNETH L. & GENIEVA T. GLOVER
5-13-11.2	LEONARD LEE & LINDA LOUGH
5-13-12	RALPH D. THACKER & MAURICE J. CARLISLE
5-13-13	RALPH D THACKER & CARLISLE J MAURICE JR
5-13-24	DONNA WOLF
5-8-22	WV DEPT OF NATURAL RESOURCES COMMERCE DIVISION
5-13-17	RICHARD ALLEN SAFFLE
5-13-18	RICHARD A SAFFLE
5-13-21	JOSEPH & BARBARA S CUCHTA

LEASE INDEX			
A	MARC00717-001	G	MARC05083-000
B	MARC00713-000	H	MARC01574-000
C	MARC00765-000	I	MARC-T1210-000
D	MARC00738-001	J	MARC-T1209-000
E	MARC00722-000	K	MARC-T1206-000
F	MARC03520-000		

12/19/2025

FILE #: <u>TRB2</u>	DATE: <u>NOVEMBER 6, 2025</u>
DRAWING #: <u>3086</u>	OPERATOR'S WELL #: <u>BFT 8H AS-DRILLED</u>
SCALE: <u>N/A</u>	API WELL #: <u>47</u> <u>095</u> <u>02838</u> STATE COUNTY PERMIT

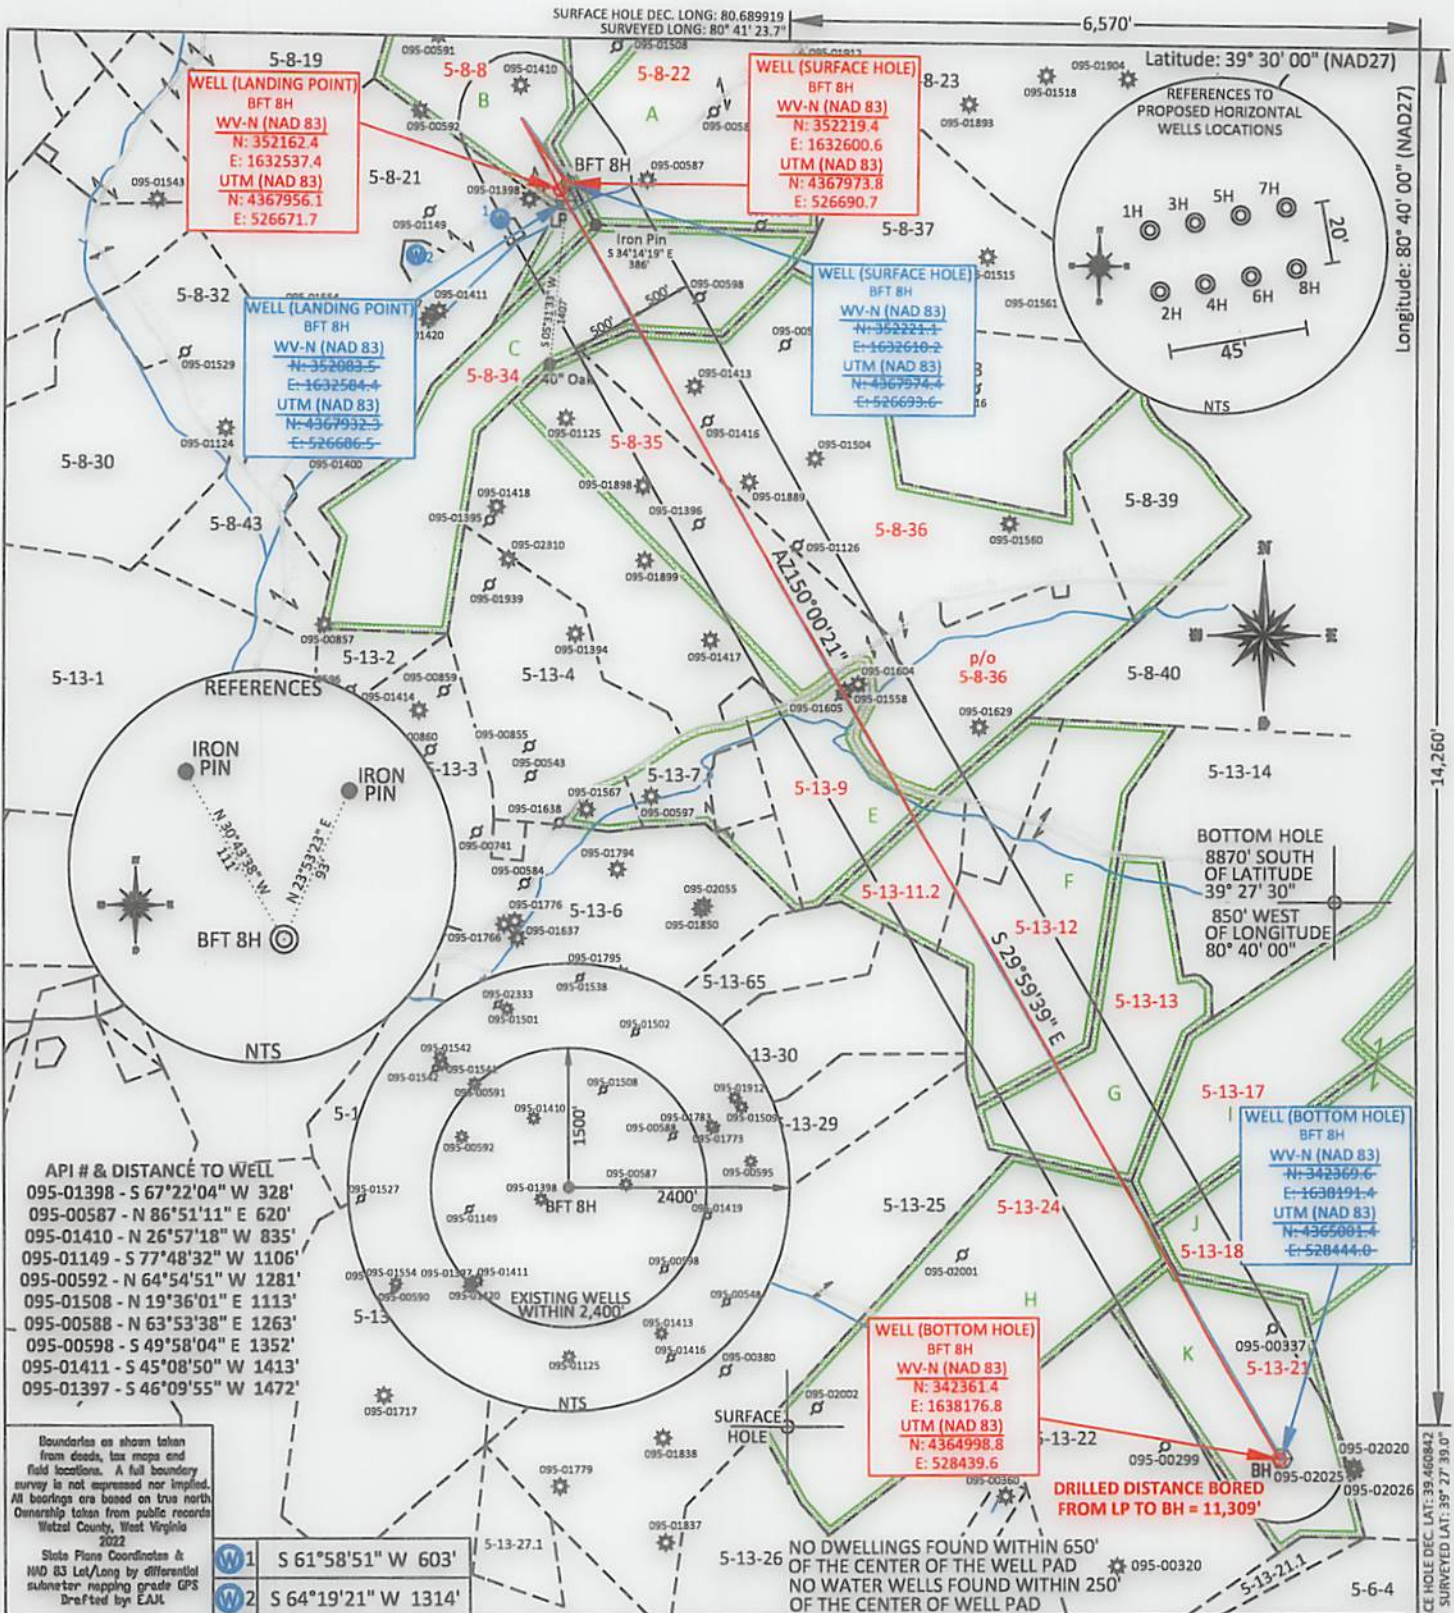

FILE #:	TRB1	I, THE UNDERSIGNED, HEREBY CERTIFY THAT THIS PLAT IS CORRECT TO THE BEST OF MY KNOWLEDGE AND BELIEF AND SHOWS ALL THE INFORMATION REQUIRED BY LAW AND THE REGULATIONS ISSUED AND PRESCRIBED BY THE DEPARTMENT OF ENVIRONMENTAL PROTECTION. Signed: L.L.S. #2124 : Ernest J. Benchek III			
DRAWING #:	3086				
SCALE:	PLAT: 1" = 1500' TICK: 1" = 2000'				
MINIMUM DEGREE OF ACCURACY:	1/200				
PROVEN SOURCE OF ELEVATION:	SUBMETER MAPPING GRADE GPS	DATE:	NOVEMBER 6, 2025		
WELL TYPE: ☐ Oil ☐ Waste Diposal ☐ Production ☐ Deep ☒ Gas ☐ Liquid Injection ☐ Storage ☒ Shallow		OPERATOR'S WELL #:	BFT 8H AS-DRILLED		
WATERSHED:		OUTLET MIDDLE ISLAND CREEK	API WELL #:	47 95 02838	
COUNTY/DISTRICT:		TYLER / McELROY	STATE	COUNTY	PERMIT
SURFACE OWNER:		WEST VIRGINIA DEPT. OF NATURAL RESOURCES	AS-BUILT ELEVATION:	880'	
OIL & GAS ROYALTY OWNER:		Tribune Resources, LLC, Et Al	QUADRANGLE:	CENTER POINT	
LEASE NUMBERS:			ACREAGE:	110.00 +/-	
			ACREAGE:	979.01	12/19/2025
TARGET FORMATION:		MARCELLUS	DRILLED DEPTH:	TVD: 6,941.82' TMD: 18,628'	
WELL OPERATOR:		TRIBUNE RESOURCES, LLC	DESIGNATED AGENT:	HARMAN BROWN	
ADDRESS:		3861 AMBASSADOR CAFFERY PARKWAY SUITE 600	ADDRESS:	18396 MOUNTAINEER HIGHWAY	
CITY:		LAFAYETTE	STATE:	WV	ZIP CODE: 26581
		STATE:	LA	ZIP CODE:	70503