

Antero Resources Corporation

Appalachian Basin

Starkey Pad

Tyler County

Quadrangle: Paden City

Watershed: Outlet Middle Island Creek

District: Lincoln

Date: 9-25-2023

05/30/2025

Antero Resources
Well No. Grey 1H

Antero Resources Corporation




- Legend
- Proposed gas well
 - Monument, as noted
 - Existing Well, as noted
 - Digitized Well, as noted
 - Creek or Drain
 - Road
 - Surface boundary (approx.)
 - Interior surface tracts (approx.)

I, the undersigned, hereby certify that this plat is correct to the best of my knowledge and belief and shows all the information required by law and the rules issued and prescribed by the Department of Environmental Protection.

Bradley D. Miller, P.S. 2167



SEAL

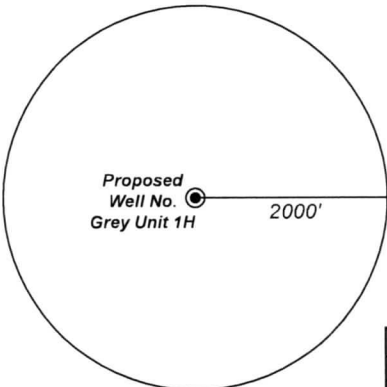

Note: No water wells were found within 2000' of proposed well. No occupied dwellings or buildings 2,500 square feet or larger used to house or shelter dairy cattle or poultry husbandry are located within 625' of the center of the well pad.

ID	TM-Par	Owner	Bk/Pg	Acres
1	5 / 4	Ralph D. & Sophia Judge	306 / 681	60.77
2	5 / 9	Sally Anderson (Life Trust)	368 / 92	25.89
3	5 / 9.4	Neil R. Stebbins	366 / 436	51.48
4	5 / 12	Robert F. & Rita K. Scardina	320 / 646	25.00
5	5 / 10	Robert F. & Rita K. Scardina	320 / 646	25.00
6	5 / 11	Robert F. & Rita K. Scardina	320 / 646	25.00

Leases	
A	AMP IV LP
B	Robert F. & Rita K. Scardina
C	Robert F. & Rita K. Scardina
D	Robert F. & Rita K. Scardina

FILE NO: 156-54-L-23
DRAWING NO: Grey Unit 1H Shorty
SCALE: 1" = 1000'
MINIMUM DEGREE OF ACCURACY: Submeter
PROVEN SOURCE OF ELEVATION: WVDOT, Harrisville, WV


STATE OF WEST VIRGINIA
DEPARTMENT OF ENVIRONMENTAL PROTECTION
OIL AND GAS DIVISION

DATE: April 11 20 25
OPERATOR'S WELL NO. Grey Unit 1H
API WELL NO
47 - 95 - D2934
STATE COUNTY PERMIT

WELL TYPE: ☐ OIL ☒ GAS ☐ LIQUID INJECTION ☐ WASTE DISPOSAL
(IF GAS) PRODUCTION: ☐ STORAGE ☐ DEEP ☒ SHALLOW
LOCATION: ELEVATION: As-Built 1,092' WATERSHED: Outlet Middle Island Creek QUADRANGLE: Paden City
DISTRICT: Lincoln COUNTY: Tyler
SURFACE OWNER: Robert F. Scardina & Rita K. Scardina ACREAGE: 25.00 05/30/2025
ROYALTY OWNER: Robert F. Scardina & Rita K. Scardina LEASE NO: ACREAGE: 25.00
PROPOSED WORK: ☒ DRILL ☐ CONVERT ☐ DRILL DEEPER ☒ FRACTURE OR STIMULATE ☐ PLUG OFF OLD FORMATION
☒ PERFORATE NEW FORMATION ☐ OTHER PHYSICAL CHANGE IN WELL (SPECIFY)
☐ PLUG AND ABANDON ☐ CLEAN OUT AND REPLUG TARGET FORMATION: Marcellus Shale ESTIMATED DEPTH: 8,700' MD 6,700' TVD

WELL OPERATOR: Antero Resources Corporation DESIGNATED AGENT: Conrad Baston
ADDRESS: 1615 Wynkoop Street ADDRESS: 535 White Oaks Blvd.
Denver, CO 80202 Bridgeport, WV 26330


Bearing	Dist.
L1 S 34°03' W	1,089.6'
L2 S 06°43' E	1,259.0'
L3 S 89°17' E	1,601.9'
L4 N 63°06' E	1,251.8'
L5 N 11°43' E	321.7'

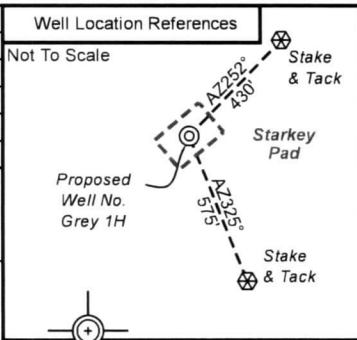

LATITUDE 39 - 35 - 00

LONGITUDE 80 - 55 - 00

Wellhead Layout (NTS)

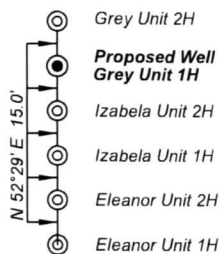

Notes:


Well No. Grey Unit 1H
UTM Zone 17, NAD 1927
Top Hole Coordinates
N: 14,368,659.37'
E: 1,660,227.26'
Point of Entry Coordinates
N: 14,368,975.33'
E: 1,660,287.34'
Bottom Hole Coordinates
N: 14,369,869.43'
E: 1,660,088.94'

Notes


West Virginia Coordinate System of 1927, North Zone based upon Differential GPS Measurements.
Well No. Grey Unit 1H Top Hole coordinates are
N: 392,102.51' Latitude: 39°34'03.88"
E: 1,596,965.90' Longitude: 80°55'46.93"
Bottom Hole coordinates are
N: 393,315.12' Latitude: 39°34'15.85"
E: 1,596,847.76' Longitude: 80°55'48.69"
UTM Zone 17, NAD 1983
Top Hole Coordinates Bottom Hole Coordinates
N: 4,379,793.800m N: 4,380,162.628m
E: 506,052.960m E: 506,010.810m
Plat orientation and corner and well references are based upon the grid north meridian.
Well location references are based upon the magnetic meridian.


Antero Resources
Well No. Grey 1H


Antero Resources Corporation





Legend

 
 Proposed gas well


 Monument, as noted


 Existing Well, as noted

 Digitized Well, as noted


 Creek or Drain

 Road


 Surface boundary (approx.)

 Interior surface tracts (approx.)


I, the undersigned, hereby certify that this plat is correct to the best of my knowledge and belief and shows all the information required by law and the rules issued and prescribed by the Department of Environmental Protection.

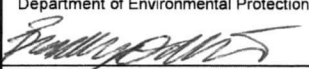

Bradley D. Miller, P.S. 2167



SEAL

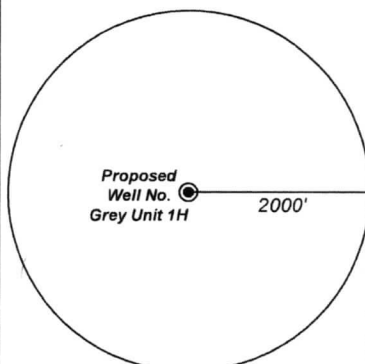

Note: No water wells were found within 2000' of proposed well. No occupied dwellings or buildings 2,500 square feet or larger used to house or shelter dairy cattle or poultry husbandry are located within 625' of the center of the well pad.

3,813' to Bottom Hole

3,675' to Top Hole


LATITUDE 39 - 35 - 00

LONGITUDE 80 - 55 - 00

	Bearing	Dist.
L1	S 34°03' W	1,089.6'
L2	S 06°43' E	1,259.0'
L3	S 89°17' E	1,601.9'
L4	N 63°06' E	1,251.8'
L5	N 11°43' E	321.7'

Well Location References

Not To Scale

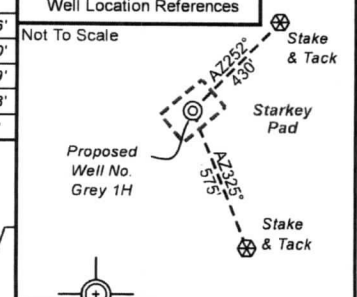

Proposed Well No. Grey 1H

BTM Hole 7.5' Spot

Top Hole 7.5' Spot

Grey Unit 1H Bottom Hole

5/8" Rebar

500' Buffer


Rebar w/ cap (Summers)

Stone

POE L5

Proposed Well No. Grey 1H

Wellhead Layout (NTS)

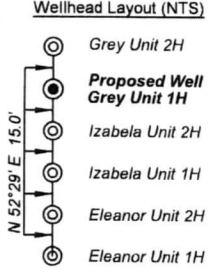

Notes:

Well No. Grey Unit 1H
UTM Zone 17, NAD 1927

Top Hole Coordinates
N: 14,368,659.37'
E: 1,660,227.26'

Point of Entry Coordinates
N: 14,368,975.33'
E: 1,660,287.34'

Bottom Hole Coordinates
N: 14,369,869.43'
E: 1,660,088.94'

Notes

West Virginia Coordinate System of 1927, North Zone based upon Differential GPS Measurements.

Well No. Grey Unit 1H Top Hole coordinates are
N: 392,102.51' Latitude: 39°34'03.88"
E: 1,596,965.90' Longitude: 80°55'46.93"

Bottom Hole coordinates are
N: 393,315.12' Latitude: 39°34'15.85"
E: 1,596,847.76' Longitude: 80°55'48.69"

UTM Zone 17, NAD 1983

Top Hole Coordinates Bottom Hole Coordinates
N: 4,379,793.800m N: 4,380,162.628m
E: 506,052.960m E: 506,010.810m

Plat orientation and corner and well references are based upon the grid north meridian.

Well location references are based upon the magnetic meridian.

ID	TM-Par	Owner	Bk/Pg	Acres
1	5 / 4	Ralph D. & Sophia Judge	306 / 681	60.77
2	5 / 9	Sally Anderson (Life Trust)	368 / 92	25.89
3	5 / 9.4	Neil R. Stebbins	366 / 436	51.48
4	5 / 12	Robert F. & Rita K. Scardina	320 / 646	25.00
5	5 / 10	Robert F. & Rita K. Scardina	320 / 646	25.00
6	5 / 11	Robert F. & Rita K. Scardina	320 / 646	25.00

Leases

A

AMP IV LP

B

Robert F. & Rita K. Scardina

C

Robert F. & Rita K. Scardina

D

Robert F. & Rita K. Scardina

FILE NO: 156-54-L-23

DRAWING NO: Grey Unit 1H Shorty

SCALE: 1" = 1000'

MINIMUM DEGREE OF ACCURACY: Submeter

PROVEN SOURCE OF ELEVATION: WVDOT, Harrisville, WV

STATE OF WEST VIRGINIA

DEPARTMENT OF ENVIRONMENTAL PROTECTION

OIL AND GAS DIVISION

DATE: April 11 20 25

OPERATOR'S WELL NO. Grey Unit 1H

API WELL NO

47 - 95 - 02934

STATE COUNTY PERMIT

WELL TYPE: ☐ OIL ☒ GAS ☐ LIQUID INJECTION ☐ WASTE DISPOSAL

(IF GAS) PRODUCTION: ☐ STORAGE ☐ DEEP ☒ SHALLOW

LOCATION: ELEVATION: As-Built 1,092' WATERSHED: Outlet Middle Island Creek QUADRANGLE: Paden City

DISTRICT: Lincoln COUNTY: Tyler

SURFACE OWNER: Robert F. Scardina & Rita K. Scardina ACREAGE: 25.00

ROYALTY OWNER: Robert F. Scardina & Rita K. Scardina LEASE NO: ACREAGE: 25.00

PROPOSED WORK: ☒ DRILL ☐ CONVERT ☐ DRILL DEEPER ☒ FRACTURE OR STIMULATE ☐ PLUG OFF OLD FORMATION

☒ PERFORATE NEW FORMATION ☐ OTHER PHYSICAL CHANGE IN WELL (SPECIFY)

☐ PLUG AND ABANDON ☐ CLEAN OUT AND REPLUG TARGET FORMATION: Marcellus Shale ESTIMATED DEPTH: 6,700' TVD 8,700' MD

WELL OPERATOR: Antero Resources Corporation

DESIGNATED AGENT: Conrad Baston

ADDRESS: 1615 Wynkoop Street

ADDRESS: 535 White Oaks Blvd.

Denver, CO 80202

Bridgeport, WV 26330

Grey
4/12/25