


LATITUDE 39° 30'

LONGITUDE 80° 30'

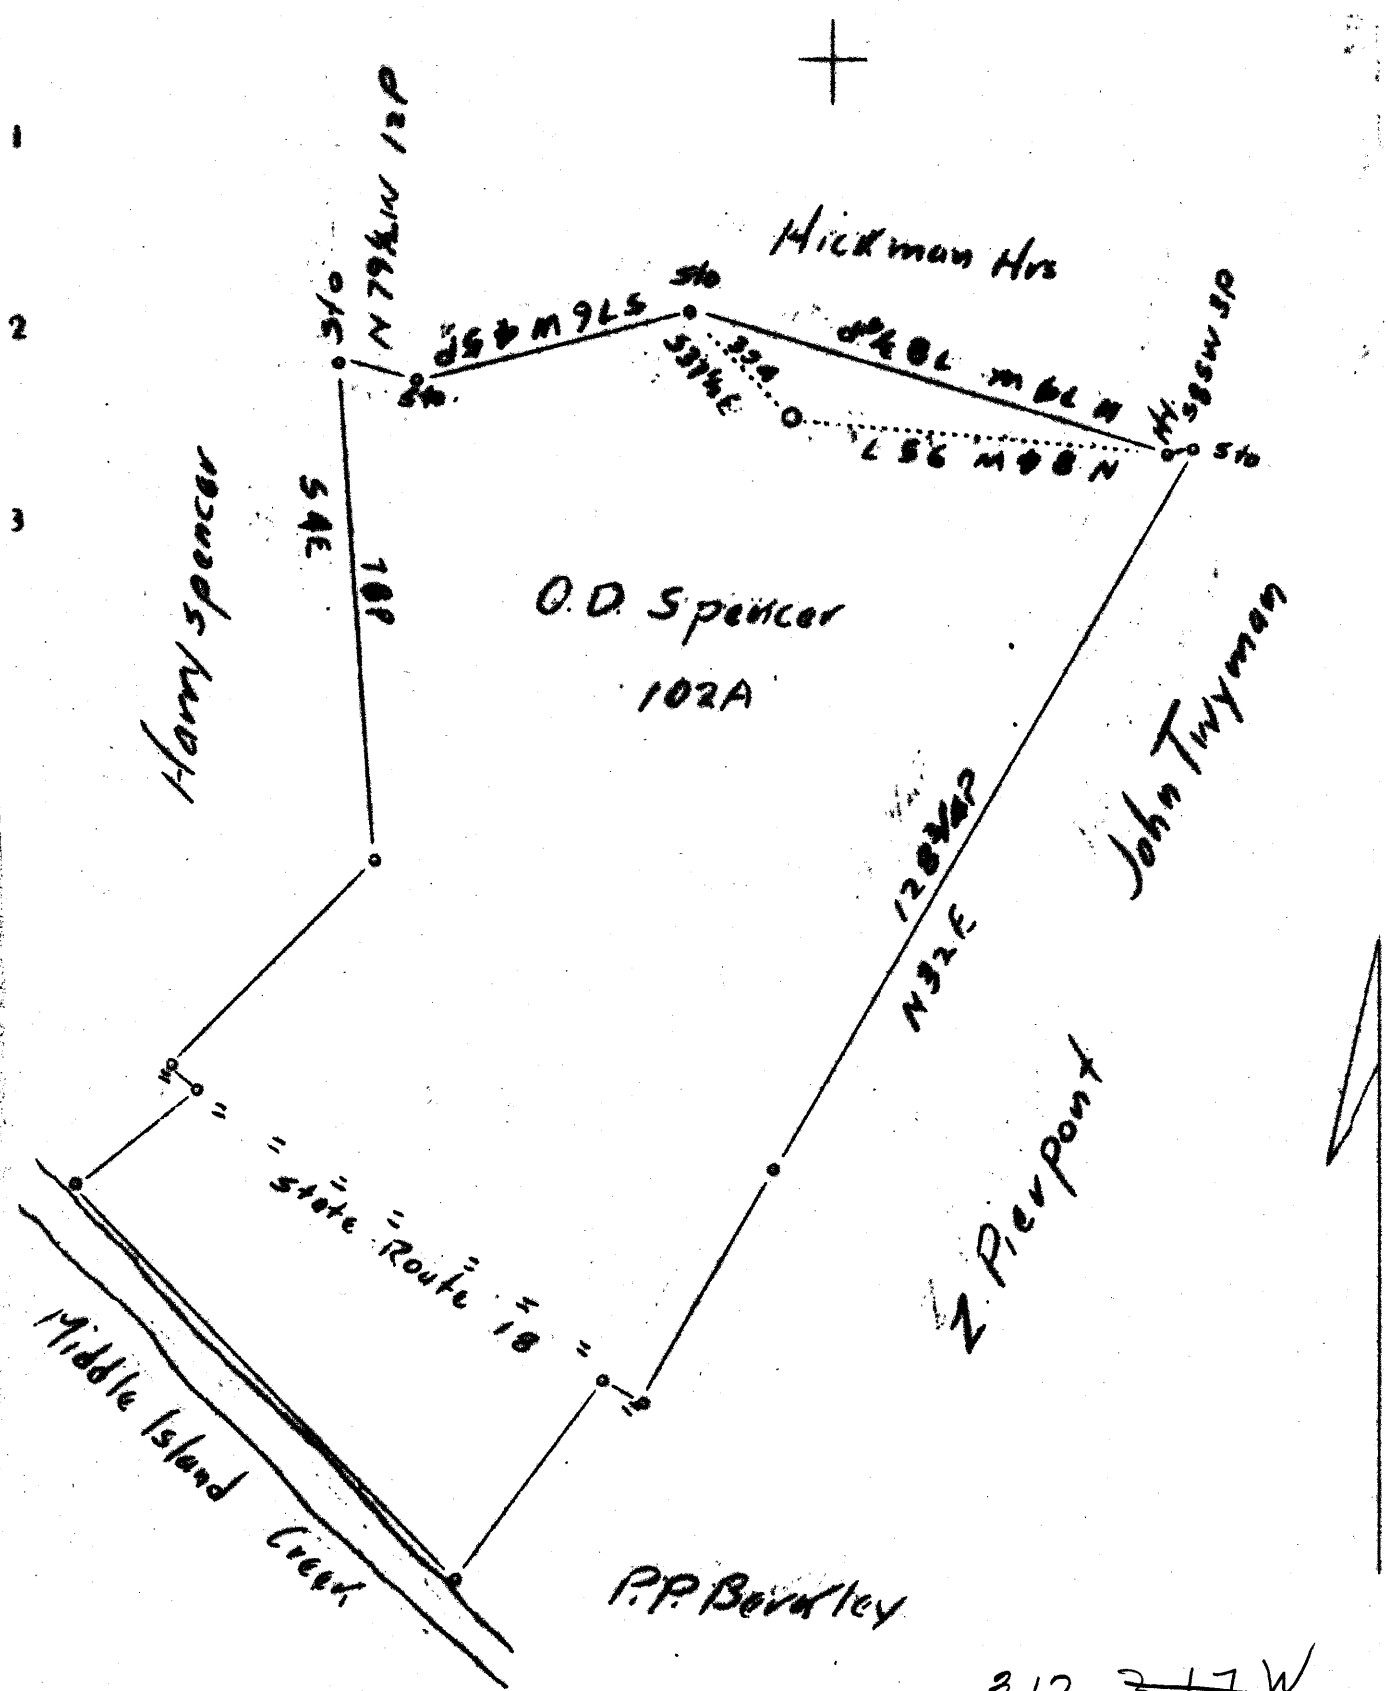

3.12 3.17 W
0.78 8

Abandonment

Company	Geo. McGrutchen
Address	Middlebourne, W. Va.
Farm Q.D.	Spencer
Tract	Acres 102 Lease No.
Well (Farm) No.	6 Serial No.
Elevation (Spirit Level)	805'
Quadrangle	West Union (n 6)
County	Tyler District Ellsworth
Engineer	J.S. Haight
Engineer's Registration No.	Co. Surveyor
File No.	Drawing No.
Date	6-25-37 Scale 1"=30 rds.

STATE OF WEST VIRGINIA
Department of Mines
OIL AND GAS DIVISION
CHARLESTON

WELL LOCATION MAP
File No. TYL-134A

+ Denotes location of well on United States Topographic Maps, Scale 1 to 62,500, latitude and longitude lines being represented by border lines as shown.
-- Denotes one inch spaces on border line of original tracings