


Latitude 39° 35'

Longitude 81° 00'

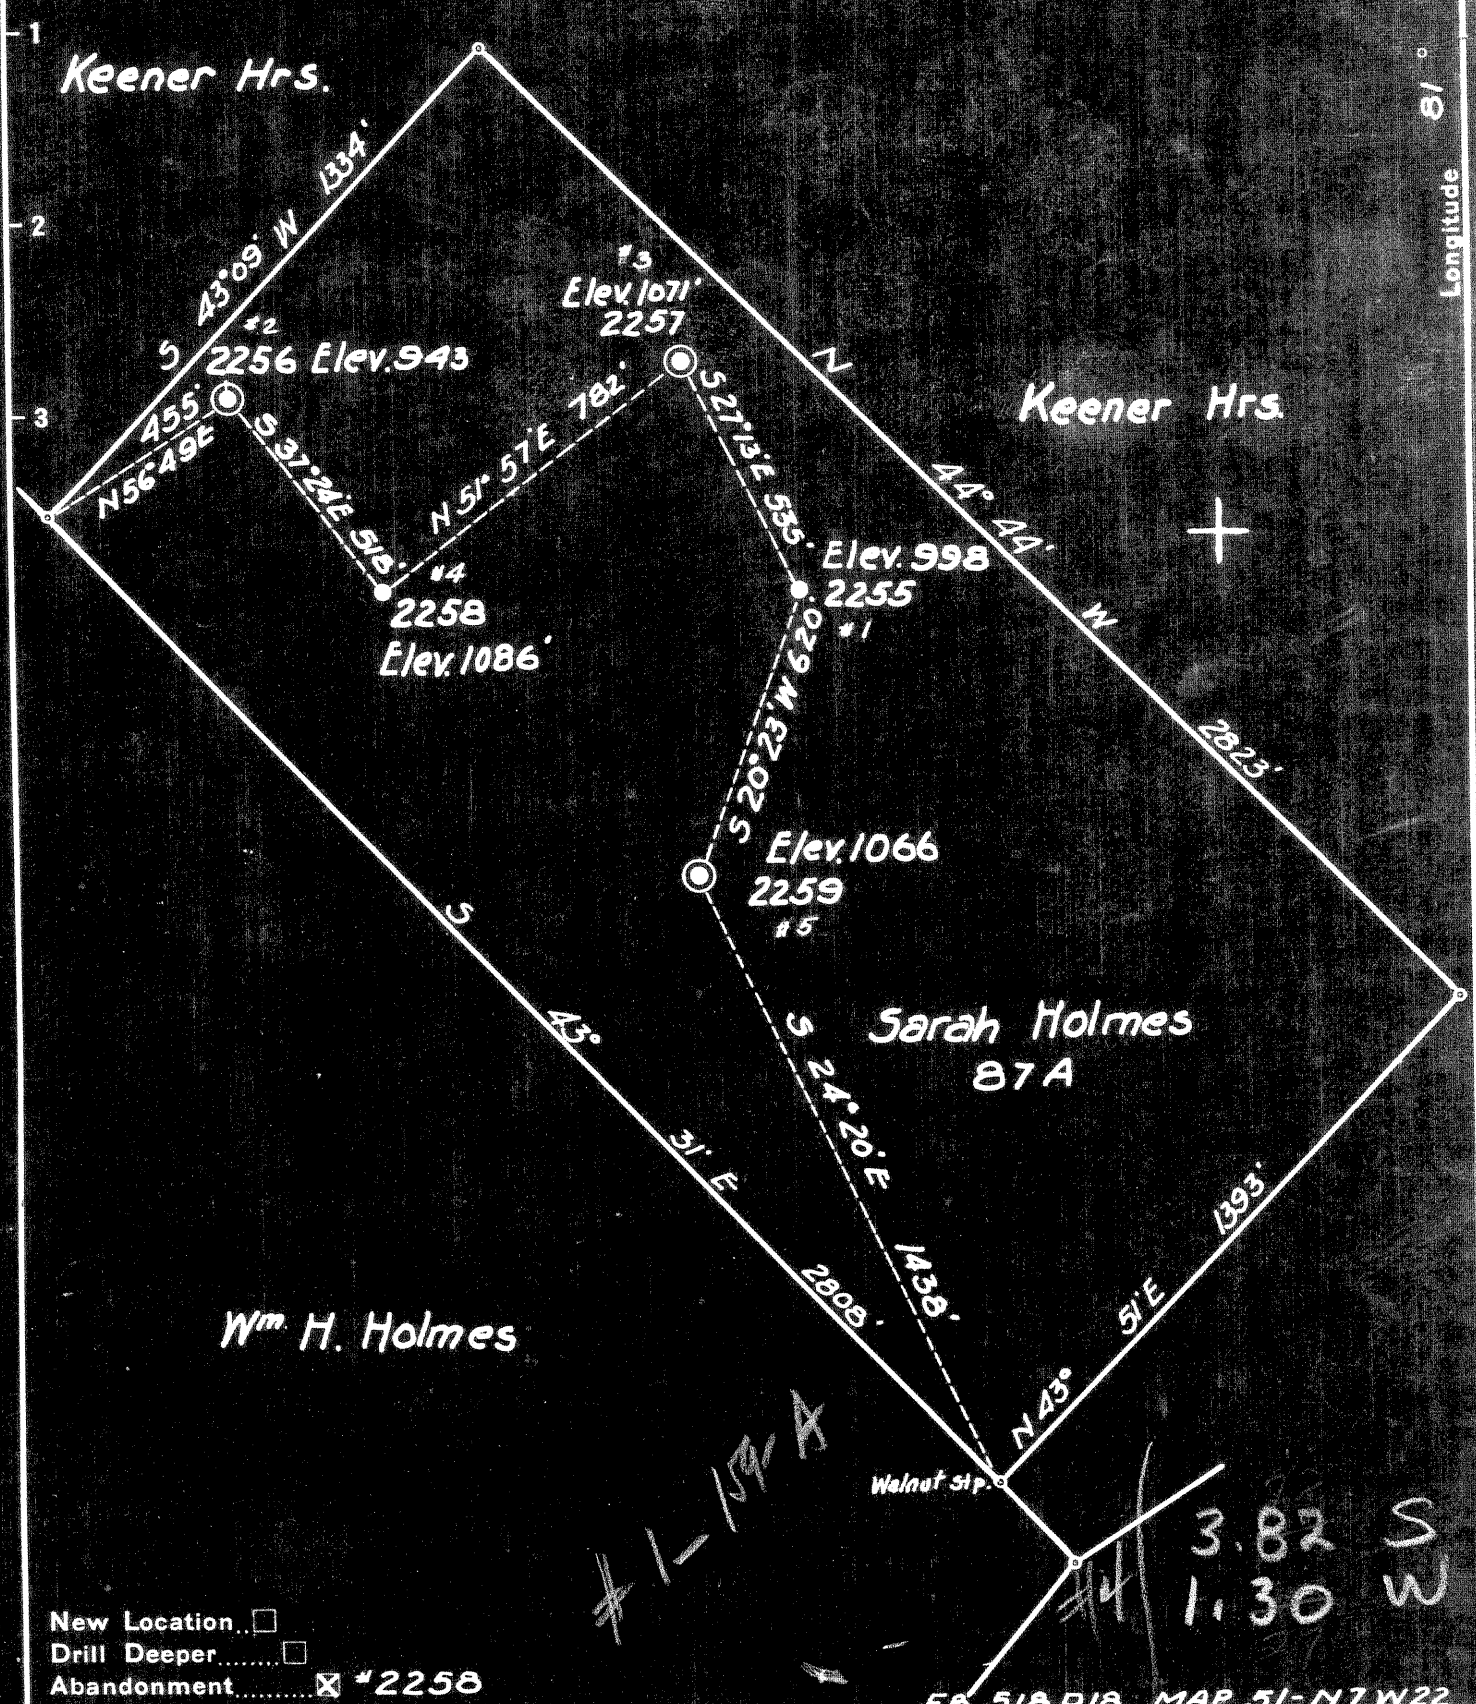

New Location
 Drill Deeper
 Abandonment #2258

4-1-156-A

*3.82 S
1.30 W*

FB. 518 D18 MAP 51-N7W22

Company HOPE CONSTR. & REF. CO.
 Address CLARKSBURG, W.VA.
 Farm SARAH HOLMES
 Tract 1 Acres 87 Lease No. 2258
 Well (Farm) No. 4-1 Serial No. 2255
 Elevation (Spirit Level) *4-EL. 1086-#1-EL 998
 Quadrangle NEW MATAMORAS
 County TYLER District UNION
 Engineer [Signature]
 Engineer's Registration No. 744
 File No. _____ Drawing No. _____
 Date JAN 14-38 Scale 1" = 400'

STATE OF WEST VIRGINIA
 DEPARTMENT OF MINES
 OIL AND GAS DIVISION
 CHARLESTON

WELL LOCATION MAP
 FILE NO. Jyl-156-A

+ Denotes location of well on United States Topographic Maps, scale 1 to 62,500, latitude and longitude lines being represented by border lines as shown.

- Denotes one inch spaces on border line of original tracing.

WEST VIRGINIA DEPARTMENT OF MINES
OIL AND GAS DIVISION

264

WELL RECORD

Permit No. TYL-156-A

Oil or Gas Well Oil
(Kind)

Company Hope Construction & Refining Company
 Address Clarksburg, W. Va.
 Farm Sarah Holmes Acres 87
 Location (waters).....
 Well No. 2258 Elev. 1086
 District Union County Tyler
 The surface of tract is owned in fee by.....
 Address.....
 Mineral rights are owned by.....
 Address.....
 Drilling commenced 8-6-1895
 Drilling completed 9-1-1895
 Date shot 5-27-1897 Depth of shot In Injun
 Open Flow /10ths Water in..... Inch
 /10ths Merc. in..... Inch
 Volume..... Cu. Ft.
 Rock Pressure..... lbs..... hrs.
 Oil..... bbls., 1st 24 hrs.
 Fresh water None recorded feet..... feet
 Salt water None recorded feet..... feet

Casing and Tubing	Used in Drilling	Left in Well	Packers
Size			
16			Kind of Packer.....
13			
10	<u>170</u>	<u>Pulled</u>	Size of.....
8 1/4	<u>1070</u>	<u>Pulled</u>	
6 5/8 <u>6 1/2"</u>	<u>1525</u>	<u>1525</u>	Depth set.....
5 3/16			
3			Perf. top.....
2	<u>1940</u>	<u>1940</u>	Perf. bottom.....
Liners Used.....			Perf. top.....
			Perf. bottom.....

CASING CEMENTED..... SIZE..... No. FT..... Date.....
Not cemented
 COAL WAS ENCOUNTERED AT 160 FEET 72 INCHES
 FEET..... INCHES..... FEET..... INCHES
 FEET..... INCHES..... FEET..... INCHES

Formation	Color	Hard or Soft	Top	Bottom	Oil Gas or Water	Depth Found	Remarks
Coal			160	166			
First Cow Run Sand			1060	1085			
First Salt Sand			1150	1300			
Big Lime			1750	1840			
Big Injun Sand			1895		<u>Oil</u>	<u>1900</u>	
Total Depth			1950				

