

Abd.

Company	The Manufacturers Light & Heat Co.
Address	Pittsburgh, Pa.
Farm	J.P.Goff
Tract	Acres 37 Lease No. 2951
Well (Farm) No.	1 Serial No. 1306
Elevation (Spirit Level)	1112'
Quadrangle	West Union
County	Tyler District McElroy
Engineer	A.C.Streator
Engineer's Registration No.	
File No.	Drawing No. Y-7-905
Date	Jan. 25, 1938 Scale 1"-500'

STATE OF WEST VIRGINIA
 Department of Mines
 OIL AND GAS DIVISION
 CHARLESTON


WELL LOCATION MAP

File No. TYL-157A

† Denotes location of well on United States Topographic Maps, scale 1 to 62,500, latitude and longitude lines being represented by border lines as shown.

- Denotes one inch spaces on border line of original tracing.

REGISTERED
 FEB 1 1908
 S. A. L. & CO.
 S. A. L. & CO.

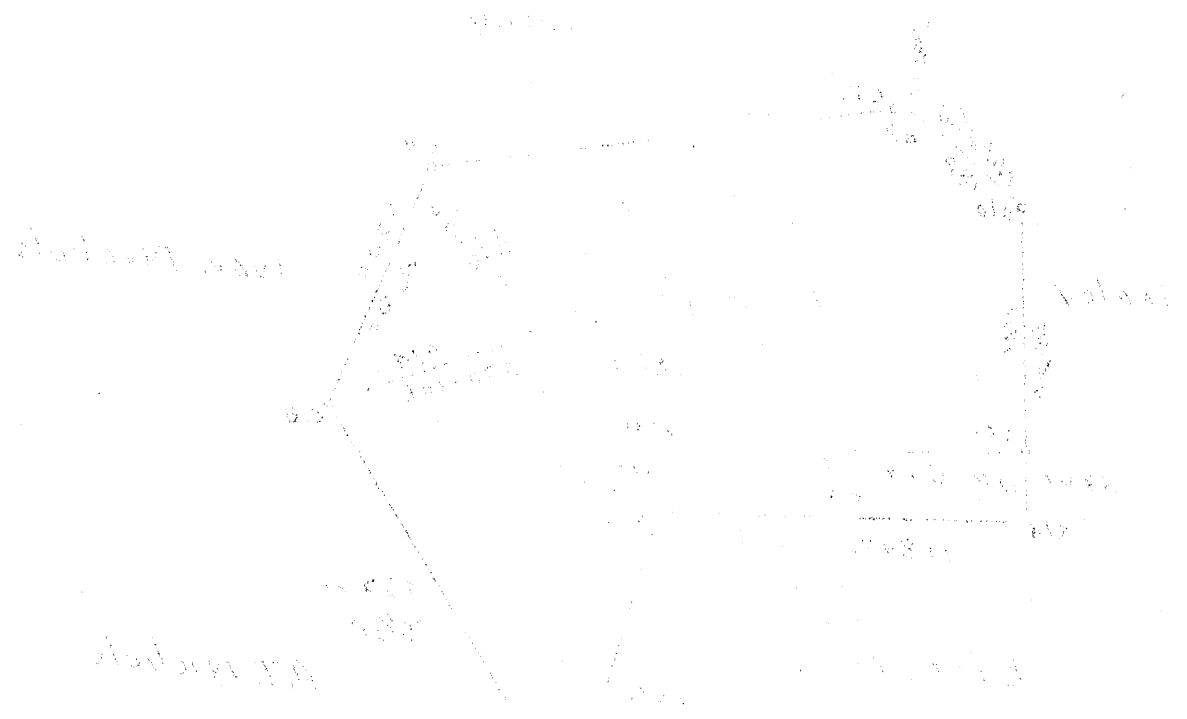

10-111-1

The following is a description of the land shown on the map above: ...
 ...
 ...
The following is a description of the land shown on the map above: ...
 ...
 ...
