

LATITUDE

39° 35'

81° 00'

15'
3.505
1.40w



LONGITUDE

7'5 OGIS topo location

7.5' loc _____

15' loc _____
(calc.) _____

Company Hope Constr. & Ref Co

Farm Keener Heirs 2261

Quad New Matamoras 15'

County Tyler


District Union

WELL LOCATION MAP

File No. 095-165A

see 155A

30165

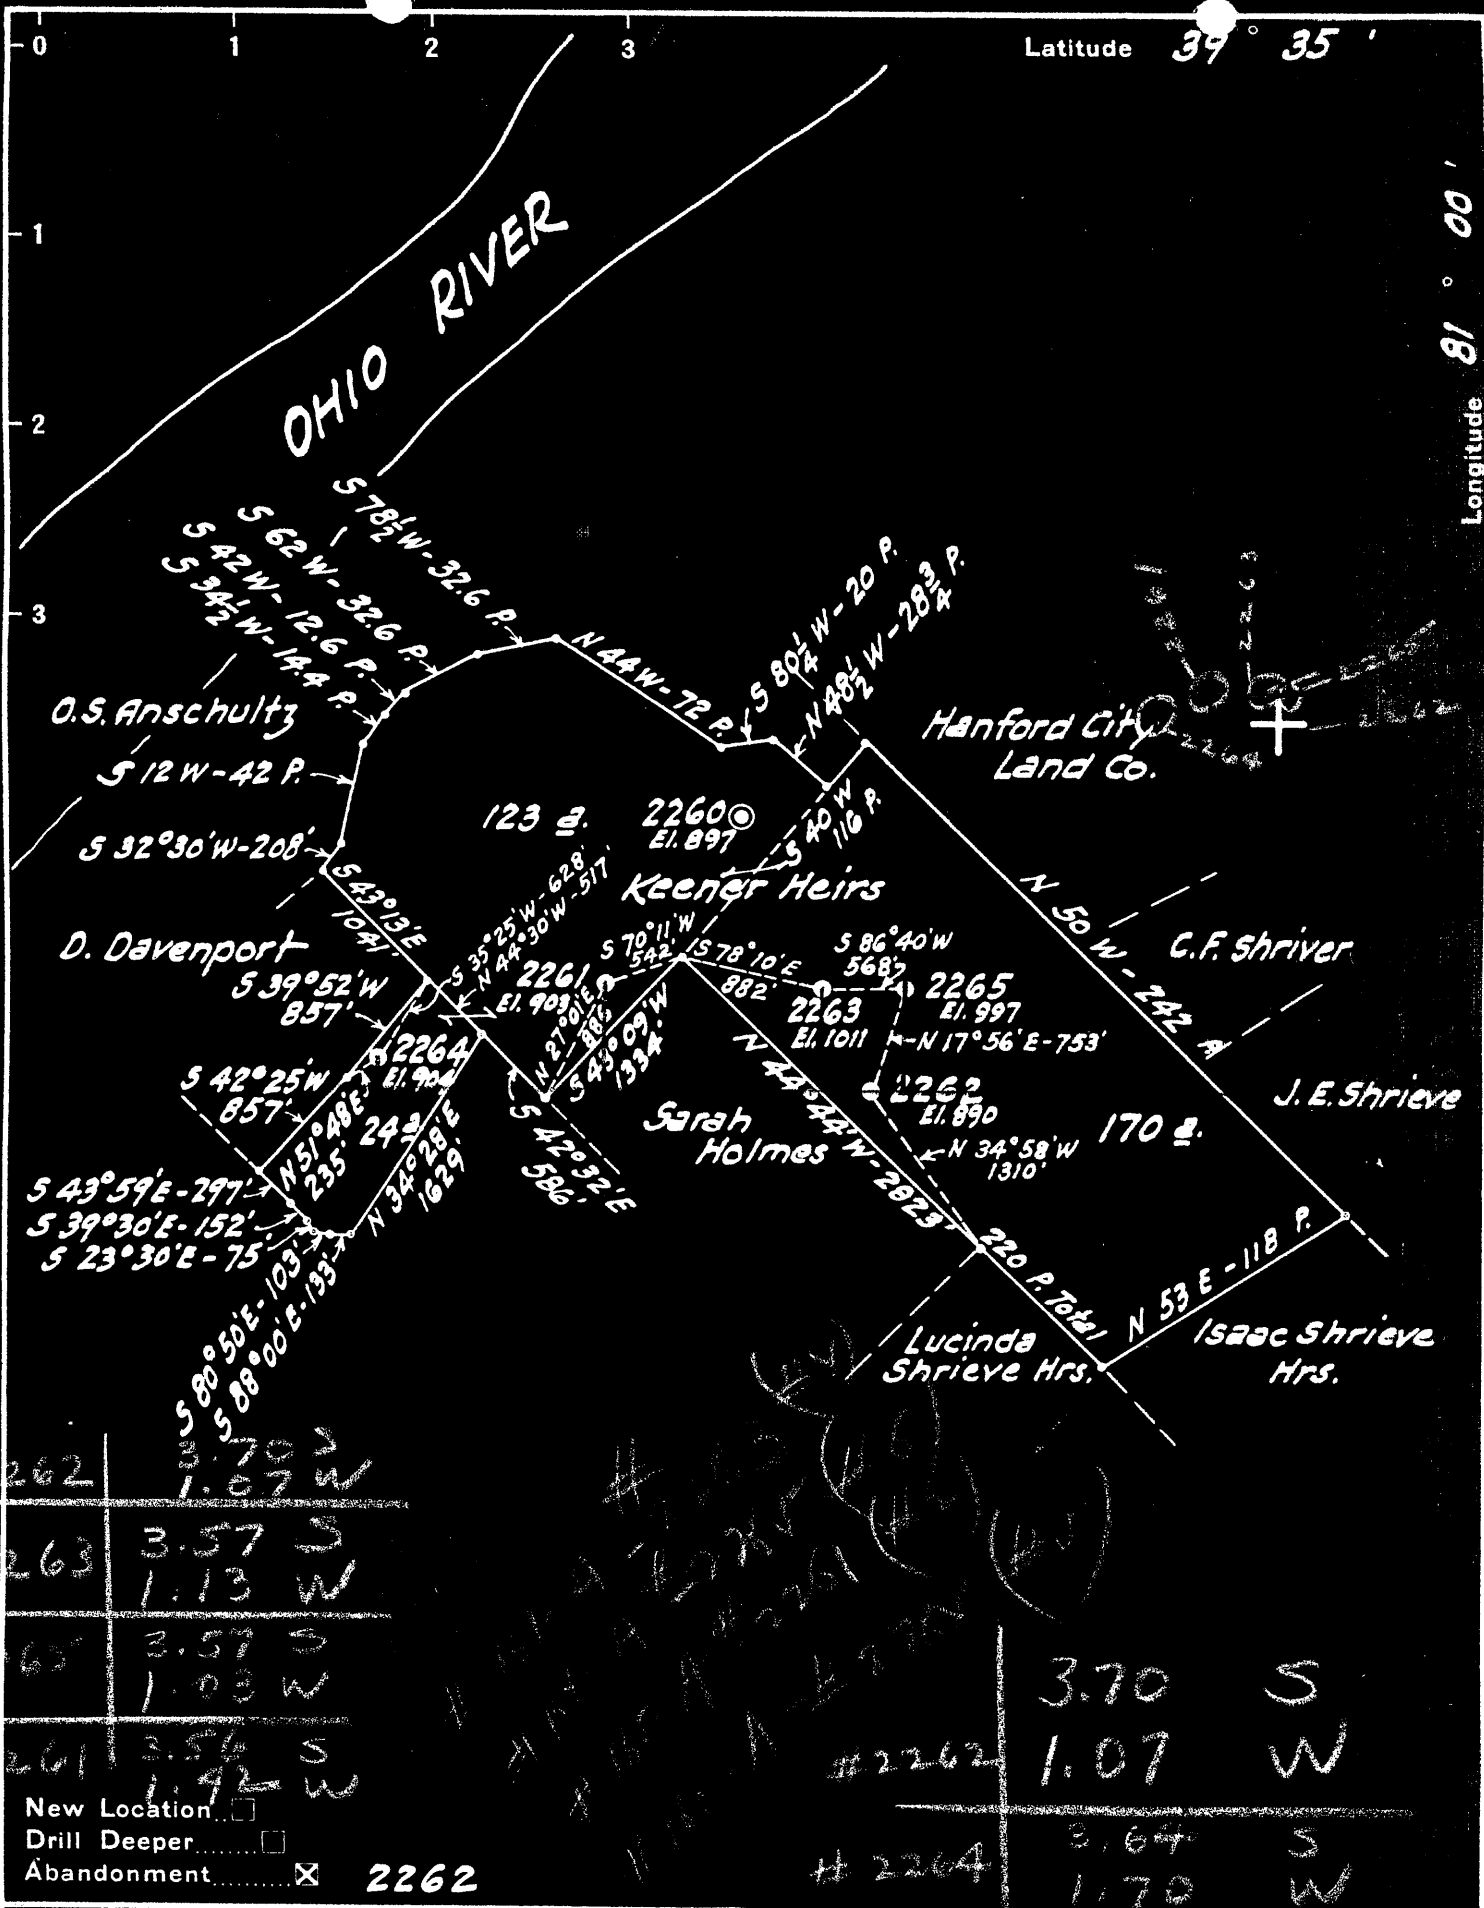

2262	3.70 S	1.07 W
2263	3.57 S	1.13 W
2264	3.57 S	1.03 W
2261	3.54 S	1.42 W

#2262	3.70 S	1.07 W
#2264	3.64 S	1.70 W

New Location
 Drill Deeper
 Abandonment 2262

Company Hope Constr. & Ref. Co.
 Address Clarksburg, W. Va.
 Farm Keener Heirs
 Tract _____ Acres 317 Lease No. _____
 Well (Farm) No. 2-3-4-5-6 Serial No. 2261-2262-2263
 Elevation (Spirit Level) See Above
 Quadrangle New Matamoras
 County Tyler District Union SE
 Engineer [Signature]
 Engineer's Registration No. 744
 File No. _____ Drawing No. _____
 Date Dec. 3, 1937 Scale: 1" = 1320'

STATE OF WEST VIRGINIA
 DEPARTMENT OF MINES
 OIL AND GAS DIVISION
 CHARLESTON

WELL LOCATION MAP
 FILE NO. Tyl-155-A

+ Denotes location of well on United States Topographic Maps, scale 1 to 62,500, latitude and longitude lines being represented by border lines as shown.

- Denotes one inch spaces on border line of original tracing.

F.B. 518 P. 17-18-19