

128
330
465
511.50

43 1/2
16 1/2
258
43 1/2
109 1/2
82 1/2
627

New Location
 Drill Deeper
 Abandonment

#2	4.11 W 4.05 0.3 Q
#3	4.0 W 3.95 0.35 Q

Company American Oil Development Company
 Address Sistersville, West Virginia
 Farm F.H. Flesher
 Tract 3 Acres 32 1/2 Lease No. _____
 Well (Farm) No. 1 * 3 Serial No. _____
 Elevation (Spirit Level) No. 1 - 872.53 No. 3 - 846.57
 Quadrangle West Union
 County Tyler District Meads
 Engineer J.S. Haught
 Engineer's Registration No. _____
 File No. _____ Drawing No. _____
 Date 3-26-40 Scale 20 rods = 1 inch

STATE OF WEST VIRGINIA
 DEPARTMENT OF MINES
 OIL AND GAS DIVISION
 CHARLESTON

WELL LOCATION MAP
 FILE NO. TYL-244A/245A

+ Denotes location of well on United States Topographic Maps, scale 1 to 62,500, latitude and longitude lines being represented by border lines as shown.

- Denotes one inch spaces on border line of original tracing.

STATE OF WEST VIRGINIA
DEPARTMENT OF MINES
OIL AND GAS DIVISION

305

WELL RECORD

Oil or Gas Well Oil Well
(Kind)


Permit No. 245-A

Company American Oil Development Co.,
Address Sistersville, West Virginia.
Farm F. H. Fleisher (Tract No. 3) acres 32 1/2
Location (waters) Sugar Creek
Well No. Three (3) Elev. 846.57
District Meade County Tyler
The surface of tract is owned in fee by C. F. Gorrell
Address Meadeville, W. Va.
Mineral rights are owned by C. F. Gorrell et al,
C. F. Gorrell Atty., Address Meadeville, W. Va.
Drilling commenced August 7th, 1896
Drilling completed August 27, 1896
Date shot August 1922 Depth of shot 1777
Open Flow /10ths Water in _____ Inch
/10ths Merc. in _____ Inch
Volume _____ Cu. Ft.
Rock Pressure _____ lbs. _____ hrs.
Oil _____ bbls., 1st 24 hrs.
Fresh water _____ feet _____ feet
Salt water _____ feet _____ feet

Casing and Tubing	Used in Drilling	Left in Well	Packers
Size			
16			Kind of Packer
13			<u>Hook Wall</u>
10	<u>155</u>		Size of
8 1/4	<u>960</u>		<u>4-7/8 x 6-1/4</u>
6 5/8 <u>1/4</u>	<u>1445</u>	<u>1445</u>	Depth set <u>1356</u>
5 3/16 <u>4-7/8</u>		<u>1356</u>	
3			Perf. top
2			Perf. bottom
Liners Used			Perf. top
			Perf. bottom

CASING CEMENTED _____ SIZE _____ No. FT. _____ Date _____
COAL WAS ENCOUNTERED AT _____ FEET _____ INCHES
_____ FEET _____ INCHES FEET _____ INCHES
_____ FEET _____ INCHES FEET _____ INCHES

Formation	Color	Hard or Soft	Top	Bottom	Oil Gas or Water	Depth Found	Remarks
<u>Cow Run</u>			<u>955</u>				
<u>Salt Sand</u>			<u>1100</u>				
<u>Limestone</u>			<u>1672</u>				
<u>Big Injun</u>			<u>1757</u>				
<u>Oil & Gas</u>			<u>1777</u>				
<u>Total Depth</u>			<u>1803</u>				

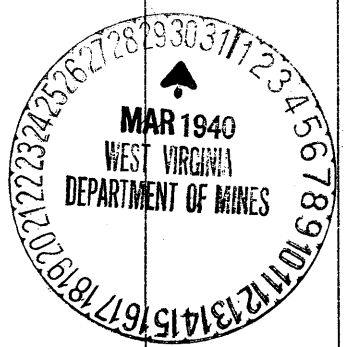

Formation	Color	Hard or Soft	Top	Bottom	Oil, Gas or Water	Depth Found	Remarks

Date **March 26th**, 19 **40**

APPROVED **American Oil Development Co.,** owner

By *Walter H. Blay*
Ass't. (Title) **Sup't.**