


Latitude 39 30

Longitude 80 55

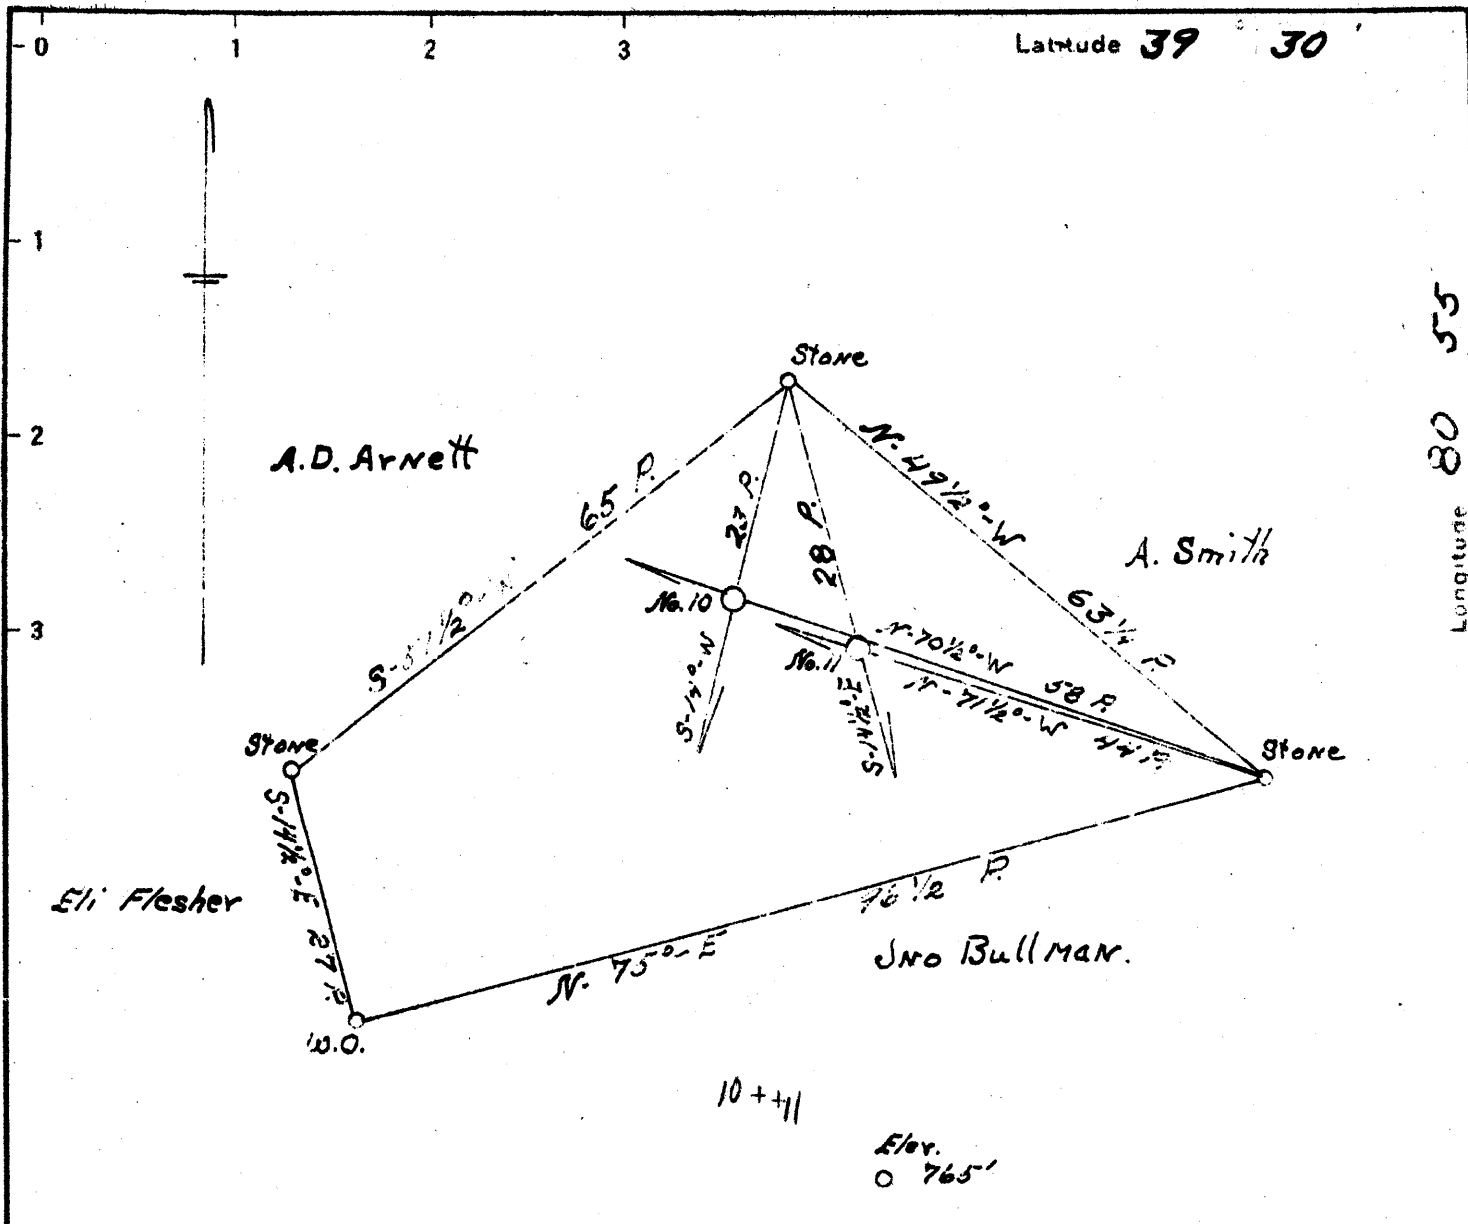

No. 10	3.72 W	3.67
	5.61 S	5.54
No. 11	3.62 W	3.55
	5.60 S	5.56

New Location
 Drill Deeper
 Abandonment

Company American Oil Development Company
 Address Sistersville West Virginia
 Farm Jno Bullman
 Tract 20.6 Acres 182 Lease No. _____
 Well (Farm) No. 10+11 Serial No. _____
 Elevation (Spirit Level) No. 10 - 1075.67
No. 11 - 1108.63
 Quadrangle West Virginia
 County Meade District Meade
 Engineer J. D. Arnett
 Engineer's Registration No. Col. 10000
 File No. _____ Drawing No. _____
 Date 5-22-40 Scale 20 P. 1"

STATE OF WEST VIRGINIA
 DEPARTMENT OF MINES
 OIL AND GAS DIVISION
 CHARLESTON

WELL LOCATION MAP
 FILE NO. TYL-246A & 247A
WELLS 10 & 11

+ Denotes location of well on United States Topographic Maps, scale 1 to 62,500, latitude and longitude lines being represented by border lines as shown.
 - Denotes one inch spaces on border line of original tracing.