


Latitude 39 30

Longitude 80 55

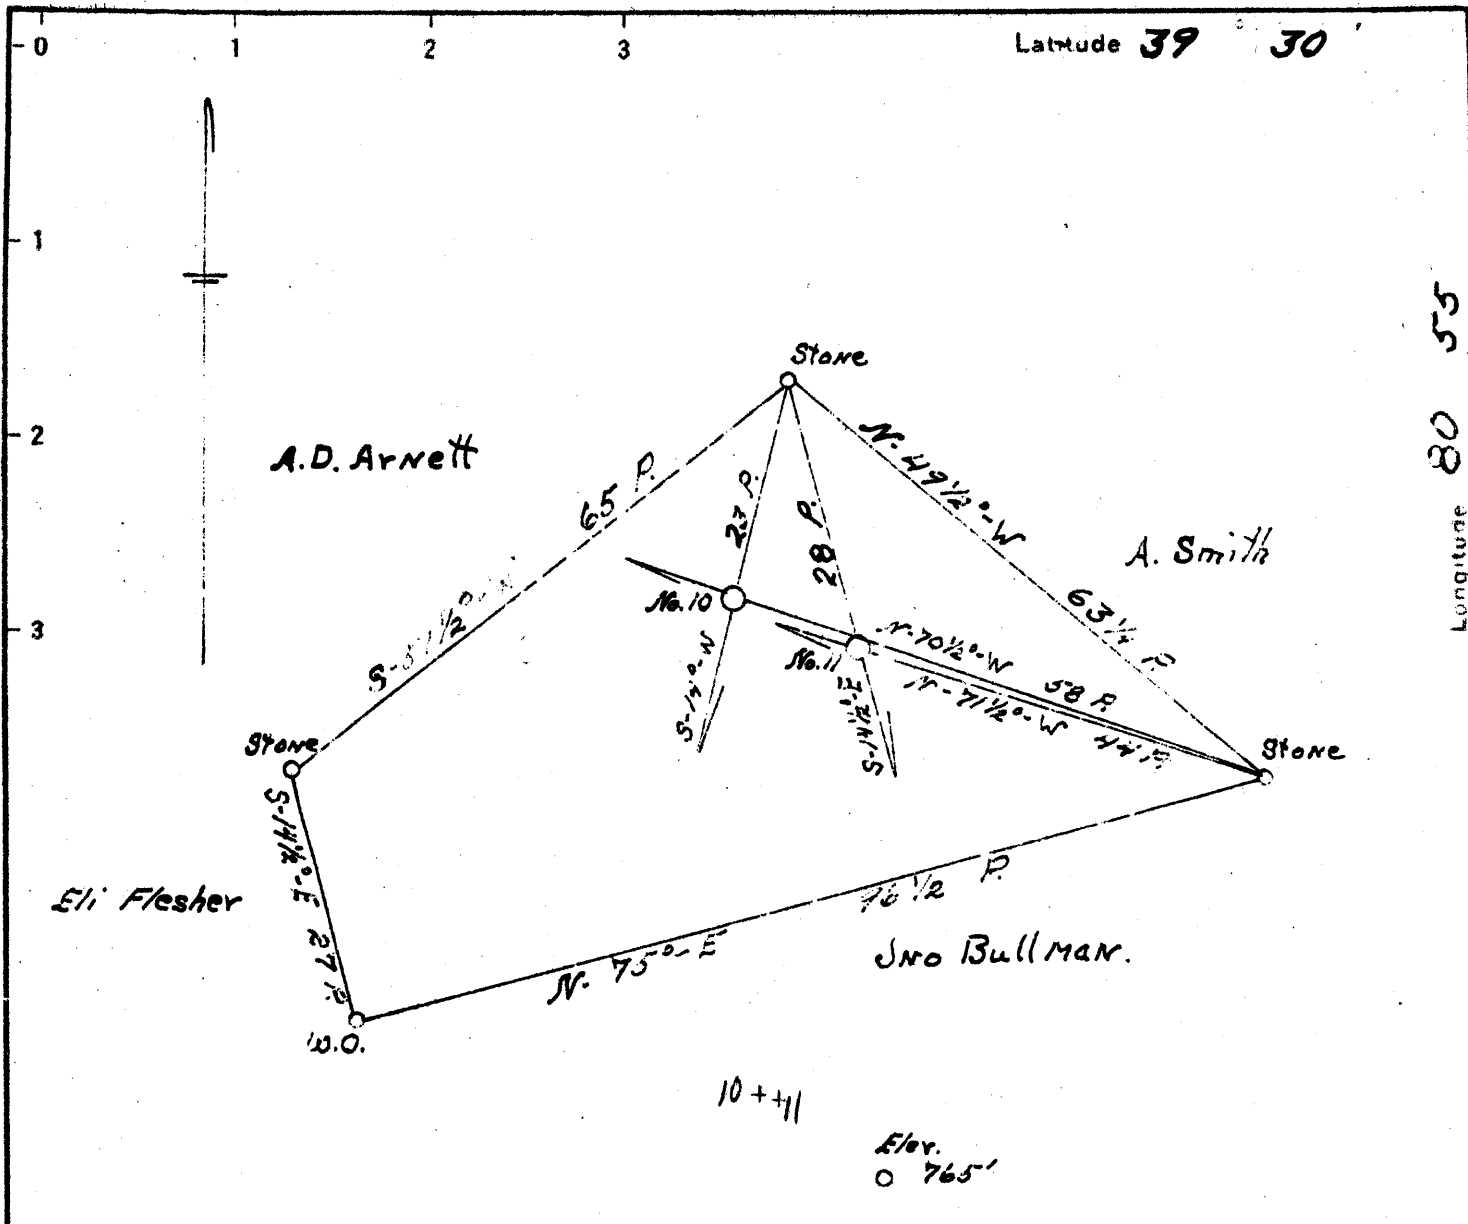

No. 10	3.72 W	3.67
	5.67 S	5.54
No. 11	3.62 W	3.55
	5.60 S	5.56

New Location

Drill Deeper

Abandonment

Company American Oil Development Company

Address Sistersville West Virginia

Farm Jno Bullman

Tract 20.6 Acres 182 Lease No. _____

Well (Farm) No. 10 + 11 Serial No. _____

Elevation (Spirit Level) No. 10 - 1075.67
No. 11 - 1158.63

Quadrangle West Virginia

County Meigs District Meade

Engineer J. D. L. L. L.

Engineer's Registration No. Col. L. L. L.

File No. _____ Drawing No. _____

Date 5-22-40 Scale 20 P. 1"

STATE OF WEST VIRGINIA
DEPARTMENT OF MINES
OIL AND GAS DIVISION
CHARLESTON

WELL LOCATION MAP
FILE NO. TYL-246A & 247A
WELLS 10 & 11

+ Denotes location of well on United States Topographic Maps, scale 1 to 62,500, latitude and longitude lines being represented by border lines as shown.

- Denotes one inch spaces on border line of original tracing.