

New Location
 Drill Deeper
 Abandonment

0.3 W 0.29
 0.03

Company HOPE NATURAL GAS CO.
 Address CLARKSBURG, W. VA.
 Farm U. G. HESLEP
 Tract Acres 83 Lease No. 45602
 Well (Farm) No. 7601 Serial No. 7601
 Elevation (Spirit Level) 886'
 Quadrangle NEW MARTINSVILLE
 County TYLER District LINCOLN
 Engineer W. W. Bowers
 Engineer's Registration No. 900
 File No. _____ Drawing No. _____
 Date AUG. 22, 1940 Scale 1" = 400'

STATE OF WEST VIRGINIA
 DEPARTMENT OF MINES
 OIL AND GAS DIVISION
 CHARLESTON

WELL LOCATION MAP
 FILE NO. TYL-257A

+ Denotes location of well on United States Topographic Maps, scale 1 to 62,500, latitude and longitude lines being represented by border lines as shown.
 - Denotes one inch spaces on border line of original tracing.

STATE OF WEST VIRGINIA
DEPARTMENT OF MINES
OIL AND GAS DIVISION

313

WELL RECORD


Oil or Gas Well **Gas**
(KIND)

Permit No. **257-A**
Company **Hope Natural Gas Company**
Address **Clarksburg, W. Va.**
Farm **U. G. Healop** Acres **85**
Location (waters) **Point Pleasant Creek**
Well No. **7601** Elev. **886**
District **Lincoln** County **Tyler**
The surface of tract is owned in fee by **U. G. Healop**
Address **Sistersville, W. Va.**
Mineral rights are owned by _____
Address _____
Drilling commenced **?**
Drilling completed **September 8, 1924**
Date shot _____ Depth of shot _____
Open Flow /10ths Water in _____ Inch
/10ths Merc. in _____ Inch
Volume _____ Cu. Ft.
Rock Pressure _____ lbs. _____ hrs.
Oil _____ bbls., 1st 24 hrs.
Fresh water **None recorded** feet _____ feet
Salt water **None recorded** feet _____ feet

| Casing and Tubing | Used in Drilling | Left in Well | Packers |
|-------------------|------------------|--------------|----------------|
| Size | | | |
| 16 | | | Kind of Packer |
| 13 | | | |
| 10 | No record | | Size of |
| 8 1/4 | No record | | |
| 6 5/8 | 1650 | 1650 | Depth set |
| 5 3/16 | | | |
| 3 | | | Perf. top |
| 2 | | | Perf. bottom |
| Liners Used | | | Perf. top |
| | | | Perf. bottom |

CASING CEMENTED _____ SIZE _____ No. Ft. _____ Date _____
Not cemented
COAL WAS ENCOUNTERED AT **525** FEET **48** INCHES
FEET _____ INCHES FEET _____ INCHES
FEET _____ INCHES FEET _____ INCHES

| Formation | Color | Hard or Soft | Top | Bottom | Oil, Gas or Water | Depth Found | Remarks |
|-----------------|-------|--------------|-------------|--------|-------------------|-------------|---------|
| Pittsburgh Coal | | | 525 | 529 | | | |
| Big Lime | | | 1645 | 1693 | | | |
| Keener Sand | | | 1693 | 1713 | Gas | 1695-1703 | |
| Big Injun Sand | | | 1713 | | Gas | 1740-1748 | |
| | | | Total Depth | 1748 | | | |

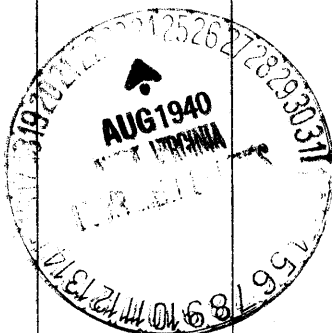

| Formation | Color | Hard or Soft | Top | Bottom | Oil, Gas or Water | Depth Found | Remarks |
|-----------|-------|--------------|-----|--------|-------------------|-------------|---------|
| | | | | | | | |

Date August 22, 1940, 194

APPROVED Hope Natural Gas Company, Owner

By *W. R. Reed* General Supt.
(Title)