


Isaac White Hrs.

Jesse White

Levi Talkington

Jesse White

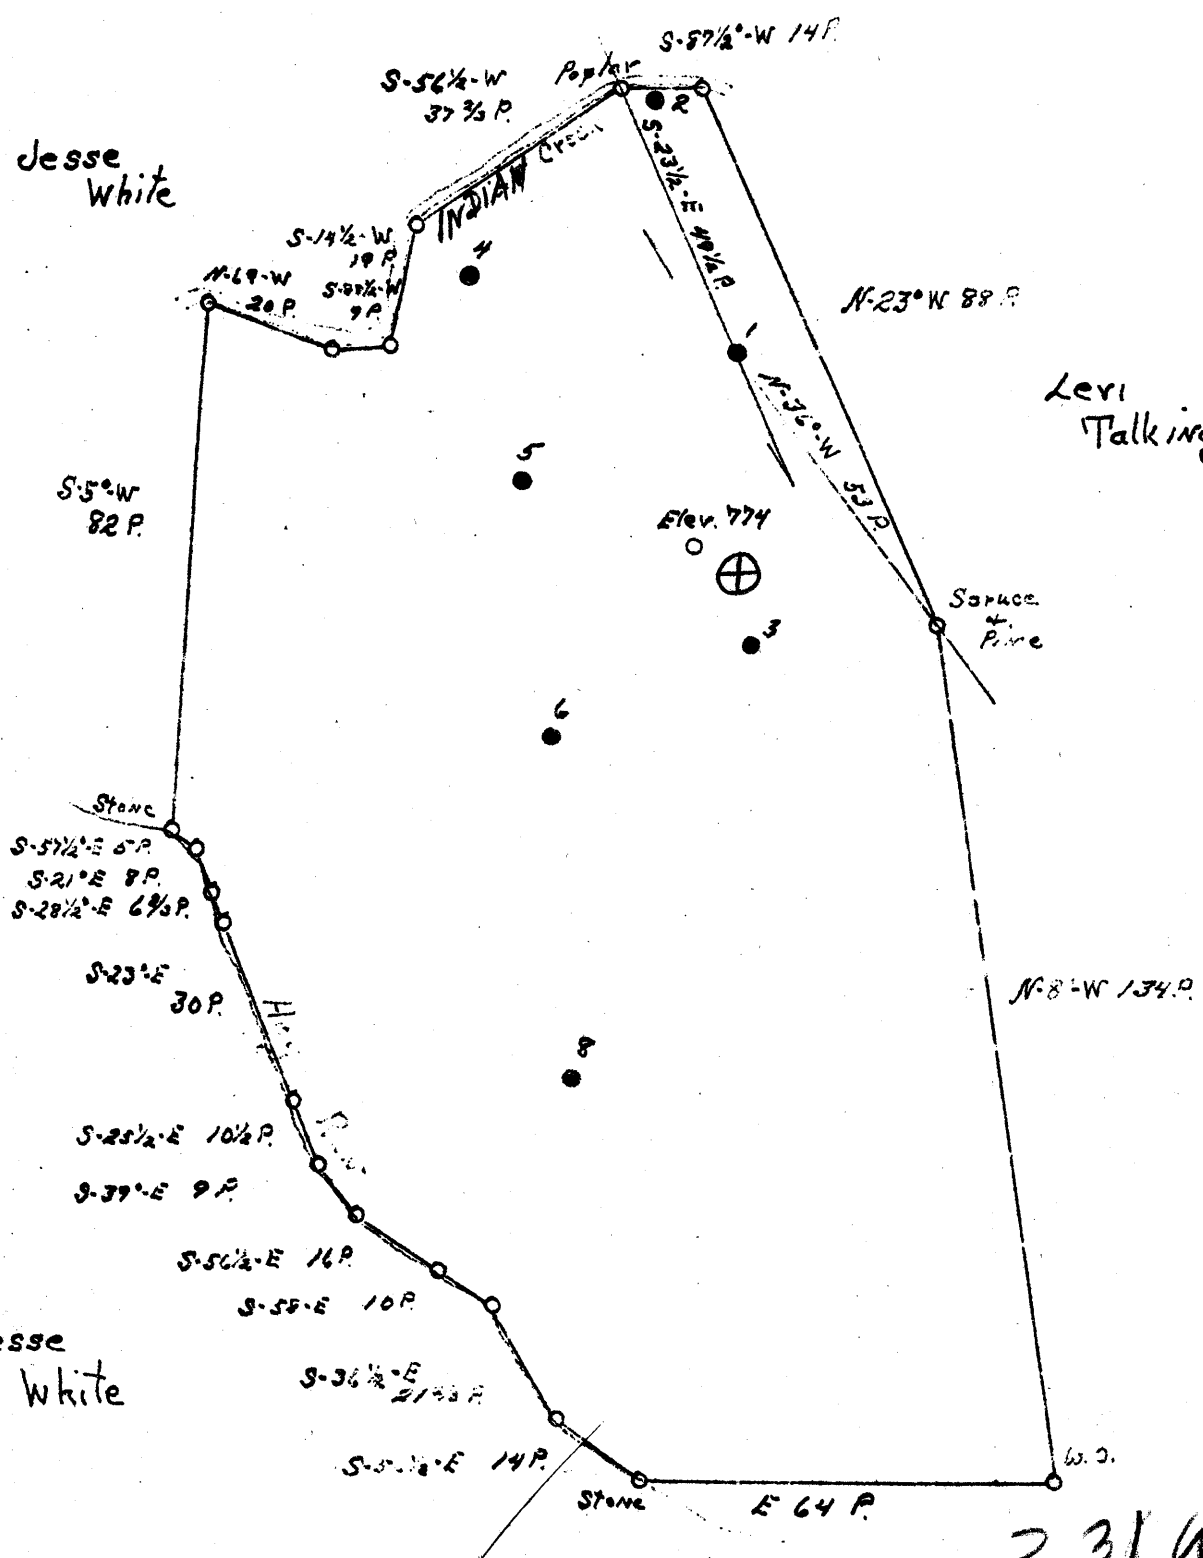

New Location.

Drill Deeper.

Abandonment. X

JUN 16 1941

3.31 W
 4.76 Q

Company American Oil Development Company

Address Sistersville West Virginia

Farm M.A. White Hrs

Tract _____ Acres 120 Lease No. _____

Well (Farm) No. Ore Serial No. _____

Elevation (Spirit Level) 884.31

Quadrangle Center point

County Tyler District McElroy

Engineer _____

Engineer's Registration No. 10000000

File No. _____ Drawing No. _____

Date 5-27-41 By: [Signature]

STATE OF WEST VIRGINIA
 DEPARTMENT OF MINES
 OIL AND GAS DIVISION
 CHARLESTON

WELL LOCATION MAP
 FILE NO. TYL-290A

+ Denotes location of well on United States Topographic Maps, scale 1 to 62,500, latitude and longitude lines being represented by border lines as shown.

- Denotes one inch spaces on border line of original tracing.

STATE OF WEST VIRGINIA
DEPARTMENT OF MINES
OIL AND GAS DIVISION

332

AB
Permit No. 290-A

WELL RECORD

Oil or Gas Well Oil Well
(Kind)

Company American Oil Development Co.,
Address Sistersville, West Virginia
Farm Wm. D. (N.A.) White Acres 120
Location (waters) Indian Creek
Well No. One Elev 894.51
District McElroy County Tyler
The surface of tract is owned in fee by Miller Wright,
Middlebourne, Mason W. Va.
Mineral rights are owned by E.B. Bond et al, E.B.
Bond, Sr Atty, Middlebourne, W. Va.
Drilling commenced.....
Drilling completed.....
Date shot Aug. 25, 1896 Depth of shot 2003
Open Flow /10ths Water in..... Inch
/10ths Merc. in..... Inch
Volume..... Cu. Ft.
Rock Pressure..... lbs..... hrs.
Oil..... bbls., 1st 24 hrs.
Fresh water..... feet..... feet
Salt water..... feet..... feet

Casing and Tubing	Used in Drilling	Left in Well	Packers
Size			
16.....			Kind of Packer.....
13.....			
10.....			Size of.....
8 1/4.....			
6 5/8.....		<u>1786</u>	Depth set.....
5 3/16.....			
3.....			Perf. top.....
2.....			Perf. bottom.....
Liners Used.....			Perf. top.....
			Perf. bottom.....

CASING CEMENTED..... SIZE..... No. FT..... Date.....
COAL WAS ENCOUNTERED AT..... FEET..... INCHES
..... FEET..... INCHES..... FEET..... INCHES
..... FEET..... INCHES..... FEET..... INCHES

Formation	Color	Hard or Soft	Top	Bottom	Oil Gas or Water	Depth Found	Remarks
Pittsburgh Coal			602				
Big Injun			1900				
					011	2005	
Total Depth						2027	
<p>Well Purchased from New York Petroleum Company, October 1st, 1934. Stated above, is the only available record of this well.</p>							

