

New Location  
 Drill Deeper  
 Abandonment  X

JUL - 5 1941

Company American Oil Development Co.  
 Address Sistersville, West Virginia  
 Farm J.W. Headley  
 Tract \_\_\_\_\_ Acres 45<sup>±</sup> Lease No. \_\_\_\_\_  
 Well (Farm) No. 2-3-4 Serial No. \_\_\_\_\_  
 Elevation (Spirit Level) 3-1133.54  
 Quadrangle Center 2-1-1  
 County Tyler District McIntosh  
 Engineer J.S. Haughton  
 Engineer's Registration No. CO Surv?  
 File No. \_\_\_\_\_ Drawing No. \_\_\_\_\_  
 Date 5-27-41 Scale 200 Feet = 1 Inch

STATE OF WEST VIRGINIA  
 DEPARTMENT OF MINES  
 OIL AND GAS DIVISION  
 CHARLESTON

WELL LOCATION MAP  
 FILE NO. TYL-291-2-3-4

+ Denotes location of well on United States Topographic Maps, scale 1 to 62,500, latitude and longitude lines being represented by border lines as shown.  
 - Denotes one inch spaces on border line of original tracing.

J.W. HEADLEY Nos. 2-3-4 - (AMERICAN OIL DEV. CO.) - TYL-291-4

STATE OF WEST VIRGINIA  
DEPARTMENT OF MINES  
OIL AND GAS DIVISION

8259

WELL RECORD

Ab 291-A  
Permit No. 291-A


Oil or Gas Well Oil Well  
(Kind)

Company American Oil Development Co.,  
Address Sistersville, West Virginia  
Farm J. W. Headley Acres 45  
Location (waters) Bonelick Run  
Well No. Two (2) Elev. 1155.95  
District McElroy County Tyler  
The surface of tract is owned in fee by B. W. Headley  
Address Lima, W. Va.  
Mineral rights are owned by B. W. Headley  
Address Lima, W. Va.  
Drilling commenced.....  
Drilling completed.....  
Date shot..... Depth of shot.....  
Open Flow /10ths Water in..... Inch  
/10ths Merc. in..... Inch  
Volume..... Cu. Ft.  
Rock Pressure..... lbs..... hrs.  
Oil..... bbls., 1st 24 hrs.  
Fresh water..... feet..... feet  
Salt water..... feet..... feet

Casing and Tubing	Used in Drilling	Left in Well	Packers
Size			
16.....			Kind of Packer.....
13.....			
10.....			Size of.....
8 1/4.....			
6 5/8.....			Depth set.....
5 3/16.....			
3.....			Perf. top.....
2.....			Perf. bottom.....
Liners Used.....			Perf. top.....
			Perf. bottom.....

CASING CEMENTED..... SIZE..... No. FT..... Date.....  
COAL WAS ENCOUNTERED AT..... FEET..... INCHES  
..... FEET..... INCHES..... FEET..... INCHES  
..... FEET..... INCHES..... FEET..... INCHES

Formation	Color	Hard or Soft	Top	Bottom	Oil Gas or Water	Depth Found	Remarks
<p>This well was purchased from New York Petroleum Company October, 1934. There is no available record for this well.</p>							

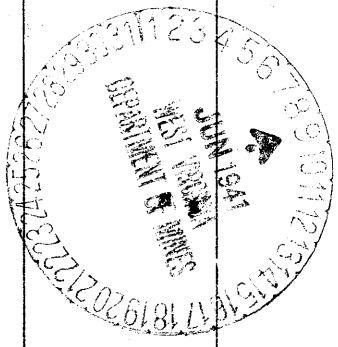

(Over)

JUL 13 1941

