

JUL -5 1941

New Location
 Drill Deeper
 Abandonment

Company American Oil Development Co.
 Address Sistersville, West Virginia
 Farm J.W. Headley
 Tract _____ Acres 45[±] Lease No. _____
 Well (Farm) No. 2-3-4 Serial No. _____
 Elevation (Spirit Level) 2-1153.5 4-10-40
3-1133.54
 Quadrangle Center 2-3-4
 County Tyler District McIntosh
 Engineer J.S. Haught
 Engineer's Registration No. CO Survey
 File No. _____ Drawing No. _____
 Date 5-27-41 Scale 60' = 1" = 1200'

STATE OF WEST VIRGINIA
 DEPARTMENT OF MINES
 OIL AND GAS DIVISION
 CHARLESTON

WELL LOCATION MAP
 FILE NO. TYL-291-2-3-4

+ Denotes location of well on United States Topographic Maps, scale 1 to 62,500, latitude and longitude lines being represented by border lines as shown.
 - Denotes one inch spaces on border line of original tracing.

STATE OF WEST VIRGINIA
DEPARTMENT OF MINES
OIL AND GAS DIVISION

331


WELL RECORD

AB
Permit No. 293-A

Oil or Gas Well Oil Well
(Kind)

Company <u>American Oil Development Co.,</u>	Casing and Tubing	Used in Drilling	Left in Well	Packers
Address <u>Sisteraville, West Virginia</u>				
Farm <u>J. W. Headley</u> Acres <u>45</u>	Size			
Location (waters) <u>Bonelick Run</u>	16.			Kind of Packer.....
Well No. <u>Four (4)</u> Elev. <u>1048.10</u>	13.			Size of.....
District <u>McElroy</u> County <u>Tyler</u>	10.			Depth set.....
The surface of tract is owned in fee by <u>B. W. Headley</u>	8 1/4			Perf. top.....
Address <u>Lima, W. Va.</u>	6 5/8			Perf. bottom.....
Mineral rights are owned by <u>B. W. Headley</u>	5 3/16			Perf. top.....
Address <u>Lima, W. Va.</u>	3.			Perf. bottom.....
Drilling commenced.....	2.			
Drilling completed.....	Liners Used.....			
Date shot..... Depth of shot.....				
Open Flow /10ths Water in..... Inch				
/10ths Merc. in..... Inch				
Volume..... Cu. Ft.	CASING CEMENTED.....	SIZE.....	No. FT.....	Date.....
Rock Pressure..... lbs..... hrs.				
Oil..... bbls., 1st 24 hrs.	COAL WAS ENCOUNTERED AT.....	FEET.....	INCHES.....	
Fresh water..... feet..... feet	FEET.....	INCHES.....	FEET.....	INCHES.....
Salt water..... feet..... feet	FEET.....	INCHES.....	FEET.....	INCHES.....

Formation	Color	Hard or Soft	Top	Bottom	Oil Gas or Water	Depth Found	Remarks
<p>This well was purchased from New York Petroleum Company, October, 1934</p> <p>There is no available record for this well.</p>							

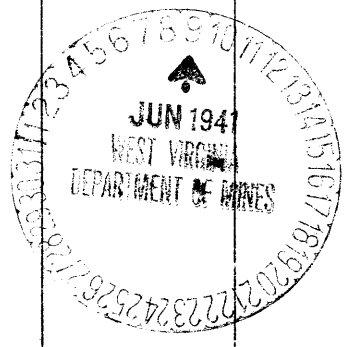

(Over)

JUL 13 1941

Formation	Color	Hard or Soft	Top	Bottom	Oil, Gas or Water	Depth Found	Remarks

Date **June 7th**, 19**41**

APPROVED **American Oil Development Company**

By *John P. King* Sup't.
(Title)