

New Location
 Drill Deeper
 Abandonment (2161)

Map Sheet 61 - Square 52 W 19 - F.B. 727 P. 23-25

Company	<u>Hope Construction & Refining Co.</u>
Address	<u>Clarksburg, W Va.</u>
Farm	<u>Charles Eberhart</u>
Tract	Acres <u>200</u> Lease No. <u>6131</u>
Well (Farm) No.	<u>1 & 5</u> Serial No. <u>2161-2162</u>
Elevation (Spirit Level)	<u>1045 - 788</u>
Quadrangle	<u>West Union</u>
County	<u>Tyler</u> District <u>Meade</u>
Engineer	<u>W.M. Bowers</u>
Engineer's Registration No.	<u>900</u>
File No.	Drawing No.
Date	<u>Oct. 30, 1942</u> Scale <u>1" = 40'</u>

STATE OF WEST VIRGINIA
 DEPARTMENT OF MINES
 OIL AND GAS DIVISION
 CHARLESTON

WELL LOCATION MAP
 FILE NO. JYL-325-A # 2161

+ Denotes location of well on United States Topographic Maps, scale 1 to 62,500, latitude and longitude lines being represented by border lines as shown.

- Denotes one inch spaces on border line of original tracing.

STATE OF WEST VIRGINIA
DEPARTMENT OF MINES
OIL AND GAS DIVISION

339

WELL RECORD

Permit No. 325-A


Oil or ~~gas~~ Well Oil
(KIND)

Company Hope Construction & Refining Company.
 Address 445 West Main St. Clarksburg, W. Va.
 Farm Chas. Eberhard Acres 200
 Location (waters).....
 Well No. 2161 Elev. 1045
 District Meade County Tyler
 The surface of tract is owned in fee by.....
 Address.....
 Mineral rights are owned by.....
 Address.....
 Drilling commenced Nov. 9, 1904
 Drilling completed Dec. 31, 1904
 Date Shot From To
 With.....
 Open Flow /10ths Water in..... Inch
 /10ths Merc. in..... Inch
 Volume..... Cu. Ft.
 Rock Pressure..... lbs..... hrs.
 Oil..... bbls., 1st 24 hrs.
 Fresh water..... feet..... feet
 Salt water 1515 feet..... feet

Casing and Tubing	Used in Drilling	Left in Well	Packers
Size			Kind of Packer
16			
13			
10	<u>465</u>	<u>Pulled</u>	Size of
8 1/4	<u>1234</u>	<u>Pulled</u>	
6	<u>1650</u>	<u>1650</u>	Depth set
5 3/16			
3			Perf. top
2	<u>2026</u>	<u>2026</u>	Perf. bottom
Liners Used			Perf. top
			Perf. bottom

Not cemented
 CASING CEMENTED..... SIZE..... No. Ft..... Date.....
 None recorded
 COAL WAS ENCOUNTERED AT..... FEET..... INCHES
 FEET..... INCHES FEET..... INCHES
 FEET..... INCHES FEET..... INCHES


Formation	Color	Hard or Soft	Top	Bottom	Oil, Gas or Water	Depth Found	Remarks
First Cow Run			295	315			
Second Cow Run			960	970			
First Salt Sand			1328	1395			
Second Salt Sand			1470	1492			
Third Salt sand			1496	1600	water	1515	
Big Lime Keener			1896	1940			
			1940	1955			
Big Injun Sand			1965	2036	oil	1996	
			Total depth	2036			

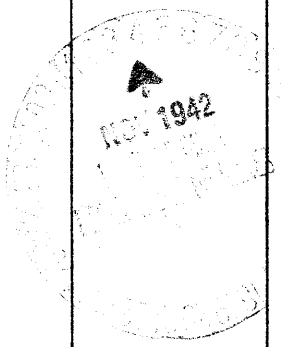

Formation	Color	Hard or Soft	Top	Bottom	Oil, Gas or Water	Depth Found	Remarks

Date November 2, 1942, 194

APPROVED Hope Construction & Refining Company, Owner

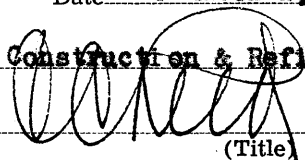By  Gen. Sup't.
 (Title)

305A

Meade District, Tyler County, W. Va.
 By Hope Construction & Refining Co., 445 W. Main St., Clarksburg, W. Va.
 Abandoned under permit Tyl-.....-A?

On 200 acres.

Elevation, 1045' L.

Drilling commenced Nov. 9, 1904; completed, Dec. 31, 1904.

Salt water at 1515'.

10" casing, 465' (pulled); 8 $\frac{1}{4}$ " , 1234' (pulled); 6 $\frac{3}{8}$ " , 1650';
 2" tubing, 2026'.

Casing not cemented.

No coal recorded.

Oil well. Abandonment reported to Dept. of Mines Nov. 2, 1942.

Record to RCT from Mrs. Griffith Dec. 19, 1942.

	Top.	Bottom.
First Cow Run Sand	295	- 315
Second Cow Run Sand	960	- 970
First Salt Sand	1328	- 1395
Second Salt Sand	1470	- 1492
Third Salt Sand (water, 1515')	1496	- 1600
Big Lime	1896	- 1940
Keener Sand	1940	- 1955
Big Injun Sand (oil, 1996')	1965	- 2036
Total depth		2036