


Latitude 39° 35'

Longitude 80° 50'

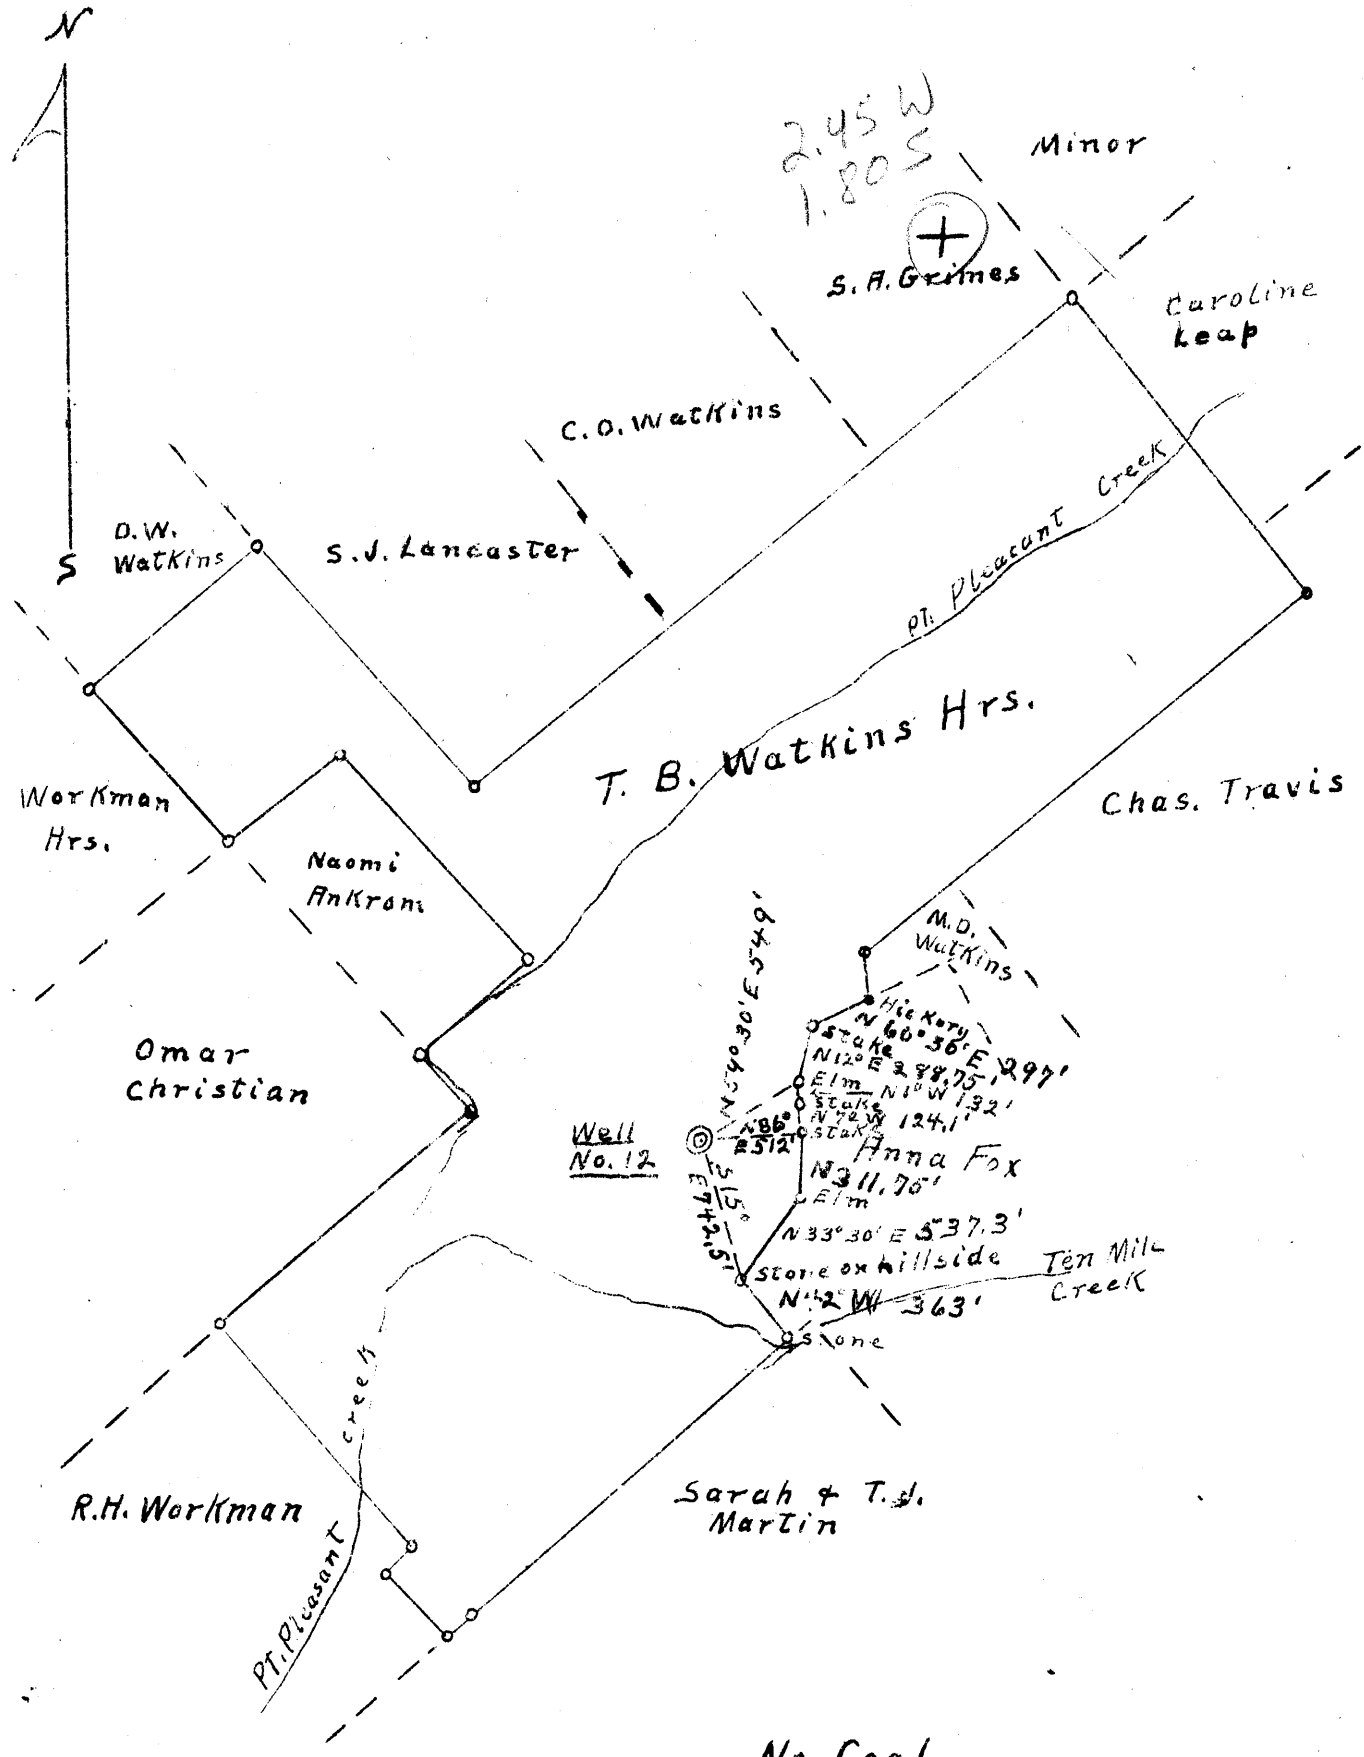

Abandonment

No Coal

Company Pittsburgh Oil & Gas Co.
871 Oliver Bldg. Pittsburgh, Pa.
 Farm T.B. Watkins Hrs.
 Tract 1 Acres 337 Lease No. _____
 Well (Farm) No. 12 Serial No. _____
 Elevation (Spirit Level) 974.2'
 Quadrangle New Martinsville
 County Tyler District Ellsworth
 Engineer Don F. Ruggle
 Engineer's Registration No. _____
 File No. A-P Drawing No. 817
 Date 9-21-43 Scale 1" = 990'

STATE OF WEST VIRGINIA
 DEPARTMENT OF MINES
 OIL AND GAS DIVISION
 CHARLESTON

WELL LOCATION MAP
 FILE NO. JYL-356 A

+ Denotes location of well on United States Topographic Maps, scale 1 to 62,500, latitude and longitude lines being represented by border lines as shown.

- Denotes one inch spaces on border line of original tracing.