

WELL OWNED BY: PERMELIA C. HENDERSON

DEED LOCATION

DEED DEEPER

ABANDONMENT

✓ JUN 27 1944

1.23 W  
5.425

COMPANY: THE MANUFACTURERS LIGHT AND HEAT CO.  
 ADDRESS: 800 UNION TRUST BLD'G. PITTSBURGH PA.  
 NAME: J.M. MAYFIELD NOW R.C. HENDERSON  
 TRACT: ACRES 120+ LEASE NO. 2927  
 WELL (FARM) NO. 1 SERIAL NO. 1319  
 ELEVATION (SPIRIT LEVEL) 955'  
 QUADRANGLE: NEW MARTINSVILLE  
 COUNTY: TYLER DISTRICT: ELLSWORTH  
 ENGINEER: *J. L. Mercer*  
 ENGINEER'S REGISTRATION NO.  
 FILE NO. P-24-30 DRAWING NO. Y-11-39  
 DATE: JUNE 14 1944 SCALE: 1" = 800'

SF

STATE OF WEST VIRGINIA  
 DEPARTMENT OF MINES  
 OIL AND GAS DIVISION  
 CHARLESTON

WELL LOCATION MAP

FILE NO. Ty1-371-A

+ DENOTES LOCATION OF WELL ON UNITED STATES TOPOGRAPHIC MAPS. SCALE 1" TO 62,500'. LATITUDE AND LONGITUDE LINES BEING REPRESENTED BY BORDER LINES AS SHOWN.

- DENOTES ONE INCH SPACES ON BORDER LINE OF ORIGINAL TRACING.

J.M. MAYFIELD (NOW R.C. HENDERSON) No. 1 (1319) - M.L. & H. CO. - TYL-371-A



361

STATE OF WEST VIRGINIA  
DEPARTMENT OF MINES  
OIL AND GAS DIVISION

WELL RECORD

Permit No. 371-A Drilled in 1905


Oil or Gas Well Gas  
(KIND)

Company.....The Manufacturers Light & Heat Company  
Address.....800 Union Trust Bldg., Pittsburgh, Pa.  
Farm.....J. M. Mayfield Acres.....125  
Location (waters).....  
Well No.....1 - 1319 Elev.....955 ft.  
District.....Ellsworth County.....Tyler  
The surface of tract is owned in fee by.....J. C. Mayfield  
.....Bena Run Address.....N. Va.  
Mineral rights are owned by.....The Mfrs Light & Heat Co.  
.....800 Union Trust Bldg., Address Pittsburgh, Pa.  
Drilling commenced.....?.....1905  
Drilling completed.....May 23,.....1905  
Date Shot.....5/25/05 From.....? To.....?  
With.....20 qts.....?  
Open Flow...../10ths Water in.....? Inch  
...../10ths Merc. in.....? Inch  
Volume.....? Cu. Ft.  
Rock Pressure.....? lbs.....? hrs.  
Oil.....? bbls., 1st 24 hrs.  
Fresh water.....? feet.....? feet  
Salt water.....? feet.....? feet

Casing and Tubing	Used in Drilling	Left in Well	Packers
Size			
16			Kind of Packer.....
18			
10	<u>167</u>		Size of.....
<u>6 5/8</u>	<u>1830</u>	<u>1830</u>	
<u>8 1/4</u>	<u>1080</u>		Depth set.....
<u>5 3/16</u>	<u>2030</u>	<u>2030</u>	
3			Perf. top.....
2			Perf. bottom.....
Liners Used.....			Perf. top.....
			Perf. bottom.....

CASING CEMENTED.....SIZE.....No. Ft.....Date.....  
COAL WAS ENCOUNTERED AT 600 FEET ? INCHES  
.....FEET.....INCHES.....FEET.....INCHES  
.....FEET.....INCHES.....FEET.....INCHES

Formation	Color	Hard or Soft	Top	Bottom	Oil, Gas or Water	Depth Found	Remarks
Pittsburgh Coal			600				
Little Dunkard			970	1010			
Big Dunkard			1040	1080			
Gas Sand			1290	1335			
Salt Sand			1400	1687			
Maxon Sand			1742	1762			
Blue Monday			1792	1815			
Big Lime			1815	1867			
Big Injun			1867	2044			
50-Foot			2420	2470			
Gordon			2670	2699			
Pay					2676		
Total depth				2699			

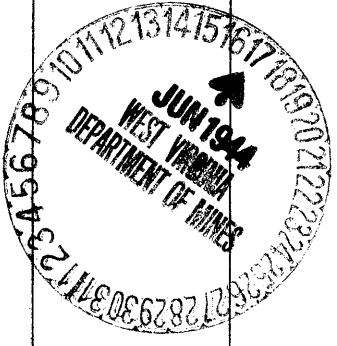

Formation	Color	Hard or Soft	Top	Bottom	Oil, Gas or Water	Depth Found	Remarks

Date June 15th, 1944

APPROVED THE MANUFACTURERS LIGHT & HEAT CO., Owner

By Jam. H. Fowler  
 Land Dept. (Title) Office Manager

Ellsworth District, Tyler County, W. Va.

Manufacturers Light & Heat Co.

Elevation, 938'.

6-5/8" casing, 1864'.

On Elk Fork (Conaway).

Shown on 9-I, New Martinsville Quadrangle.

NO RECORD.