

COAL OWNED BY Thomas Kingsley

NEW LOCATION

DRILL DEEPER

ABANDONMENT

✓ DEC 21 1945

2.9 W  
5.57 S

COMPANY The Manufacturers Light & Heat Co.  
 ADDRESS 800 Union Trust Bldg Pittsburgh Pa.  
 (K.S. Boreman Est.) Thomas Kingsley  
 TRACT ACRES 227 LEASE NO. 34 31  
 WELL (FARM) NO. 2 SERIAL NO. 2025  
 ELEVATION (SPIRIT LEVEL) 1095'  
 QUAD ANGLE New Martinsville  
 COUNTY Tyler DISTRICT Ellsworth  
 ENGINEER J. L. Mercer  
 ENGINEER'S REGISTRATION NO.  
 FILE NO. DRAWING NO. Y-11-204  
 DATE December 10-1945 SCALE 1" = 660'

STATE OF WEST VIRGINIA  
 DEPARTMENT OF MINES  
 OIL AND GAS DIVISION  
 CHARLESTON

WELL LOCATION MAP  
 FILE NO. TYL-387-A

— DENOTES LOCATION OF WELL ON UNITED STATES TOPOGRAPHIC MAPS. SCALE 1 TO 62,500. LATITUDE AND LONGITUDE LINES BEING REPRESENTED BY BORDER LINES AS SHOWN

— DENOTES ONE INCH SPACES ON BORDER LINES OF ORIGINAL TRACING.

94

(K.S. BOREMAN) (O & G)  
 THOMAS KINGSLEY (surface) No. 2 (2025) - M.L. & H. Co. - TYL-387-A



377

STATE OF WEST VIRGINIA  
DEPARTMENT OF MINES  
OIL AND GAS DIVISION

WELL RECORD

Permit No. Drilled in 1917

Oil or Gas Well Gas  
(KIND)

Company The Manufacturers Light & Heat Company  
Address 800 Union Trust Bldg., Pittsburgh, Pa.  
Farm K. S. Borsman Acres 287  
Location (waters) \_\_\_\_\_  
Well No. 2-2025 Elev. 1095 ft.  
District Ellsworth County Tyler  
The surface of tract is owned in fee by John W. Kerns  
Bridgeport Address W. Va.  
Mineral rights are owned by The Mfrs Light & Heat Co.  
Address Pittsburgh, Pa.

Drilling commenced 1/2/17  
Drilling completed 1/31/17  
Date Shot \_\_\_\_\_ From \_\_\_\_\_ To \_\_\_\_\_  
With \_\_\_\_\_


Open Flow /10ths Water in \_\_\_\_\_ Inch  
/10ths Merc. in \_\_\_\_\_ Inch  
Volume \_\_\_\_\_ Cu. Ft.  
Rock Pressure \_\_\_\_\_ lbs. \_\_\_\_\_ hrs.  
Oil \_\_\_\_\_ bbls., 1st 24 hrs.  
Fresh water 1465 feet 1870 feet  
Salt water \_\_\_\_\_ feet \_\_\_\_\_ feet

Casing and Tubing	Used in Drilling	Left in Well	Packers
Size			
16.			Kind of Packer
13.			
10.	107' 6"	107' 6"	Size of
8 3/4	1126'	1126'	
6 3/4	2111'	2111'	Depth set
5 3/16			
3.			Perf. top
2.			Perf. bottom
Liners Used			Perf. top
			Perf. bottom

CASING CEMENTED \_\_\_\_\_ SIZE \_\_\_\_\_ No. Ft. \_\_\_\_\_ Date \_\_\_\_\_

COAL WAS ENCOUNTERED AT 865 FEET 24 INCHES  
\_\_\_\_\_ FEET \_\_\_\_\_ INCHES \_\_\_\_\_ FEET \_\_\_\_\_ INCHES  
\_\_\_\_\_ FEET \_\_\_\_\_ INCHES \_\_\_\_\_ FEET \_\_\_\_\_ INCHES

Formation	Color	Hard or Soft	Top	Bottom	Oil, Gas or Water	Depth Found	Remarks
Red Rock			0	15			
Slate			15	27			
Sand			27	38			
Red Rock			38	56			
Sand			56	85			
Slate			85	110			
Sand			110	150			
Red Rock			150	178			
Slate & Lime			178	345			
Sand			345	366			
Slate & Lime			366	506	Native Coal	431-433	
Sand			506	530			
Slate			530	560			
Red Rock			560	580			
Slate & Lime			580	936	Pgh Coal	865-867	
Sand			936	964			
Slate & Lime			964	1083			
Red Rock			1083	1093			
Slate			1093	1173			
Red Rock			1173	1185			
Lime & Slate			1185	1212			
Sand			1212	1242			
Slate & Lime			1242	1297			
Little Dunkard			1297	1327			
Slate			1327	1337			
Sand			1337	1349			
Slate			1349	1400			
Big Dunkard			1400	1483			
Slate			1483	1520			
Gas Sand			1520	1677			
Slate			1677	1722			
1st Salt Sand			1722	1856			
Lime			1856	1865			
2nd Salt Sand			1865	1918			
Slate			1918	1983			
Maxon Sand			1983	2036			
Slate			2036	2040			
Little Lime			2040	2055			

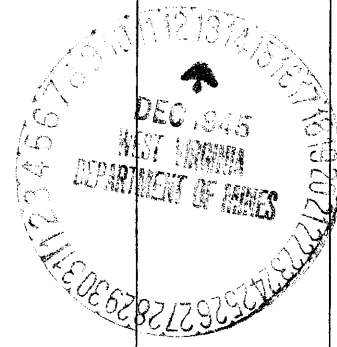

Formation	Color	Hard or Soft	Top	Bottom	Oil, Gas or Water	Depth Found	Remarks
Pencil Cave			2055	2063			
Big Lime			2063	2133			
Big Injun Sand			2133				
Gas			2133	2161			
Total depth				2171			

Date December 11th, 194 5

APPROVED THE MANUFACTURERS LIGHT & HEAT COMPANY, Owner

By Sam H. Fowler  
Land Dept. (Title) Office Manager.